

# MAP OF SURVEY AND LOT SPLIT

PREPARED FOR


VIRGINIA BUCHS

SITUATED IN THE TOWNSHIP OF HENRIETTA, COUNTY OF LORAIN, STATE OF OHIO  
AND BEING KNOWN AS PART OF ORIGINAL HENRIETTA TOWNSHIP LOT 13, TRACT 12 AND  
BEING FURTHER KNOWN AS PART OF THOSE LANDS DEEDED TO VIRGINIA BUCHS IN DEED  
INSTRUMENT #2002-0868846 OF LORAIN COUNTY DEED RECORDS.

CORE ORPHANGE ROAD

BECKER ROAD 60'


BOAT SPIKE  
INSIDE 3/4" PIPE  
FOUND & USED

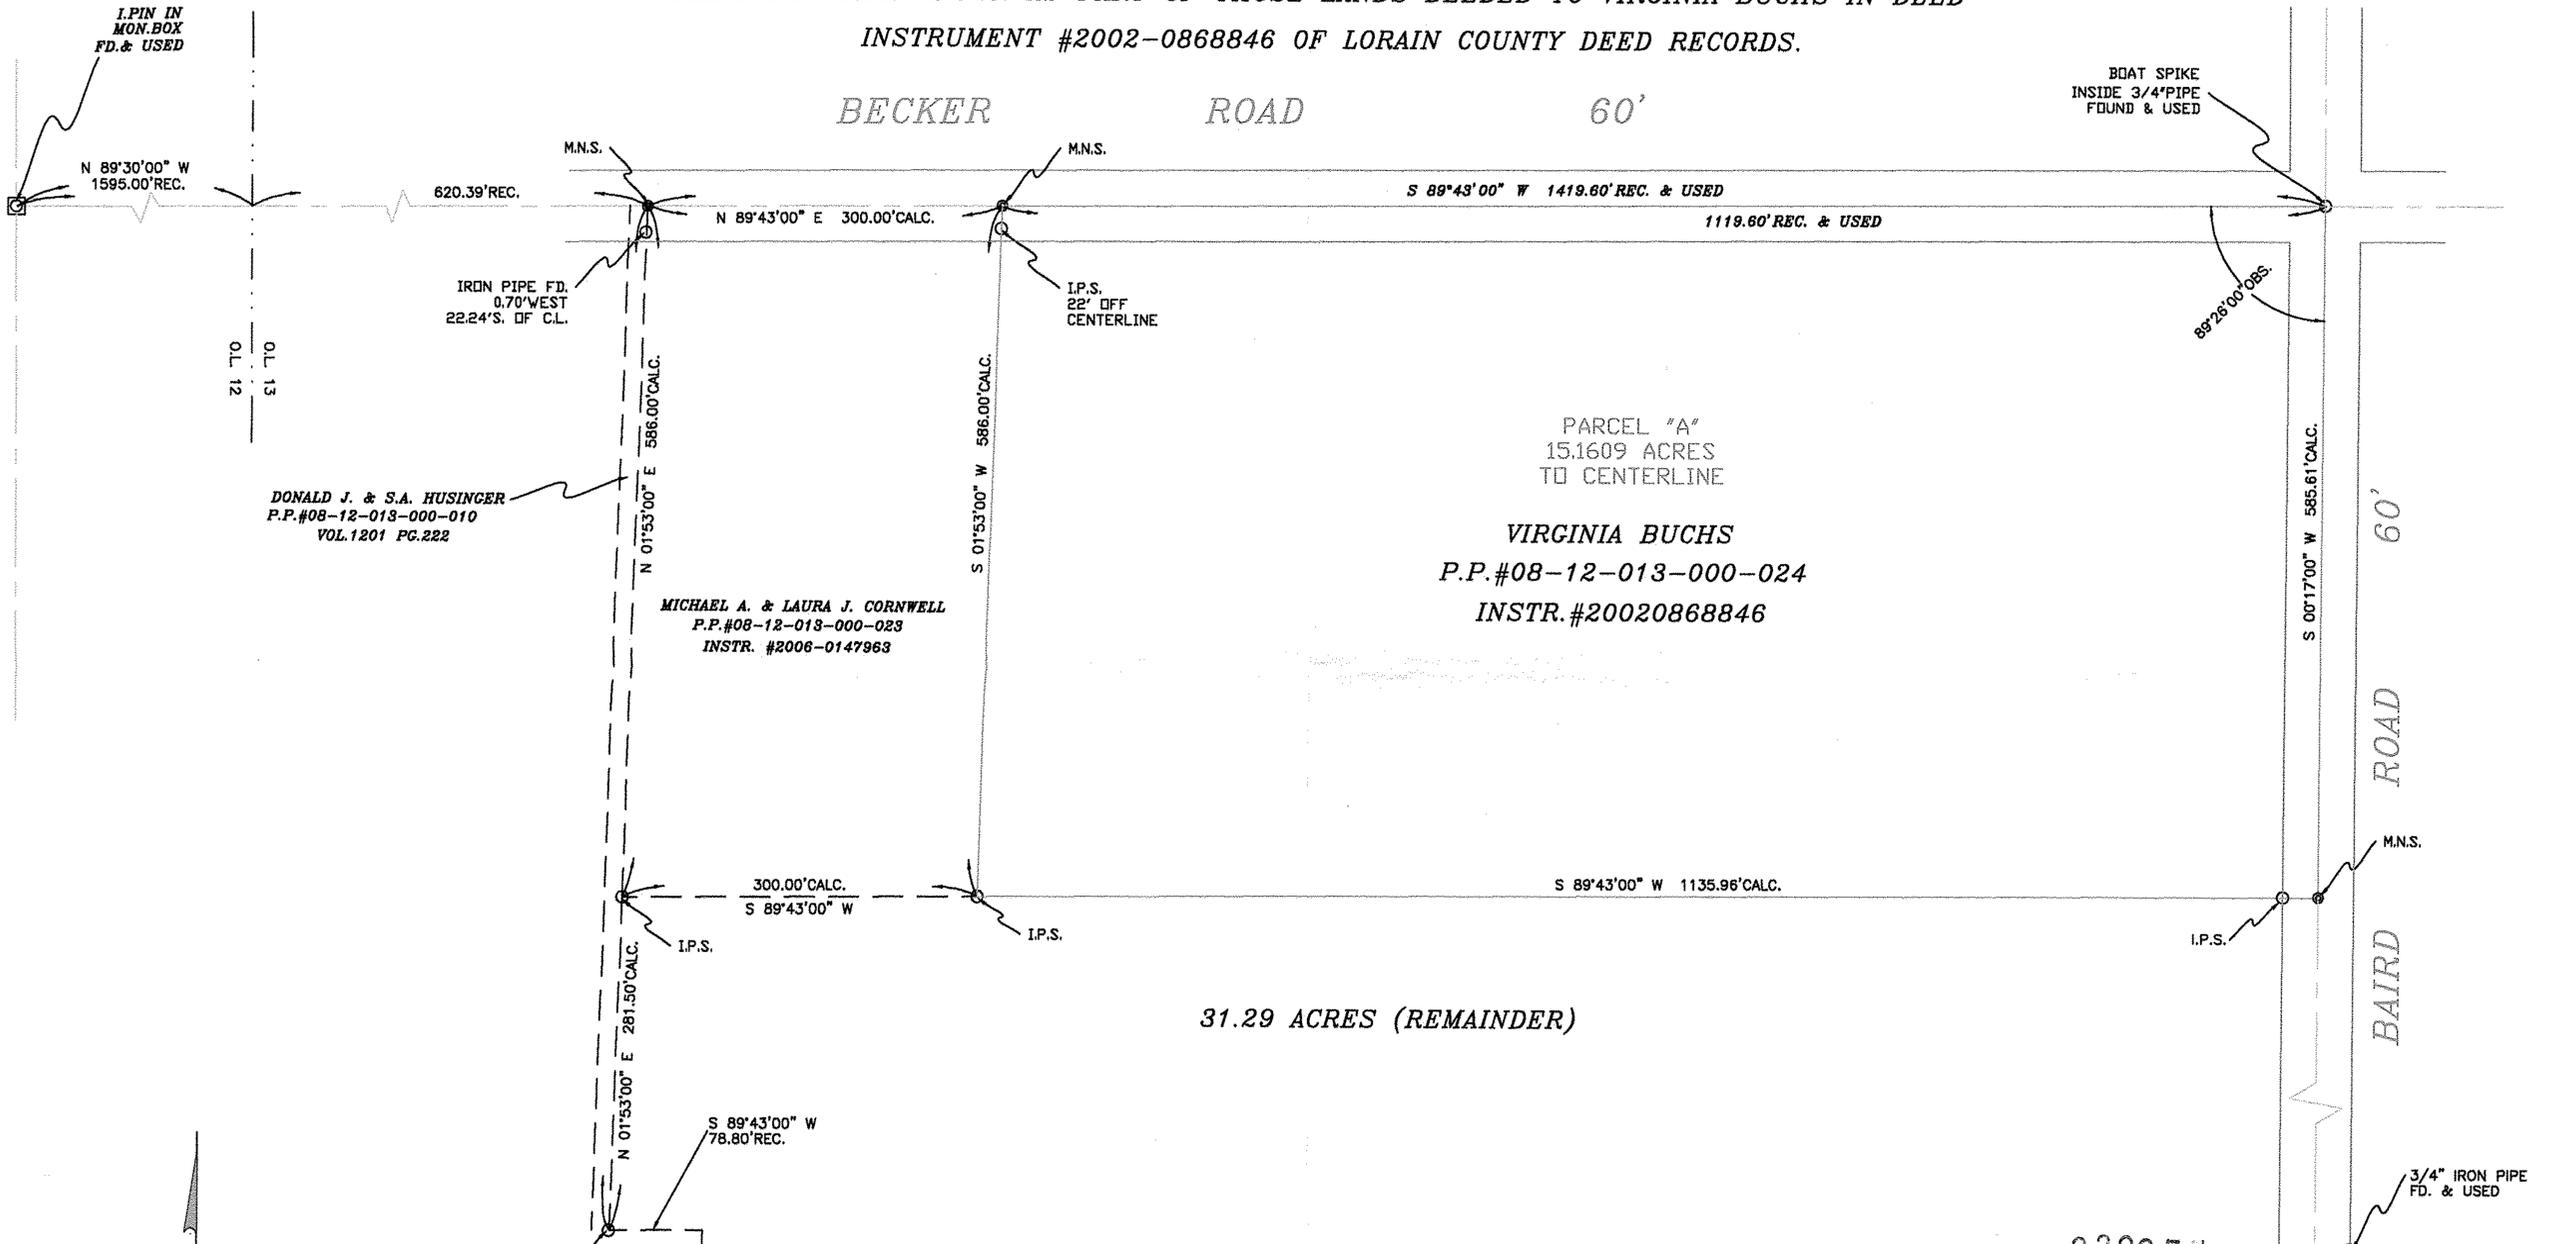

## SURVEYOR'S STATEMENT

DISTANCES ARE EXPRESSED IN FEET AND DECIMAL PARTS THEREOF. BEARINGS ARE TO AN ASSUMED MERIDIAN AND ARE USED TO INDICATE ANGLES ONLY. PERMANENT MONUMENTS WERE FOUND OR SET AS INDICATED HEREON. —○— I.P.S. INDICATES A 5/8" IRON PIN WITH IDENTIFICATION CAP SET. —●— M.N.S. INDICATES A MAGNETIC NAIL SET. ALL OF WHICH I DECLARE TO BE CORRECT TO THE BEST OF MY ABILITY AND BELIEF.

THOMAS M. SNEZEK, R.L.S. #7051

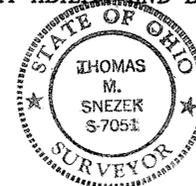

9/10/12  
DATE

03095  
 APPROVED  
 LORAIN CO.  
 MAPPER  
 DATE 11-19-12  
 PAGE 8-E  
 BY J.Hatfield  
 #12-03095

08-12-013-000-025  
026

Scan #47382

PROJECT #1207 9/10/12

0' 100' 200' 300'

SCALE: 1" = 100'