

Scan# 47393 03-00-024-000-078
03-00-024-A




DATE: SEPT 29, 1987
SCALE: 1"=100'




HAPONEK & ASSOCIATES, INC

Engineers & Surveyors
34100 Center Ridge Road
NORTH RIDGEVILLE, OHIO 44039
(216) 327-4776

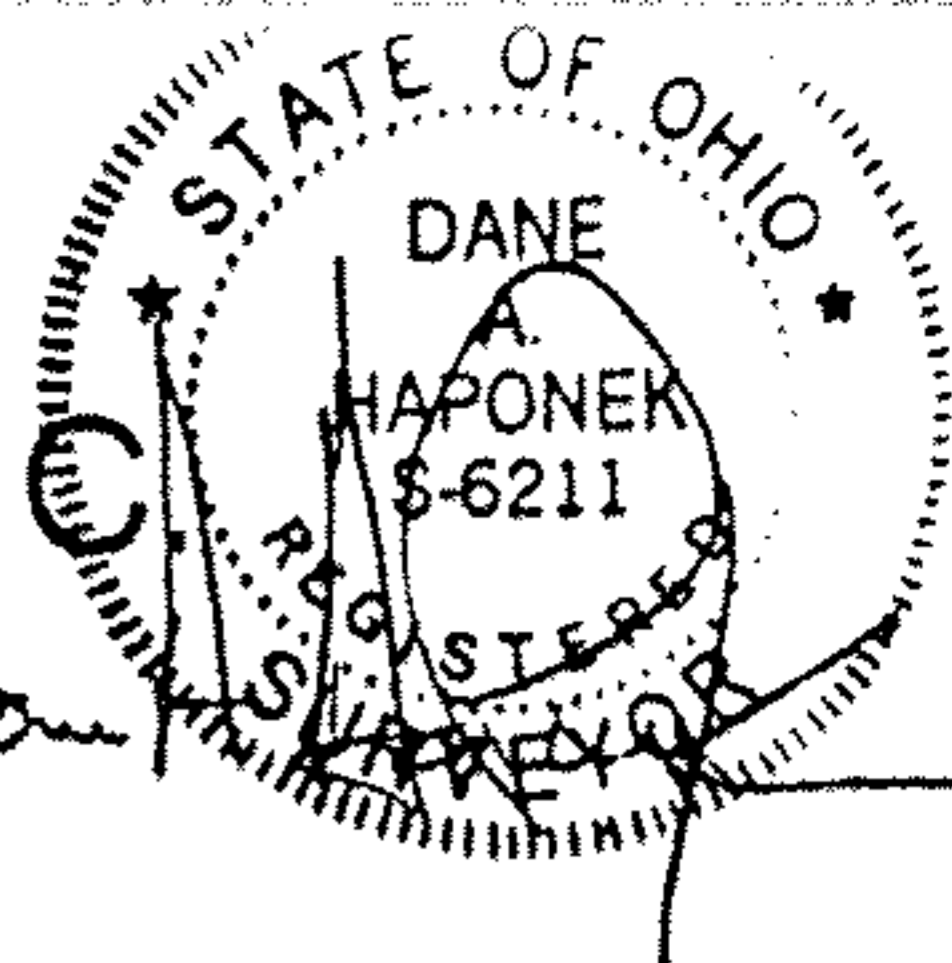

PREPARED FOR
WALTER RAUSCHER
959 HARRIS RD.
SHEFFIELD VILLAGE, O.

HARRIS RD. 60' RD. NORTH

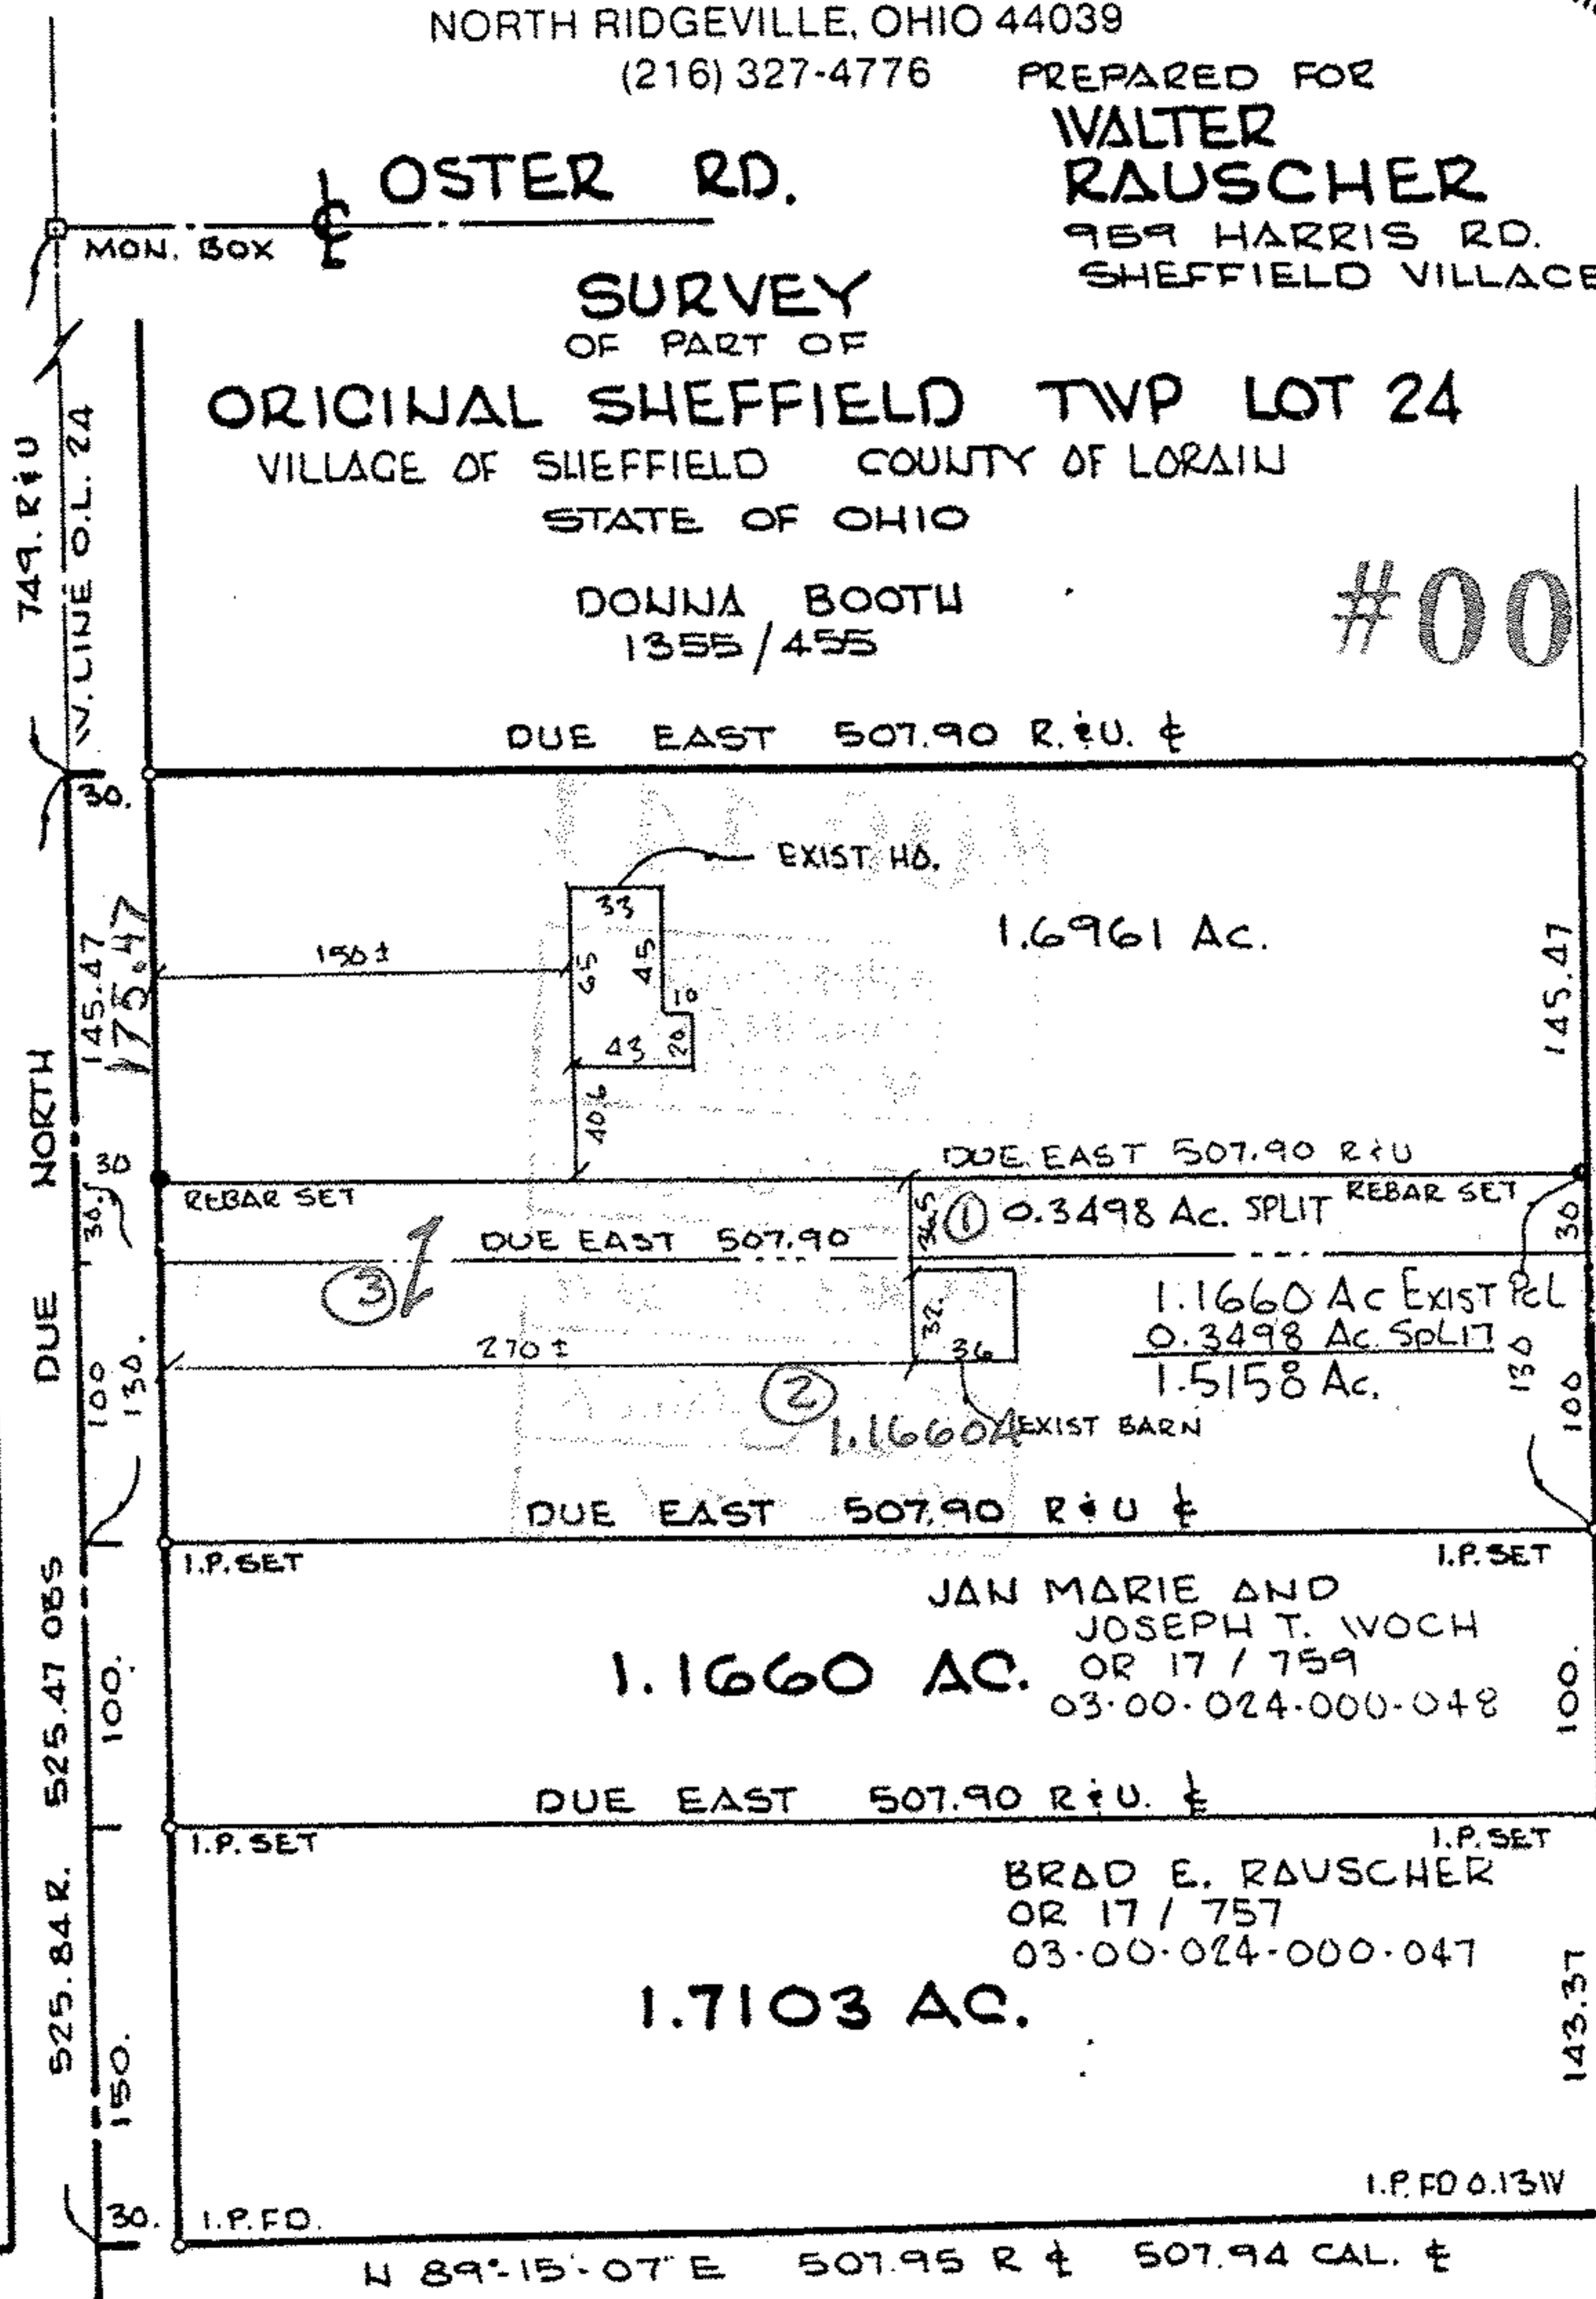

GILBERTE A & JOHN P SHAW
1340/919

N 89°15'07" E 507.95 R & 507.94 CAL. &
NORFOLK AND WESTERN RAILWAY CO.

REVISED: AUG. 28, 1992
SEPT. 25, 1999