




Scan # 47427
 01-00-004-120-055
 01-00-004-D

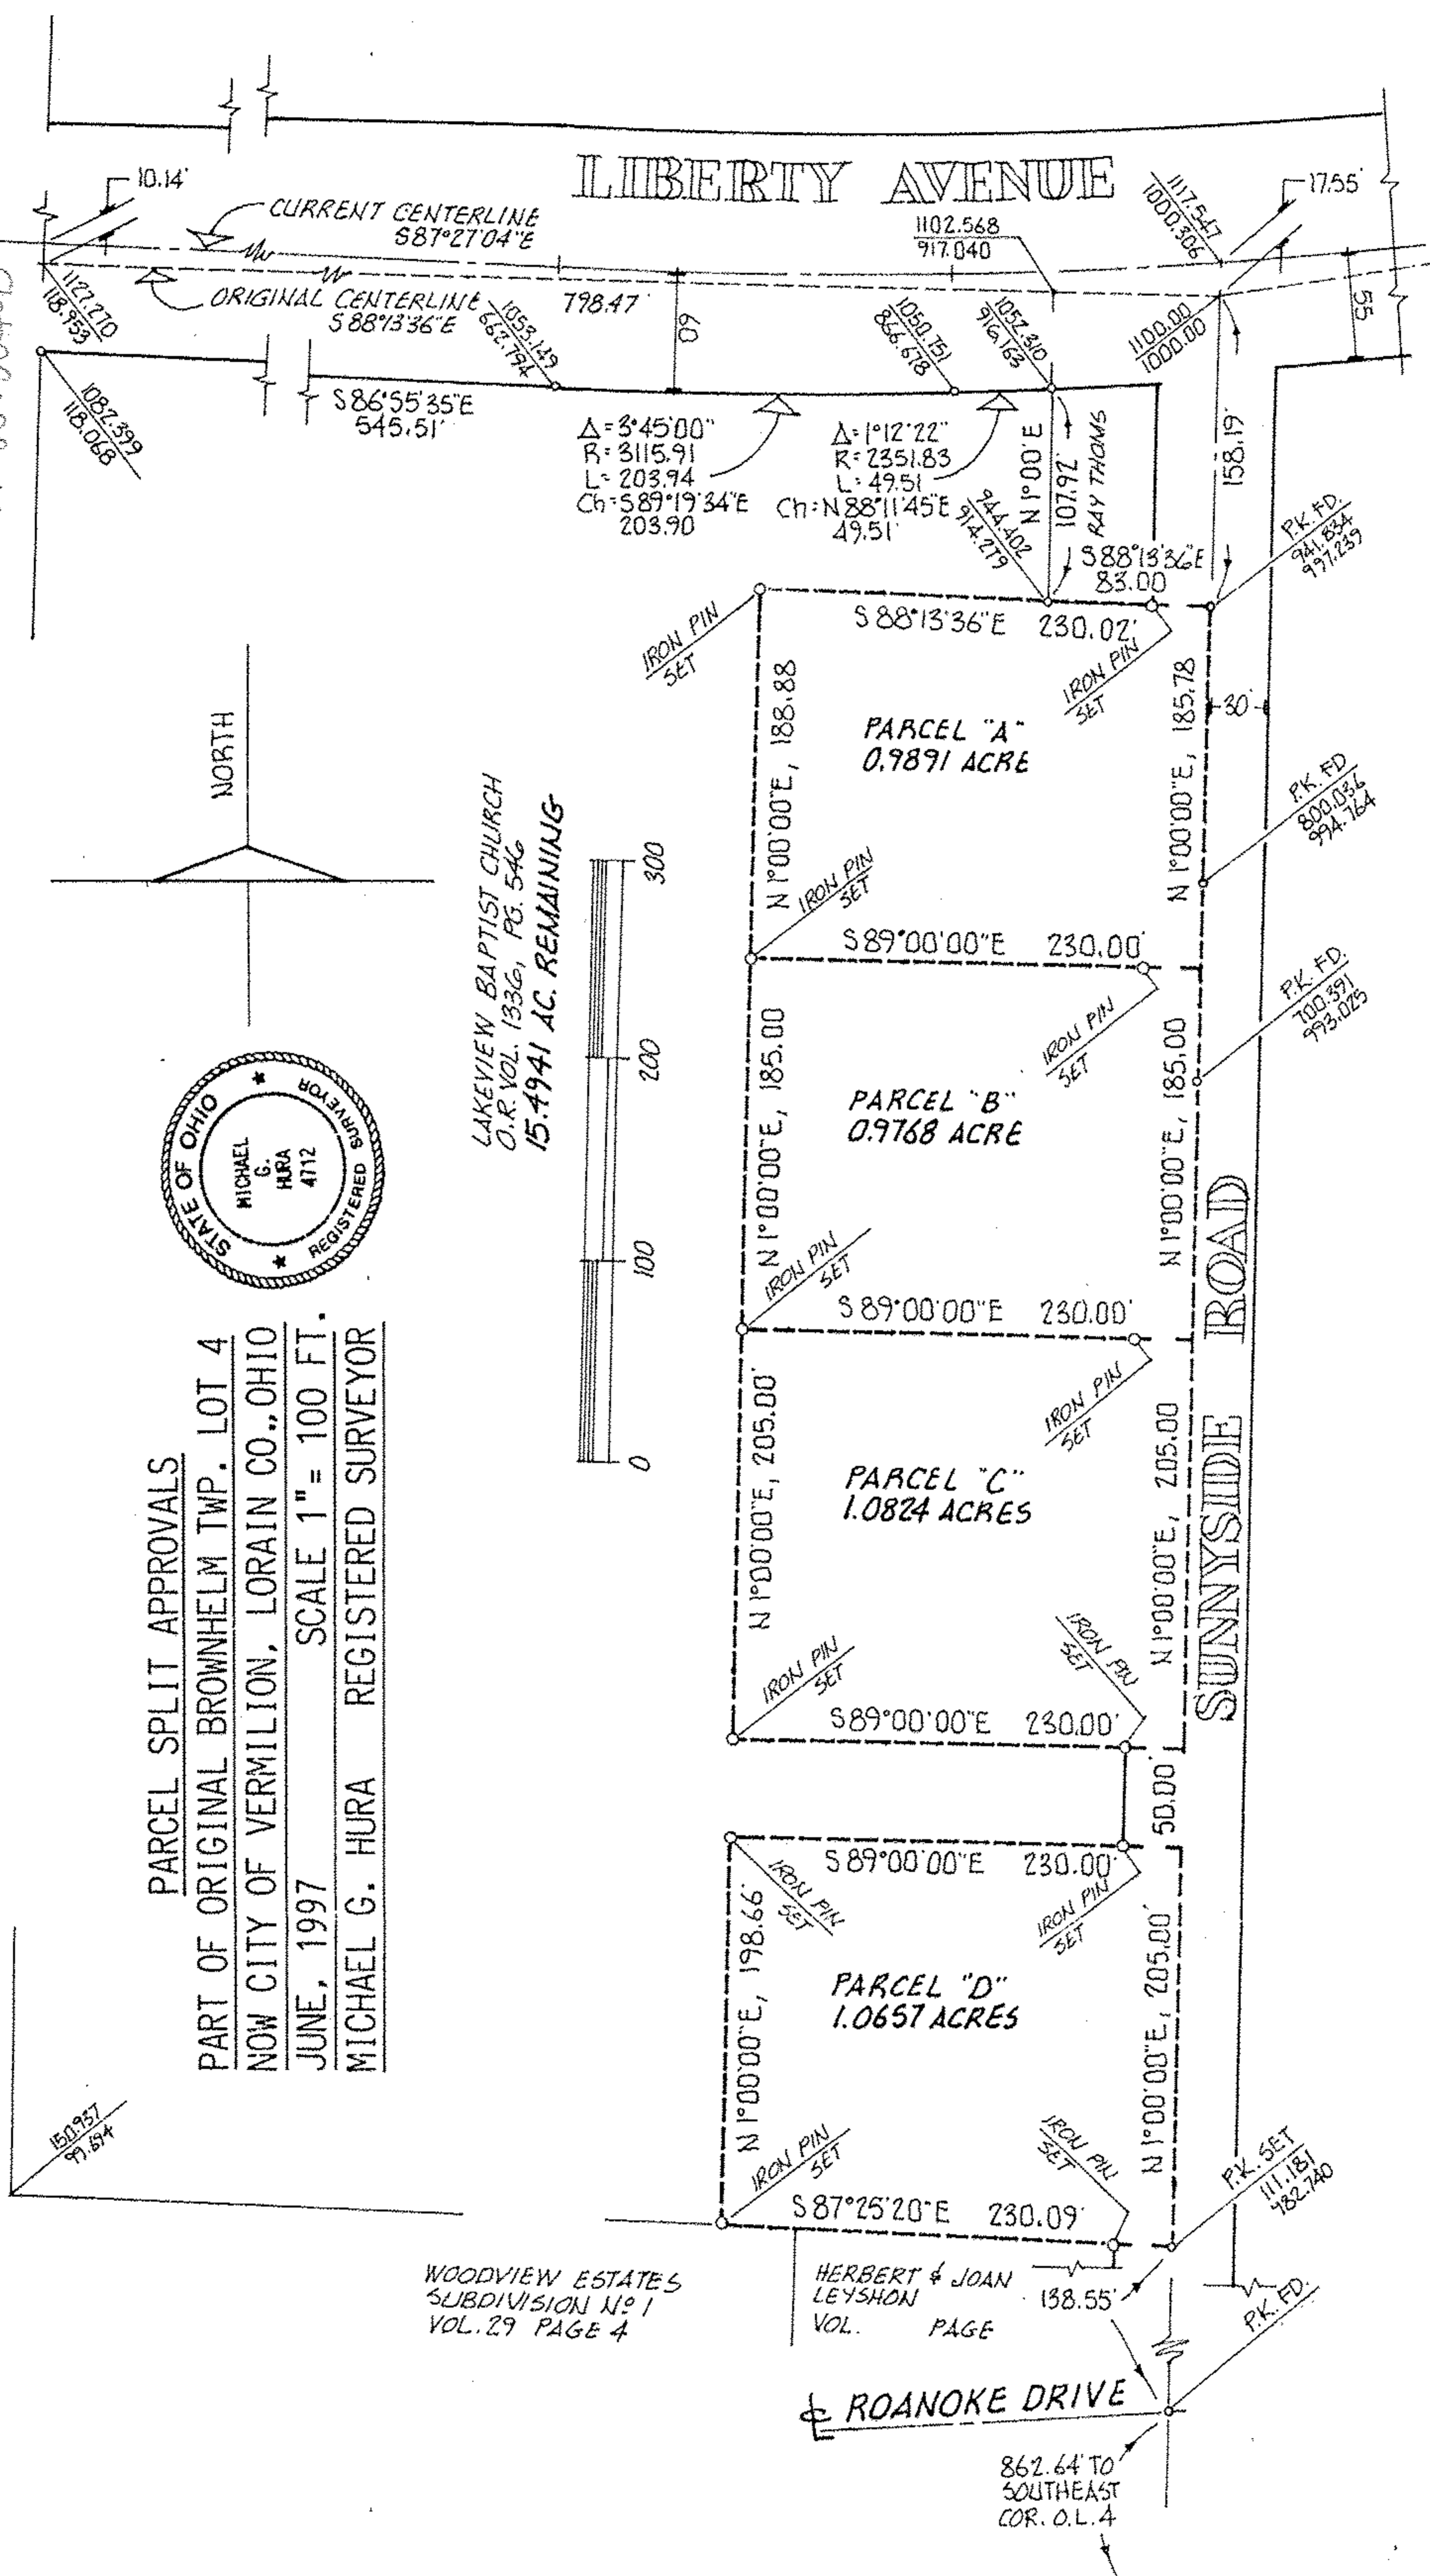

PARCEL SPLIT APPROVALS
 PART OF ORIGINAL BROWNHELM TWP. LOT 4
 NOW CITY OF VERMILION, LORAIN CO., OHIO
 JUNE, 1997 SCALE 1" = 100 FT.
 MICHAEL G. HURA REGISTERED SURVEYOR

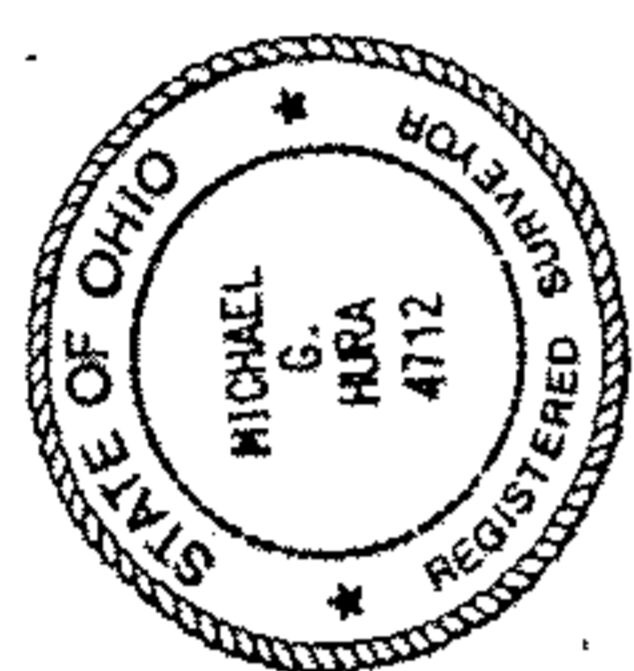

LAKEVIEW BAPTIST CHURCH
 O.R. VOL. 1336, PG. 546
 15.4941 AC. REMAINING

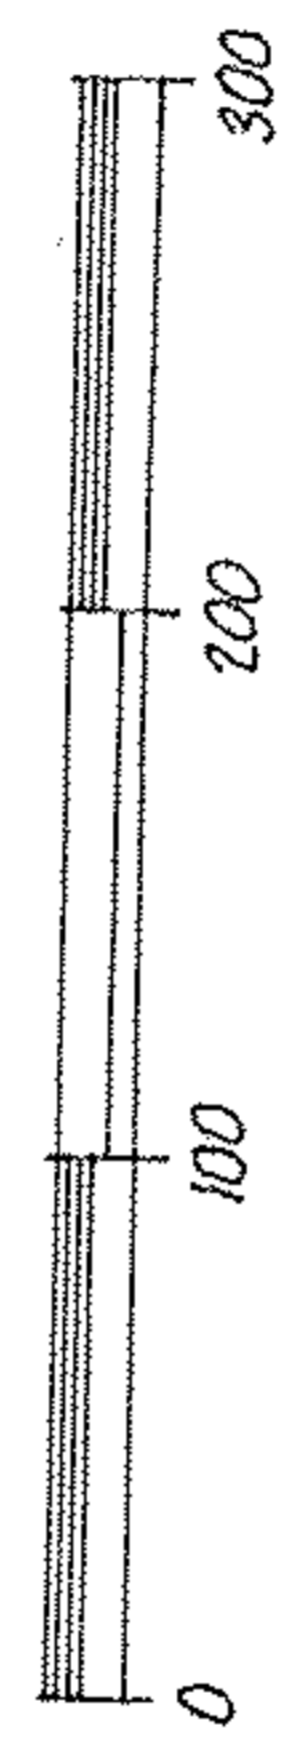

150.837
 99.154

WOODVIEW ESTATES
 SUBDIVISION No 1
 VOL. 29 PAGE 4

HERBERT & JOAN
 LEYSHON
 VOL. PAGE

ROANOKE DRIVE

862.64' TO
 SOUTHEAST
 COR. O.L. 4

P.K. SET
 111.181
 782.740

P.K. FD.
 941.834
 997.239

P.K. FD.
 800.034
 99A-764

P.K. FD.
 100.391
 993-025

LIBERTY AVENUE

SUNNYSIDE ROAD

NORTH

CURRENT CENTERLINE
 S87°27'04"E

ORIGINAL CENTERLINE
 S88°13'36"E

$\Delta = 3^{\circ}45'00''$
 R = 3115.91
 L = 203.94
 Ch = S89°19'34"E
 203.90

$\Delta = 1^{\circ}12'22''$
 R = 2351.83
 L = 49.51
 Ch = N88°11'45"E
 49.51

RAY THOMAS

IRON PIN SET

IRON PIN SET






1102.568
 917.040

117.547
 1000.306

112.210
 118.933

1087.392
 118.068

S86°55'35"E
 545.51'

798.47'

69'

158.19'

55'

30'

185.00'

205.00'

50.00'

205.00'

138.55'

PARCEL "A"
 0.9891 ACRE

PARCEL "B"
 0.9768 ACRE

PARCEL "C"
 1.0824 ACRES

PARCEL "D"
 1.0657 ACRES

S88°13'36"E 230.02'

S89°00'00"E 230.00'

S89°00'00"E 230.00'

S89°00'00"E 230.00'

S89°00'00"E 230.00'

S87°25'20"E 230.09'

N1°00'00"E, 185.00'

N1°00'00"E, 205.00'

N1°00'00"E, 198.66'

N1°00'00"E, 205.00'

N1°00'00"E, 138.55'

N1°00'E
 107.92'

N1°00'00"E, 188.88'

N1°00'00"E, 185.00'

N1°00'00"E, 205.00'

N1°00'00"E, 205.00'

N1°00'00"E, 138.55'

1100.00
 1000.00
































