
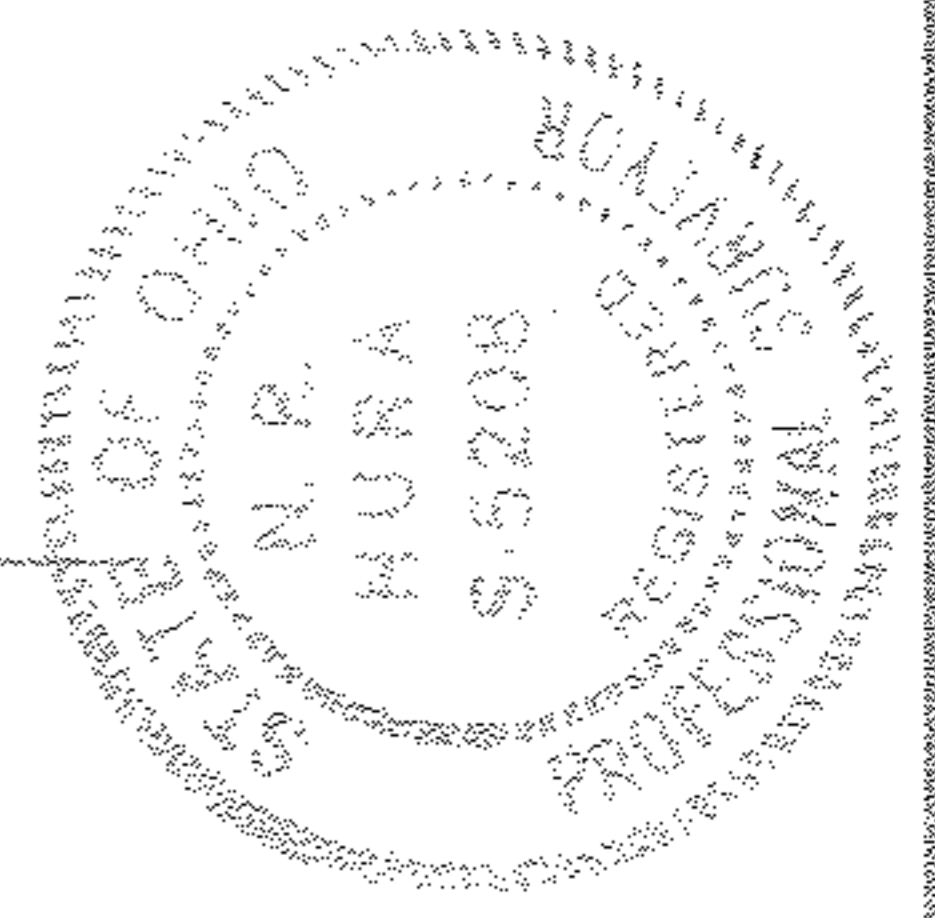


PART OF O.L.N. NO. 55 OF AMHERST TWP
SCALE 1" = 60'-0" DECEMBER 1990

LOT 50.17 FROM PPN 5-00-055-000-016

MR. AND MRS. ROBERT HERRICK
7884 OBERLIN ROAD

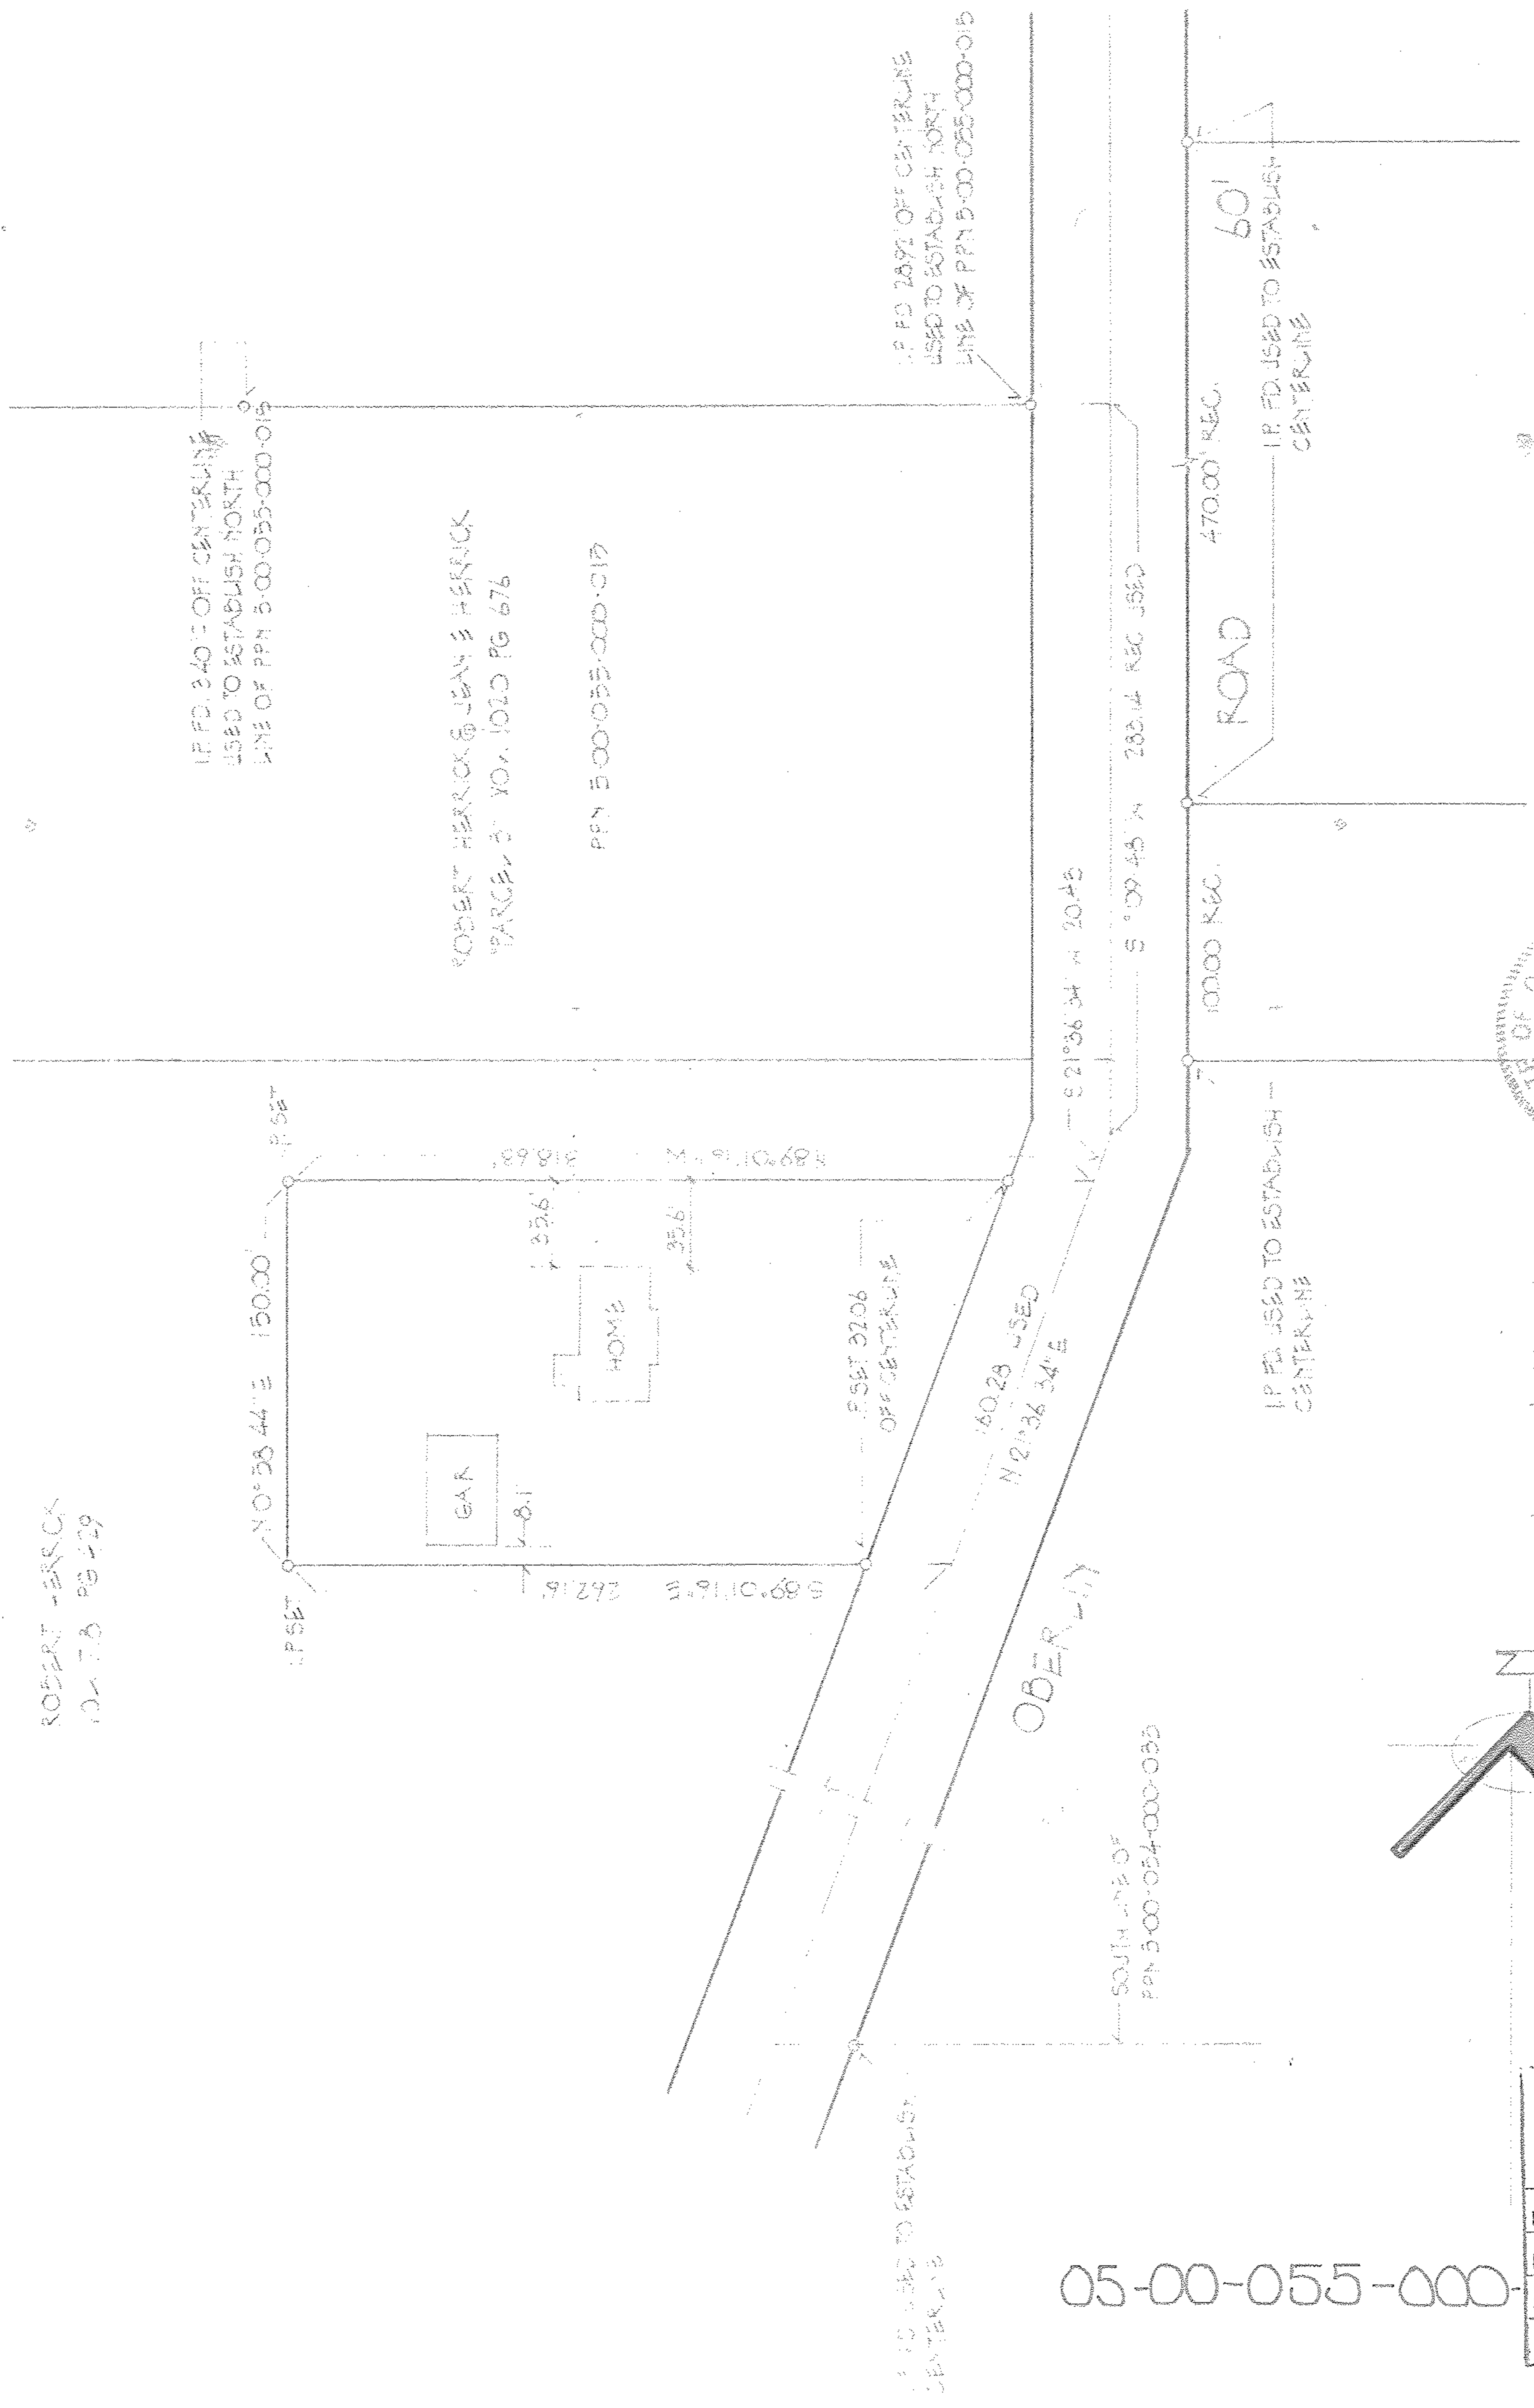

Norman R. Hura and Associates

#19253

APPROVED
LORAIN CO.
MAP DEPT.
DATE 1-16-91
PAGE 5-G
BY CAROLYN FRANCIS
VOID AFTER # 19253

05-00-055-000