12-00-003-000-012
-013

12-00-003-B Scan # 47465

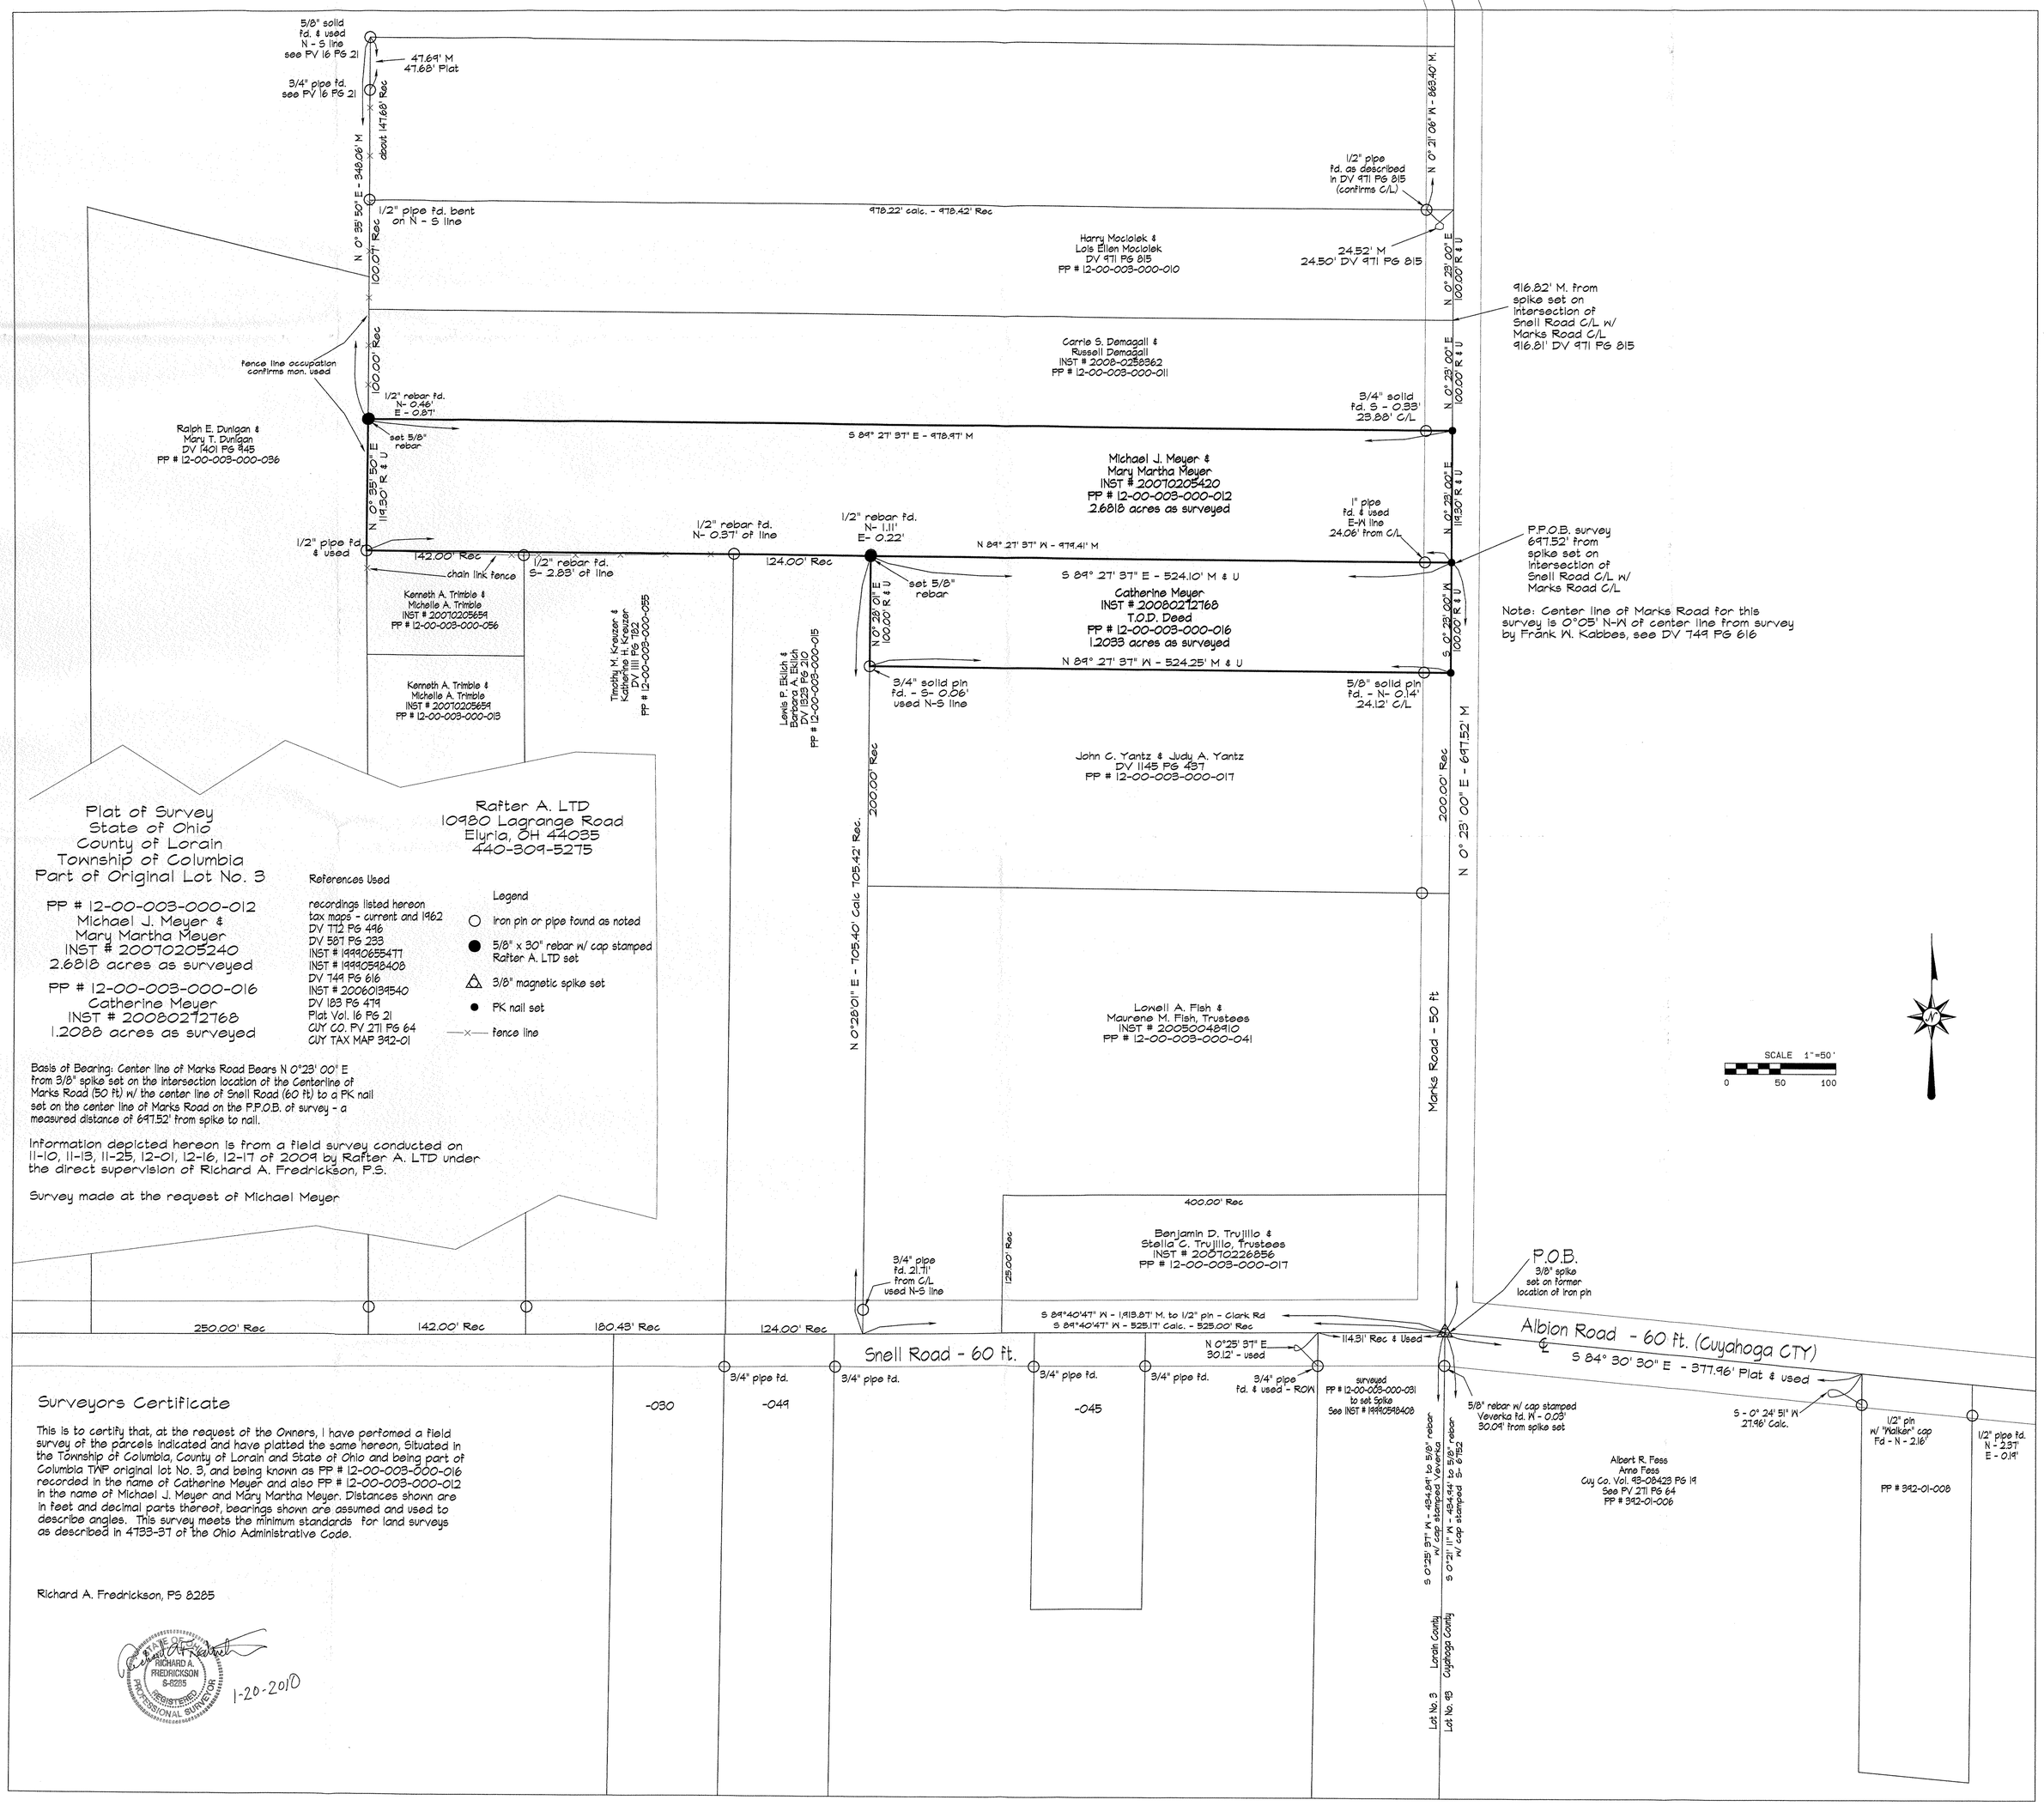

Surveyors Certificate

This is to certify that, at the request of the Owners, I have performed a field survey of the parcels indicated and have platted the same hereon, Situated in the Township of Columbia, County of Lorain and State of Ohio and being part of Columbia TWP original lot No. 3, and being known as PP # 12-00-003-000-016 recorded in the name of Catherine Meyer and also PP # 12-00-003-000-012 in the name of Michael J. Meyer and Mary Martha Meyer. Distances shown are in feet and decimal parts thereof, bearings shown are assumed and used to describe angles. This survey meets the minimum standards for land surveys as described in 4733-37 of the Ohio Administrative Code.

Richard A. Fredrickson, PS 8285

STATE OF OHIO RICHARD A. FREDRICKSON S-8285 REGISTERED PROFESSIONAL SURVEYOR

1-20-2010