01-00-002-~~115~~ 105-115, -116, -117

SCAN # 4 75 16

PLAT OF SURVEY

GRAPHIC SCALE

30 0 15 30

(IN FEET)

1 inch = 30 ft.

FOR PROPERTY OWNED BY:

SECRETARY OF HOUSING AND URBAN DEVELOPMENT

SITUATED IN THE CITY OF VERMILION, COUNTY OF LORAIN AND STATE OF OHIO AND KNOWN AS BEING PART OF SUBLOTS 1524, 1525 AND 1526 IN THE VERMILION-ON-THE-LAKE SUBDIVISION NO.1, PART OF ORIGINAL TOWNSHIP LOT NO. 2 AS RECORDED IN VOL.10, PG.18.

NORTH IS BASED UPON AN ASSUMED MERIDIAN AND IS TO BE USED FOR REFERENCE ONLY.

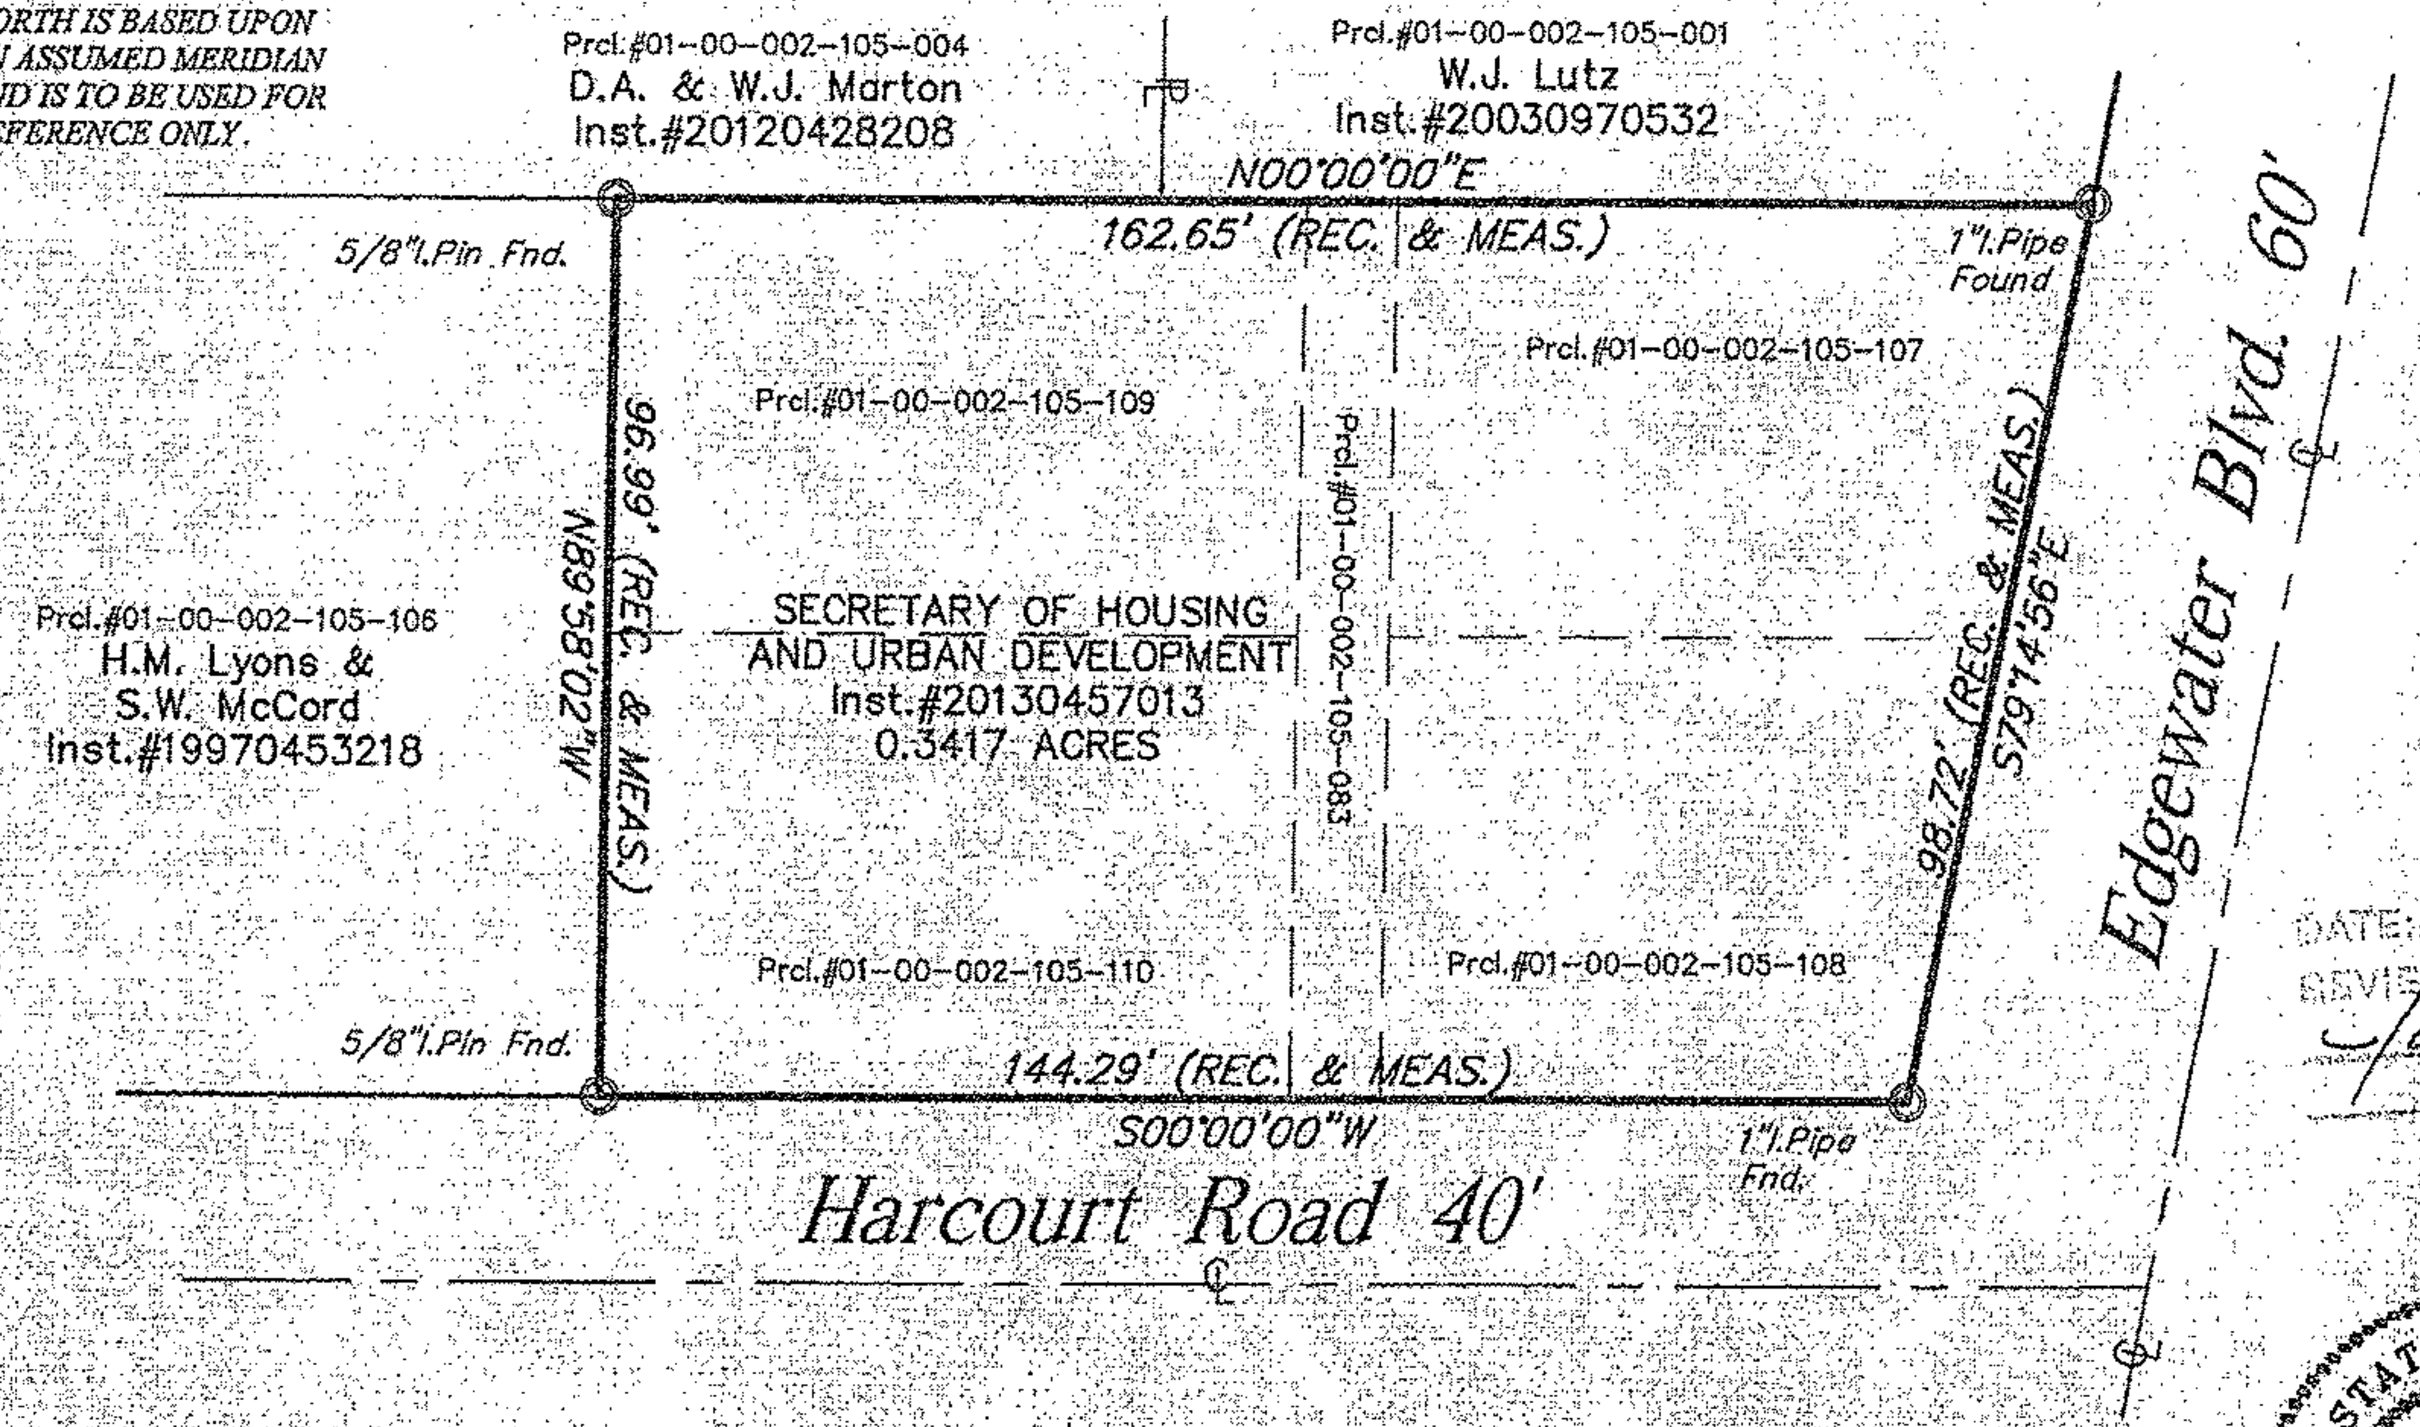

APPROVED LOT MAP

DATE 7-23-13

PAGE 1-00-002 A

BY R. MAINE S

13-02764-C

DATE: 7/19/13

REVIEWED & APPROVED

John L. Lewis

PREPARED BY:

ALBAN SURVEYING CO.

Professional Land Surveyors

38052 Euclid Avenue, Suite 200

Willoughby, OH 44094

Phone: 440-946-0752

I THE UNDERSIGNED DO HEREBY CERTIFY THAT I HAVE SURVEYED THE PREMISES AND HAVE PREPARED THIS PLAT IN ACCORDANCE WITH THE PROVISIONS OF CHAPTER 4733-37 OF THE OHIO ADMINISTRATIVE CODE. DIMENSIONS SHOWN HEREON ARE EXPRESSED IN FEET AND DECIMAL PARTS THEREOF.

6/30/13

JOHN R. ALBAN P.S. 7651

STATE OF OHIO
JOHN R. ALBAN
S-7651
REGISTERED
PROFESSIONAL SURVEYOR