04-00-017-103-290
291
SCAN# 47526

SURVEY
OF
24.9667 ACRES
IN LEGACY POINTE SUBD. #5
VOLUME 92, PAGES 27-30
PART OF
ORIGINAL AVON TOWNSHIP SECTION NO. 17
NOW IN
THE CITY OF AVON LAKE
FOR
KOPF CONSTRUCTION CORP.

BY
THE HENRY G. REITZ ENGINEERING COMPANY
4214 ROCKY RIVER DRIVE, CLEVELAND, OH. 44135
PHONE: (216) 251-3033 FAX: (216) 251-5149

BY _____ V. PRES.
JAMES T. SAYLER, OHIO REG. SURVEYOR NO. S-7425
SCALE: 1" = 100' JUNE, 2013

JAMES T. SAYLER S7425 REGISTERED PROFESSIONAL SURVEYOR

DIMENSIONS SHOWN ON THIS MAP ARE EXPRESSED IN FEET AND DECIMAL PARTS THEREOF. ALL BEARINGS ARE TO AN ASSUMED MERIDIAN AND USED TO DENOTE ANGLES ONLY. PERMANENT MONUMENTS WERE FOUND OR 5/8" CAPPED IRON PINS SET AT AT POINTS INDICATED ON THIS MAP. ALL OF WHICH WE CERTIFY TO BE CORRECT.

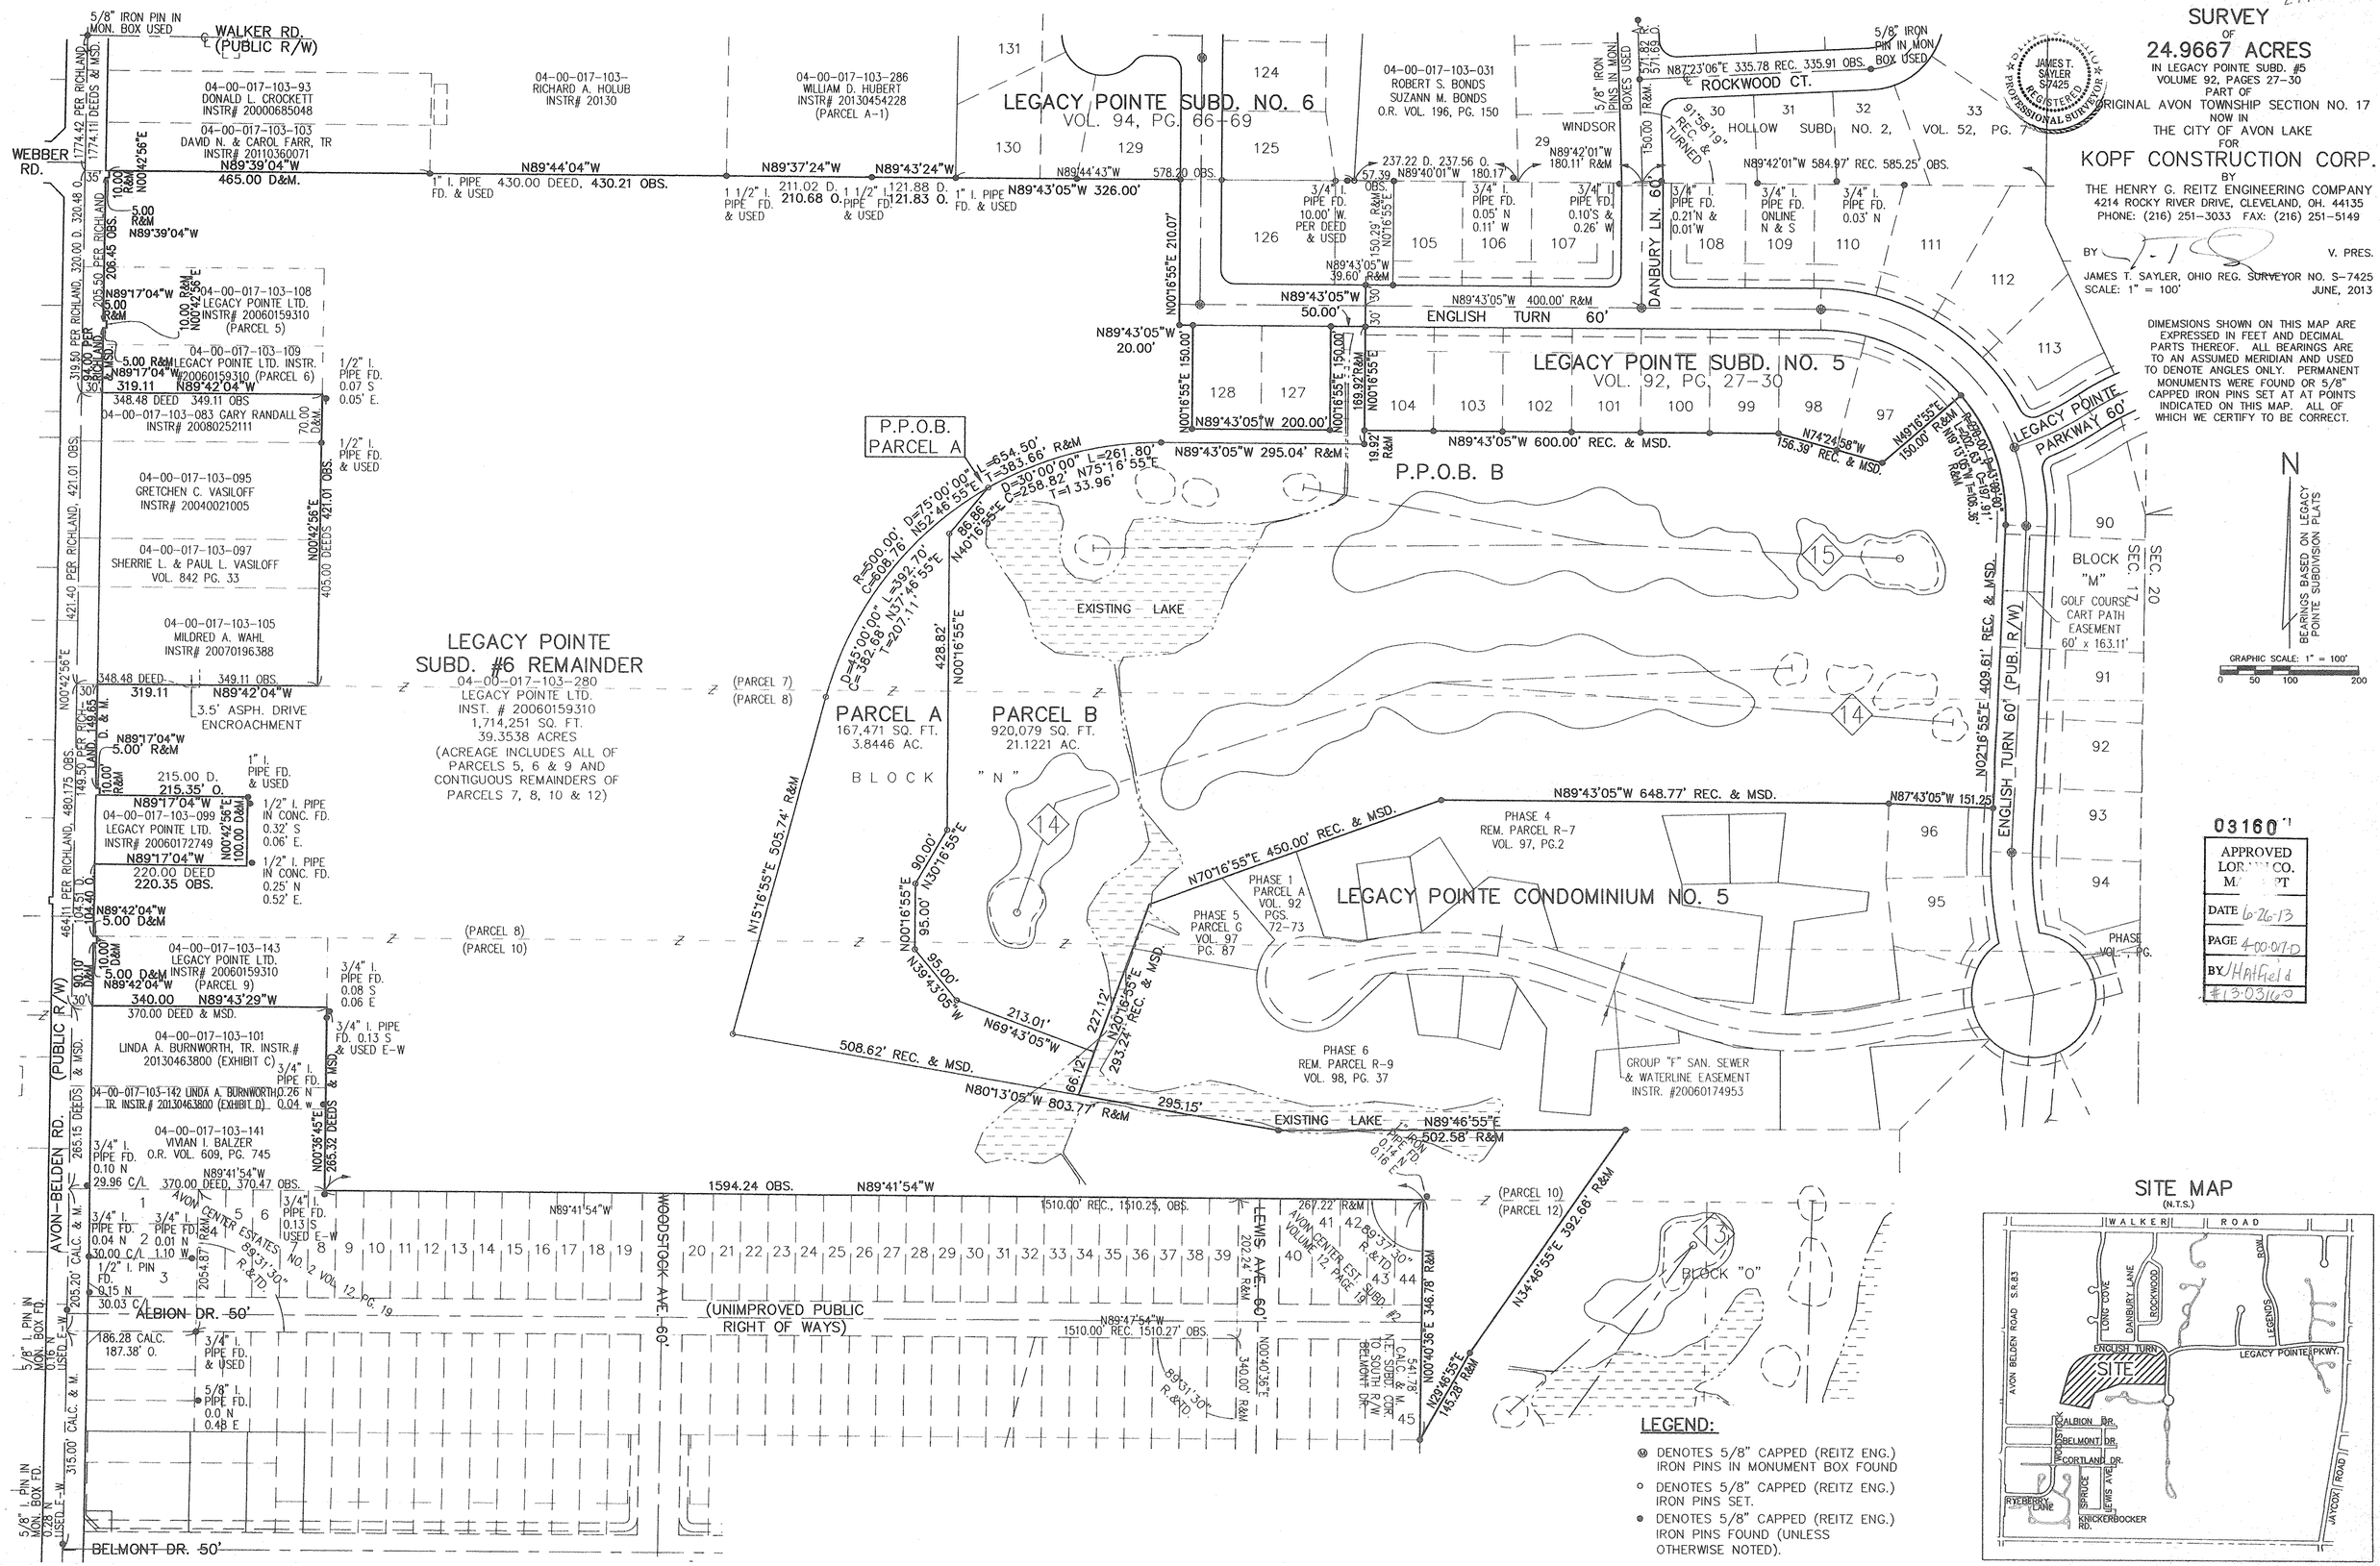

03160

APPROVED LORAIN CO. MAP DEPT
DATE 6-26-13
PAGE 4-00-017-D
BY JHatfield
#13-03160

SITE MAP
(N.T.S.)

LEGEND:

- ⓜ DENOTES 5/8" CAPPED (REITZ ENG.) IRON PINS IN MONUMENT BOX FOUND
- ○ DENOTES 5/8" CAPPED (REITZ ENG.) IRON PINS SET.
- ● DENOTES 5/8" CAPPED (REITZ ENG.) IRON PINS FOUND (UNLESS OTHERWISE NOTED).