


03184
 APPROVED
 LORAIN CO.
 MAP DEPT
 DATE 9-18-13
 PAGE 17-E
 BY J. Hatfield
 #13-03184

SITUATED IN THE TOWNSHIP OF BRIGHTON, COUNTY OF LORAIN, STATE OF OHIO
 AND BEING KNOWN AS PART OF ORIGINAL BRIGHTON TOWNSHIP TRACT 7, LOT
 20 AND BEING ALL OF THOSE LANDS DEEDED TO ELIZABETH L. AND ADAM W.
 CLARK RECORDED ON NOVEMBER 16, 2012 IN DEED INSTRUMENT #2012-0437003
 OF LORAIN COUNTY DEED RECORDS.

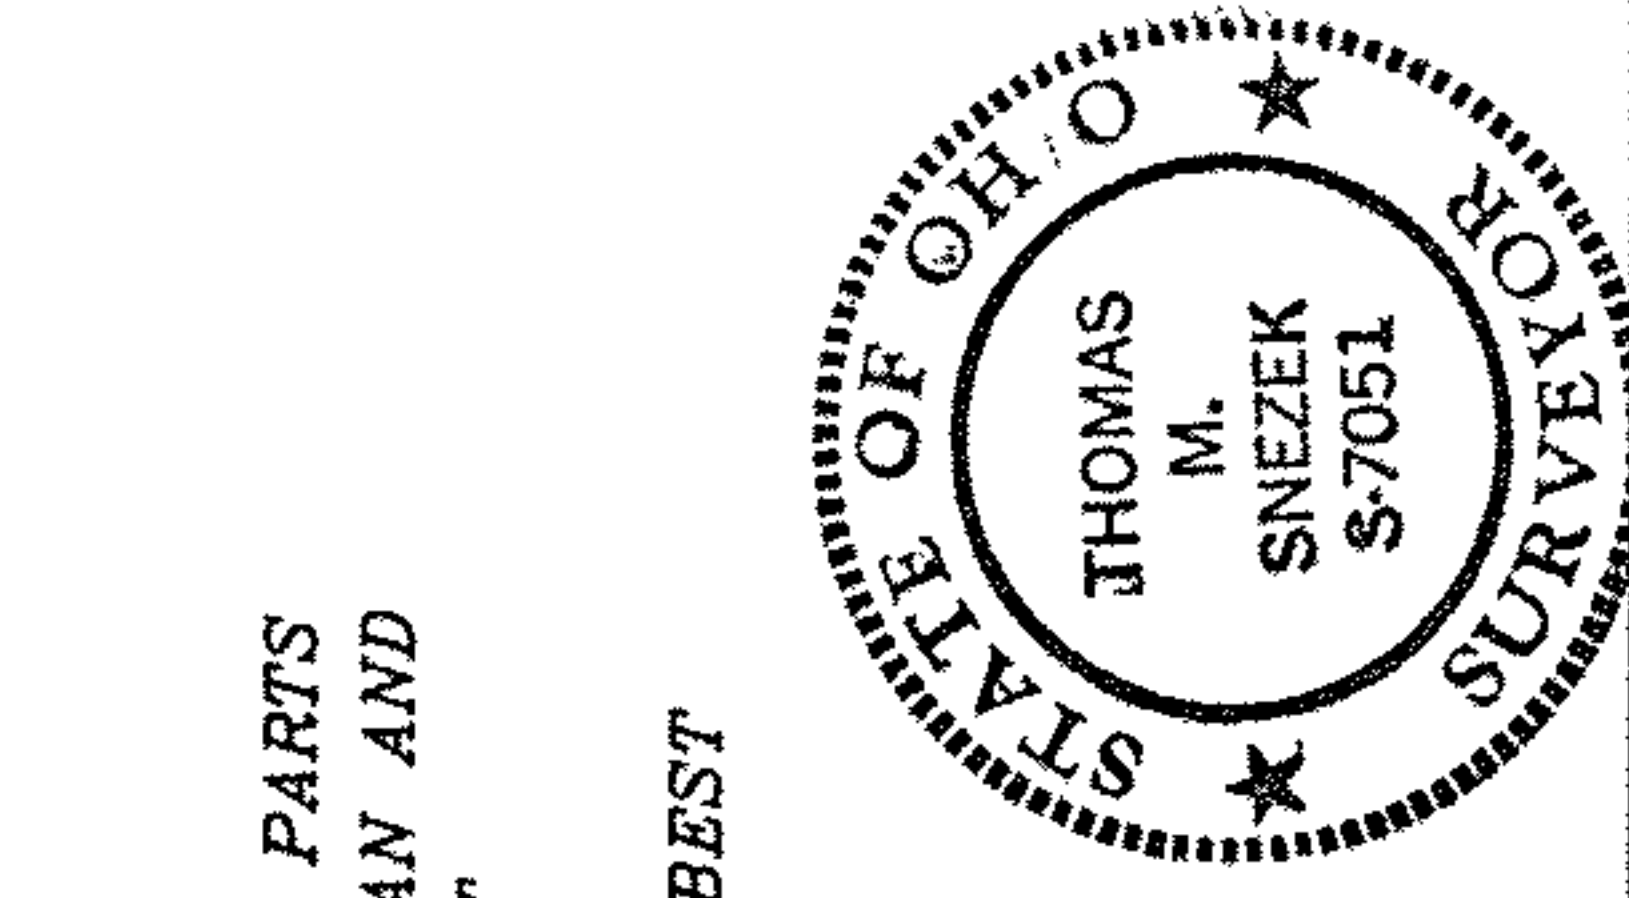

SURVEYOR'S STATEMENT
 DISTANCES ARE EXPRESSED IN FEET AND DECIMAL PARTS
 THEREOF. BEARINGS ARE TO AN ASSUMED MERIDIAN AND
 ARE USED TO INDICATE ANGLES ONLY. PERMANENT
 MONUMENTS WERE FOUND AS INDICATED HEREON
 ALL OF WHICH I DECLARE TO BE CORRECT TO THE BEST
 OF MY ABILITIES AND BELIEFS.

THOMAS M. SNEZEK, P.S. 7051
 DATE: 9/2/13

- LEGEND:**
- 5/8" CAPPED IRON PIN FOUND MARKED "T. SNEZEK - S-7051"
 - EXISTING IRON PROPERTY MARK FOUND AS INDICATED HEREON
 - ⊙ RAILROAD SPIKE FOUND AS INDICATED HEREON
 - ⊖ M.N.S. INDICATES A MAGNETIC NAIL FOUND