

SURVEY OF PART OF ORIGINAL GRAFTON TOWNSHIP LOT 91 TOWNSHIP OF GRAFTON COUNTY OF LORAIN STATE OF OHIO


PREPARED FOR: VADIM TELYETEN

APPROVED LORAIN CO. MAP DEPT. DATE 9/12/13 PAGE 16-00-091-B BY T. SPILLMAN

DATE: AUG. 1, 2013 SCALE: 1"=100'

STATE OF OHIO PROFESSIONAL SURVEYOR WILFREDO BARBOSA

LORAIN COUNTY MEDINA COUNTY

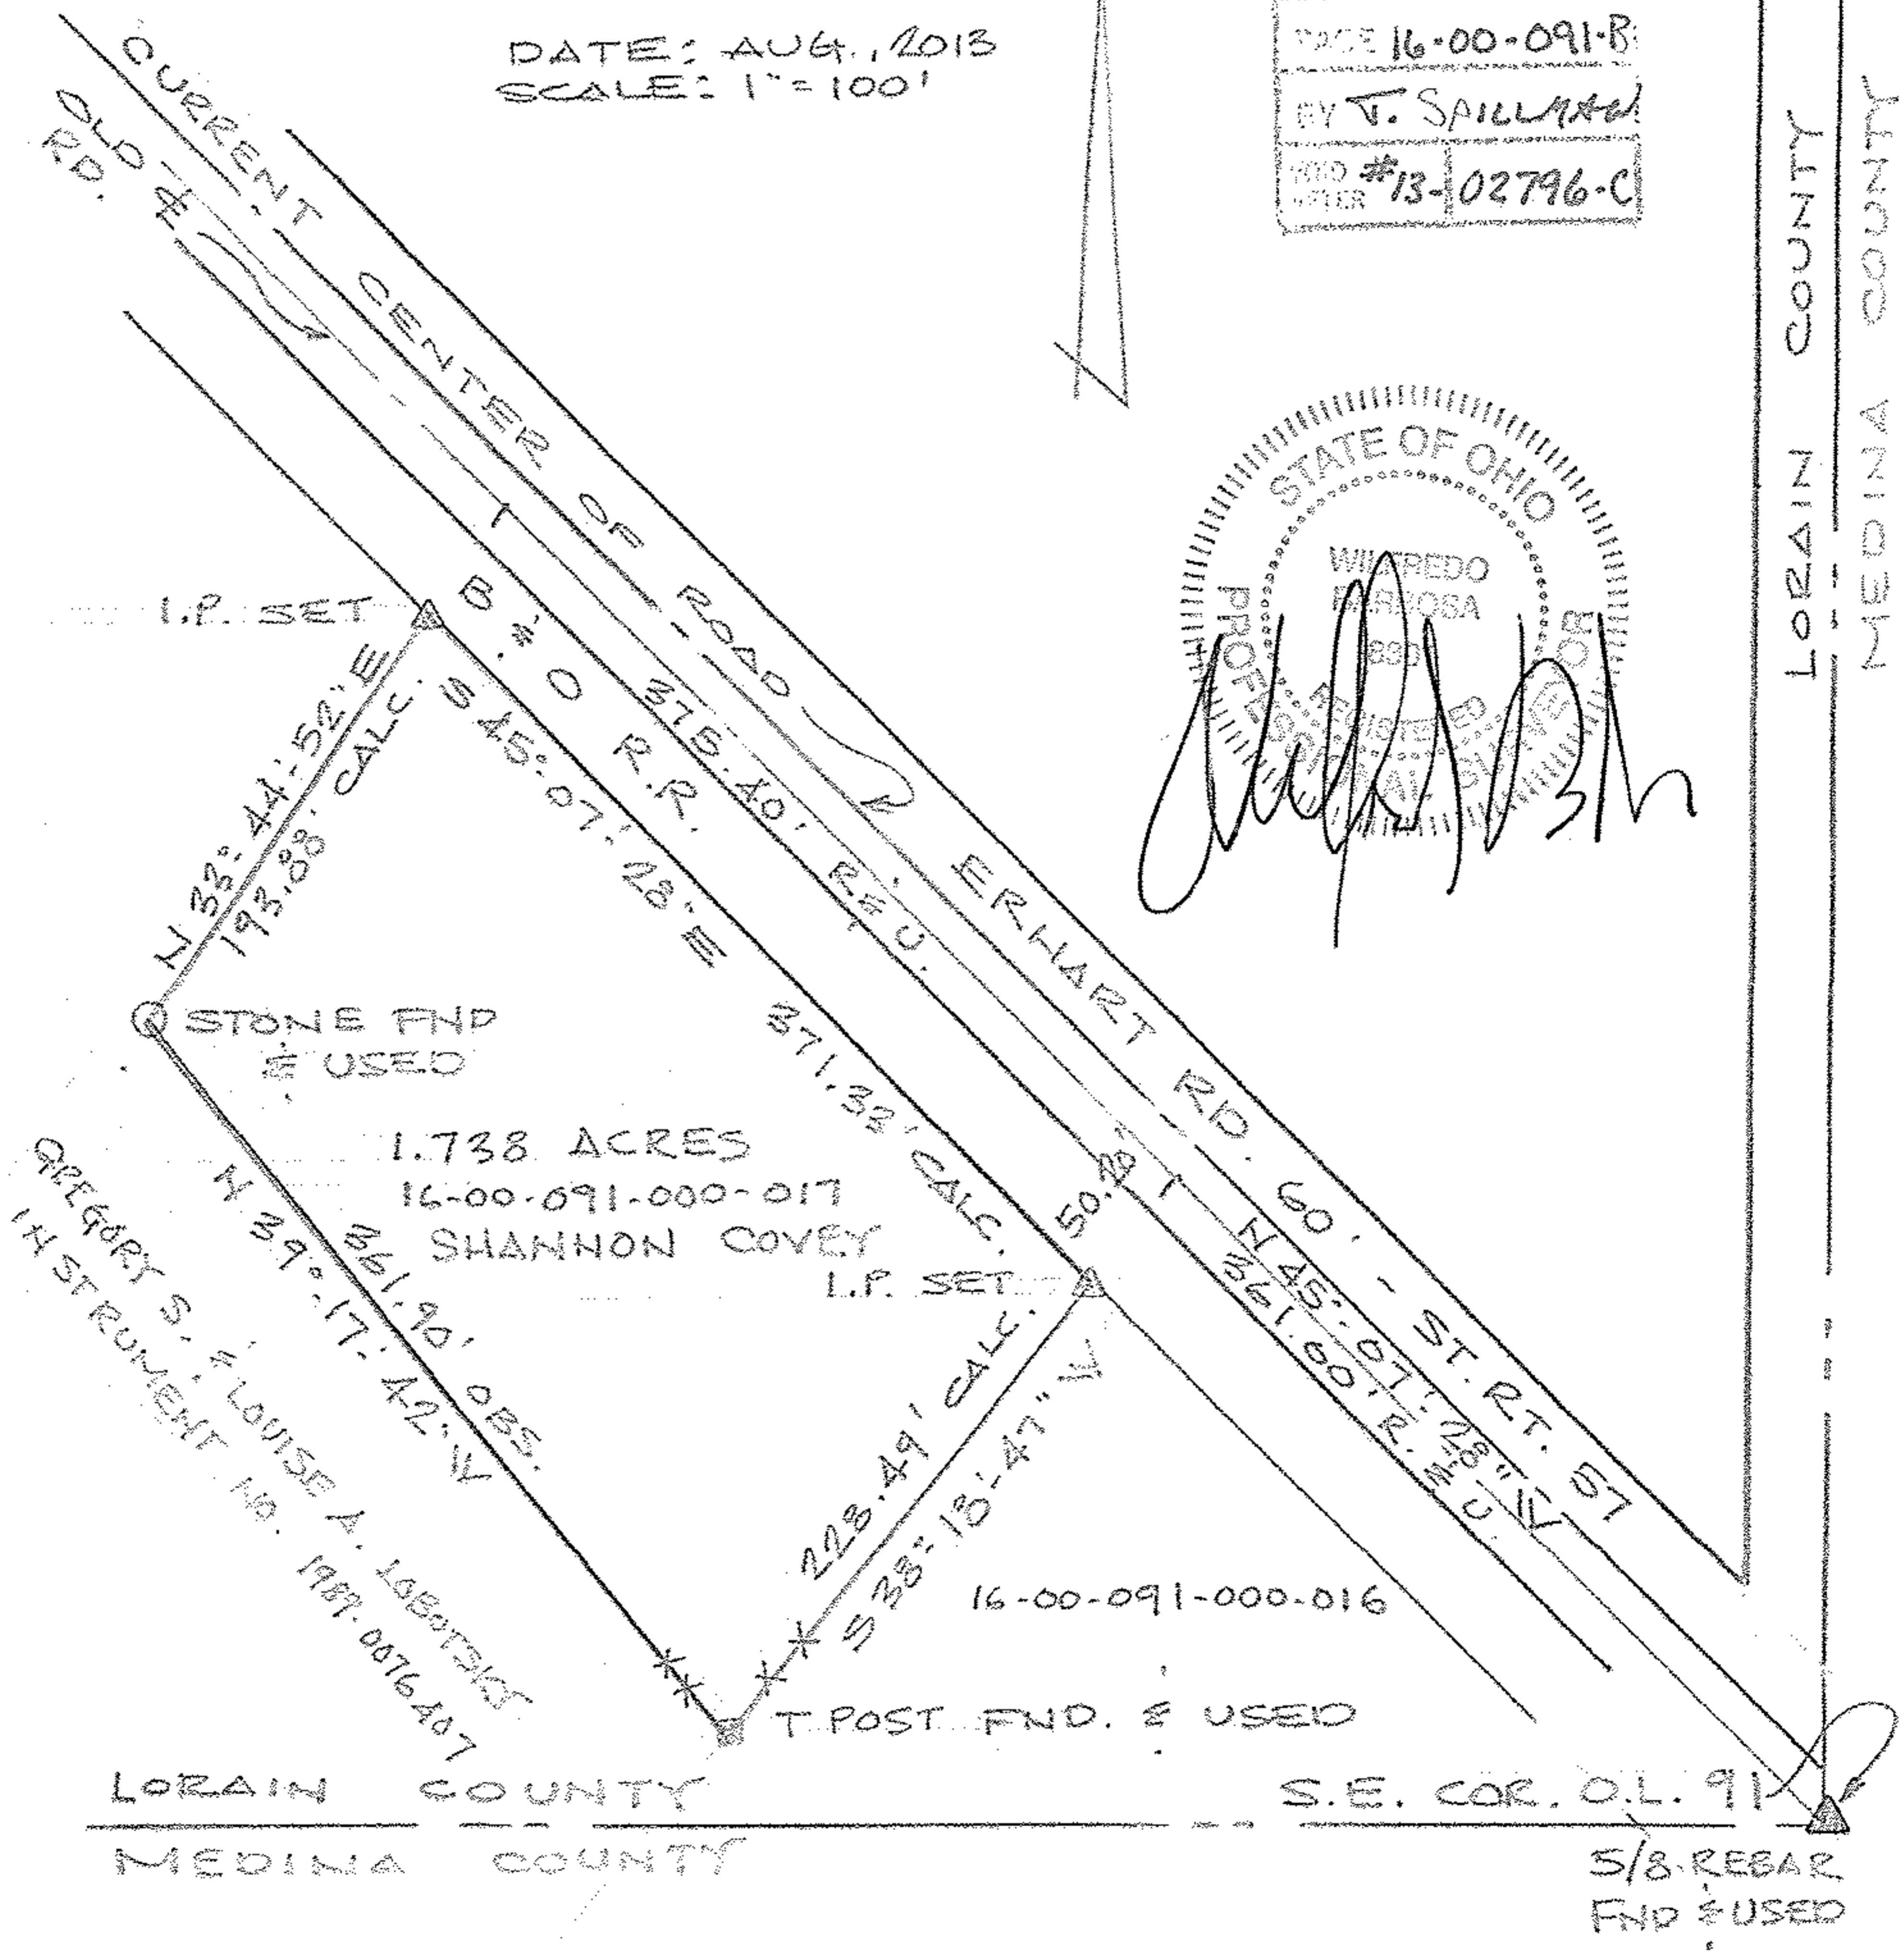

LORAIN COUNTY MEDINA COUNTY

S.E. COR. O.L. 91 5/8 REBAR FND & USED