Plat of Survey
State of Ohio
County of Lorain
Township of Camden
Tract No. 11
Original Lot No. 27
PP # 13-11-027-000-021
written title
DV 1087 PG 488 Allen C. Buchs & Faith H. Buchs
DV 1009 PG 780 Faith H. Buchs
8.0498 acres as surveyed

survey made at the request of Faith Buchs

field survey performed by Rafter A. LTD on 4-14,4-15,4-23,5-5,5-12 under the direct supervision of Richard A. Fredrickson, P.S. 8285

Basis of Bearing is from State Plane Coordinates North Zone (3401) NAD83 w/ a 2007 adjustment obtained from GPS observations made at the survey site

legend

○ iron pin or pipe found as noted

● PK nail set

References used

recordings listed hereon

Plat of Survey by Lor. Co. Engineer 11-96

Plat of Survey C.E. Penfound 8-4-1972

Plat of Survey by T. Snezek 7-8-2009

ODOT SH 886 sheet 1 - 3 of 17 - 1937
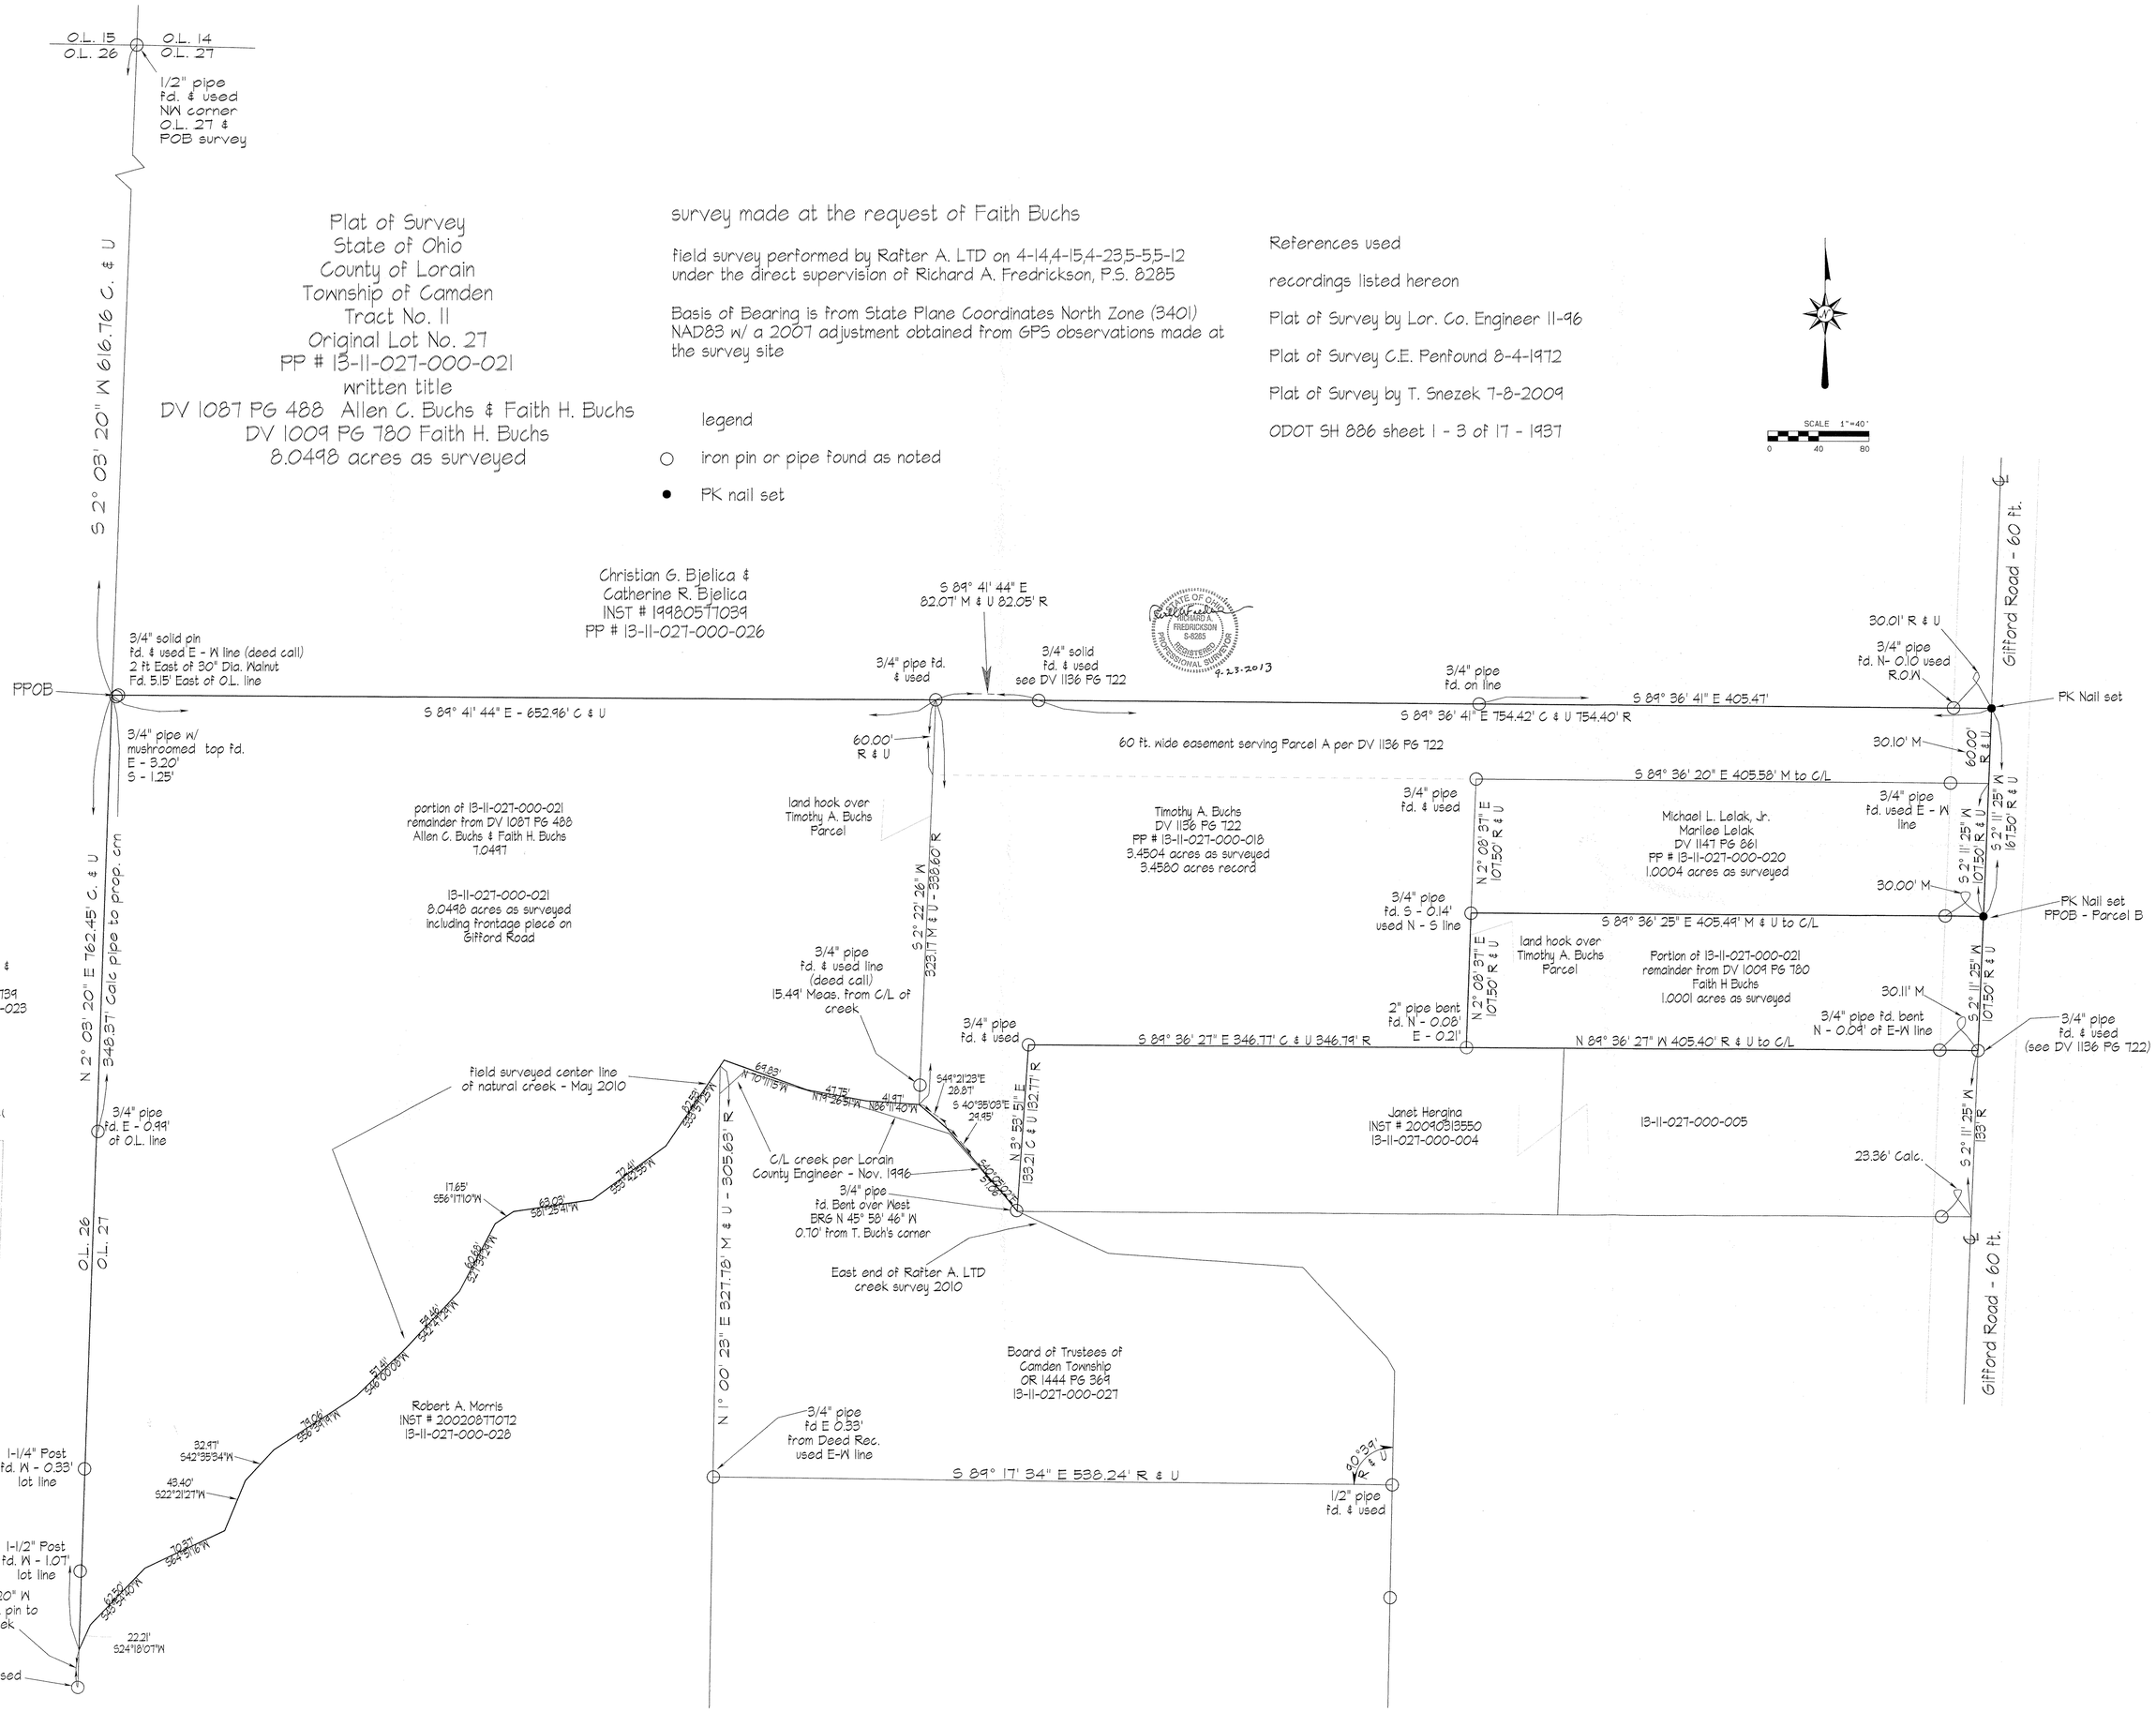
STATE OF OHIO
RICHARD A. FREDRICKSON
S-8285
REGISTERED
PROFESSIONAL SURVEYOR
7-23-2013