


DATE: October 16, 2013

BOUNDARY SURVEY
FOR
EVERBANK

SITUATED IN THE CITY OF LORAIN, COUNTY OF LORAIN
AND STATE OF OHIO, AND KNOWN AS BEING PART OF
IN ROCKEFELLER AND ANDREWS' ALLOTMENT
ORIGINAL SHEFFIELD TOWNSHIP LOT NO. 51

H.N. 619 COLORADO AVENUE

SCALE 1" = 20 ft

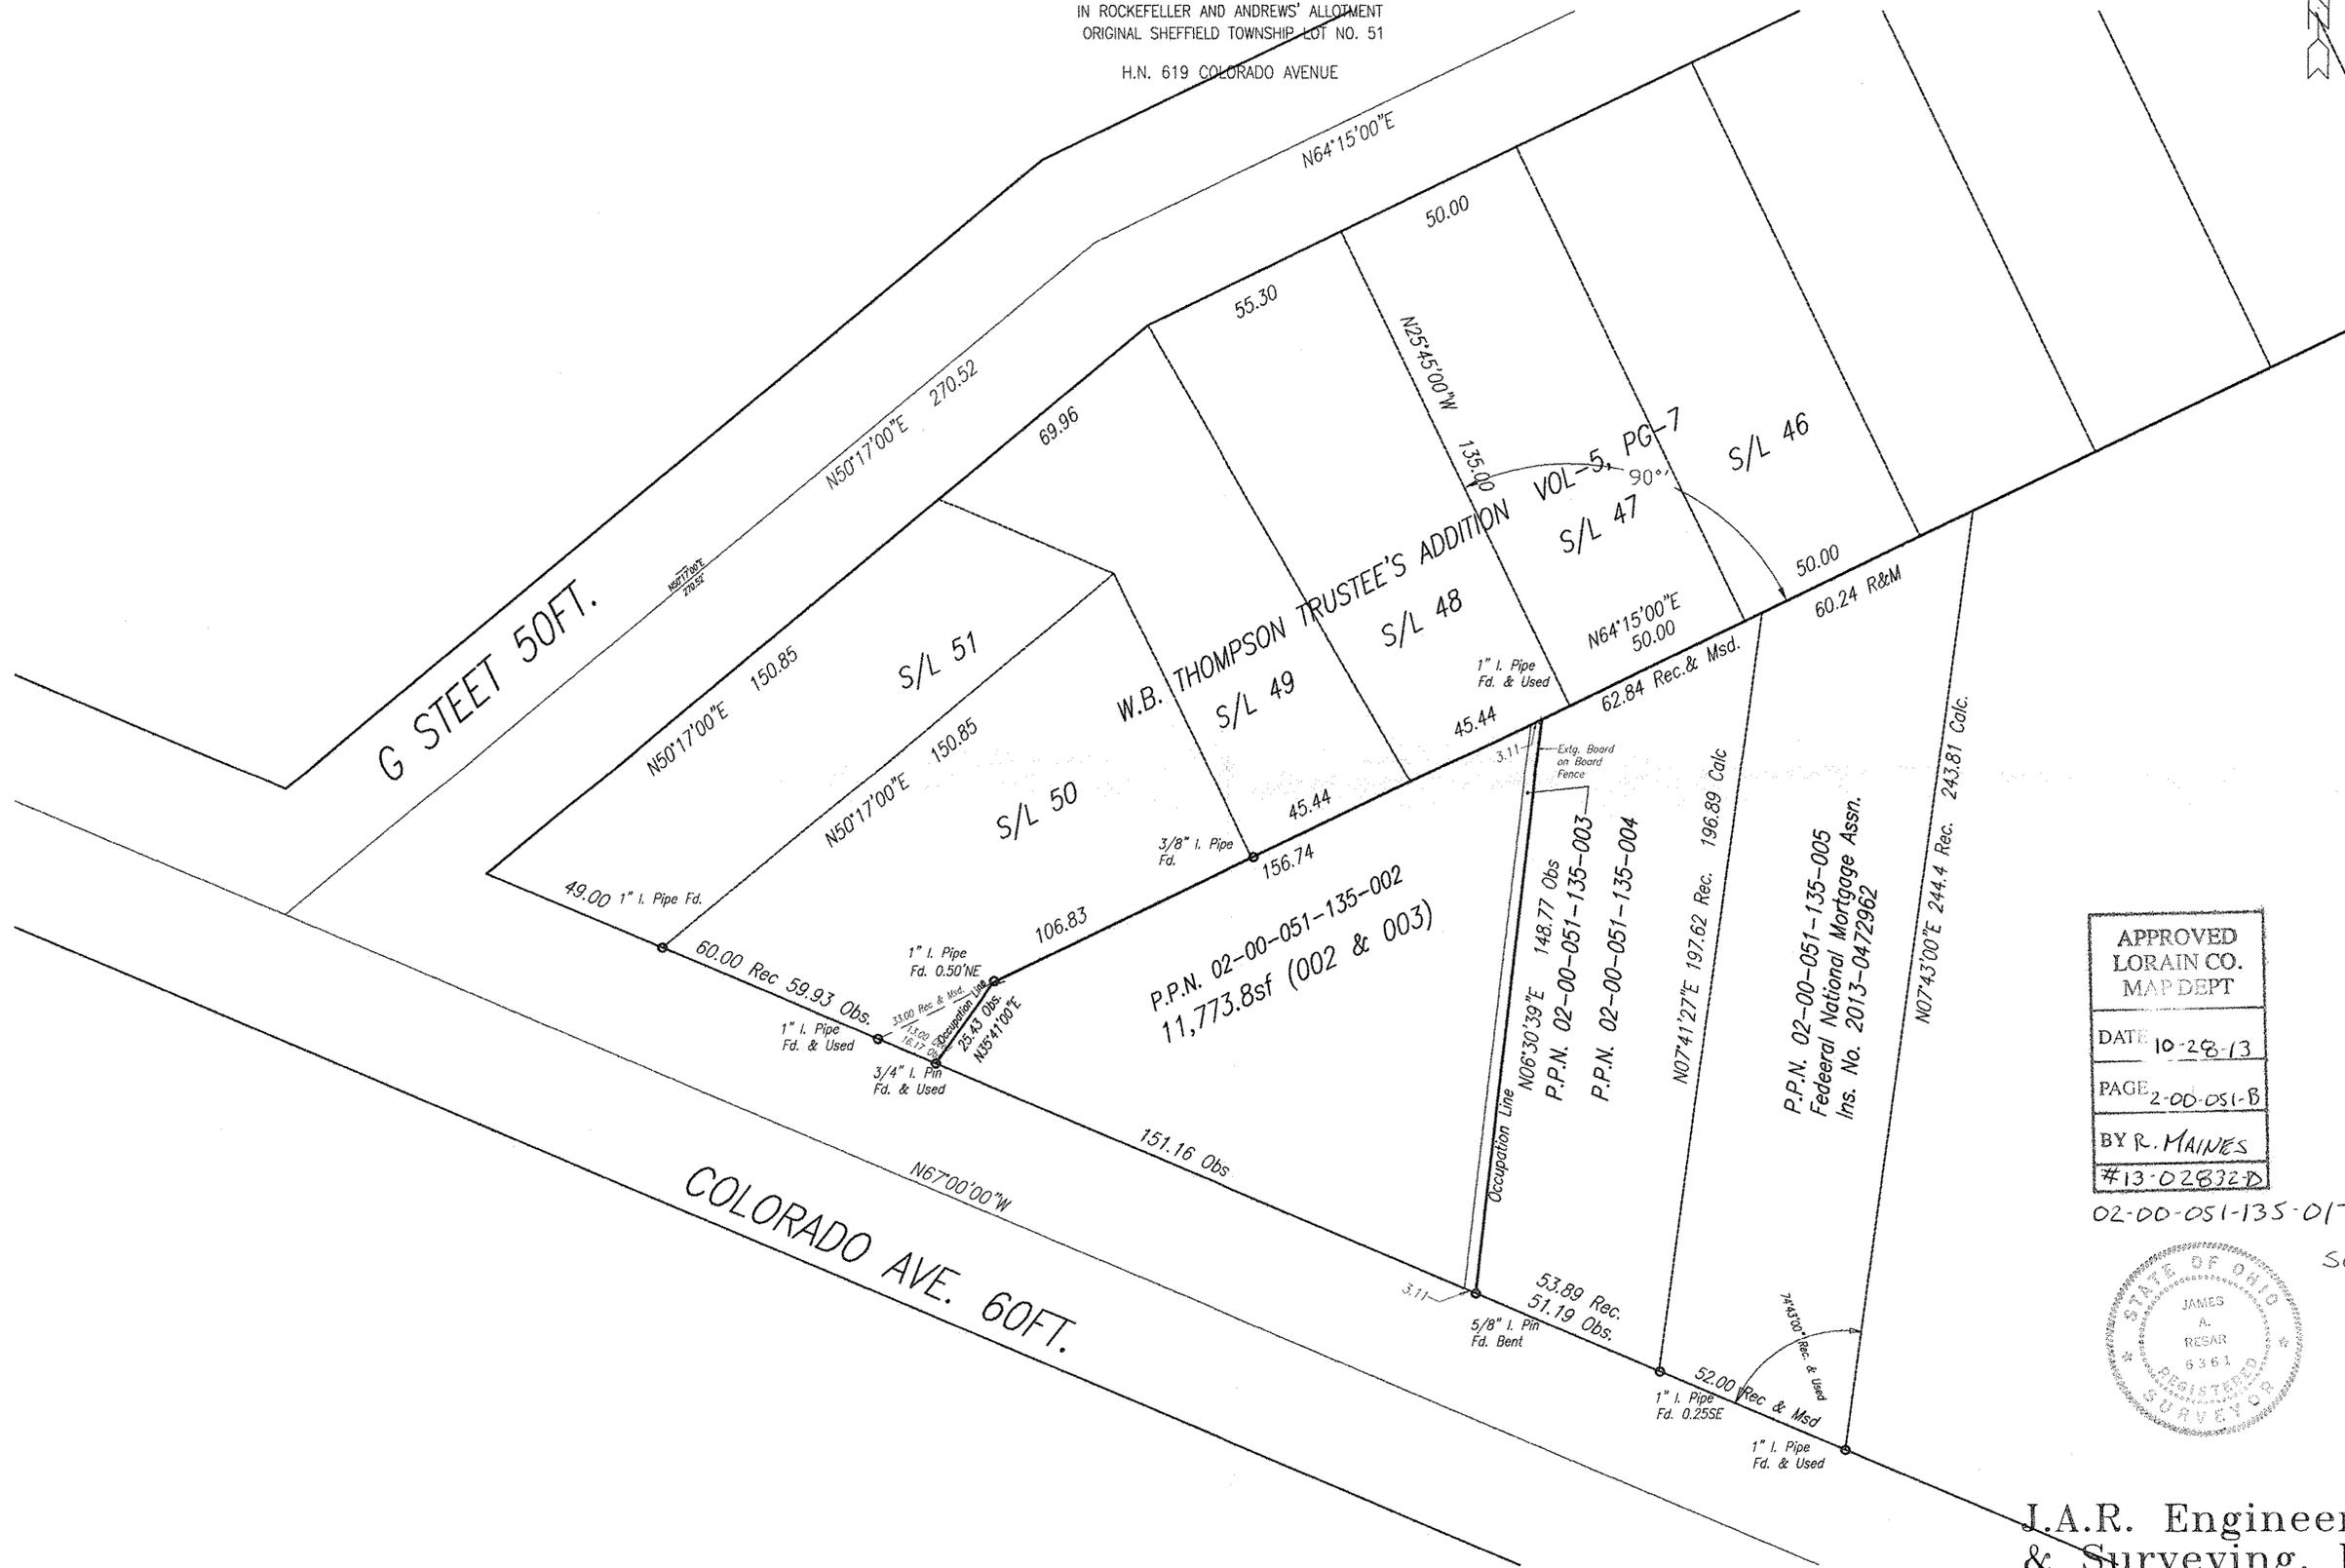

APPROVED
LORAIN CO.
MAP DEPT


DATE 10-28-13

PAGE 2-00-051-B

BY R. MAINES

#13-02832-D

02-00-051-135-017

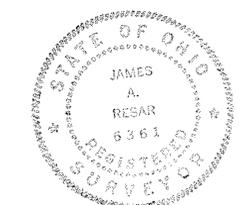

Scan# 47580

J.A.R. Engineering
& Surveying, Inc.

24629 DETROIT ROAD WESTLAKE, OHIO 44145
Phone: (440)-871-8345

C:\Documents and Settings\mrbain\My Documents\EverBank-Lorain\Map\BSE\DWG_18224_10/16/2013 9:59:18 AM.dwg