

# MAP OF SURVEY FOR JOHN A. & MARY M. DEMBOSKI

SITUATED IN THE TOWNSHIP OF COLUMBIA, COUNTY OF LORAIN, STATE OF OHIO  
AND KNOWN AS BEING PART OF ORIGINAL COLUMBIA TOWNSHIP LOT No. 52

## The Western Reserve Surveying Co.

Cleveland, Ohio

OCTOBER 29, 2013  
THIS SURVEY CONFORMS TO ARTICLE 4733.37  
OF THE OHIO ADMINISTRATIVE CODE

BEARING REFERENCE  
COLUMBIA ROAD  
S 09°21'00" E

● INDICATES A 5/8" IRON PIN  
WITH CAP SET, UNLESS NOTED

P.P.No. 12-00-052-000-017  
WALLACE E. WENDT TRUST "B"  
SUSAN M. WENDT, TRUSTEE  
FILE # 2009-0297921  
L.C.D.R.

APPROVED  
LORAIN CO.  
MAP DEPT

DATE 10-30-13

PAGE 12-F



BY R. MAINES

# 13-02830-A

7.0250 Ac.

P.P.No. 12-00-052-000-016  
JOHN A. & MARY M. DEMBOSKI  
FILE # 2012-0404438  
L.C.D.R.

HN 18399

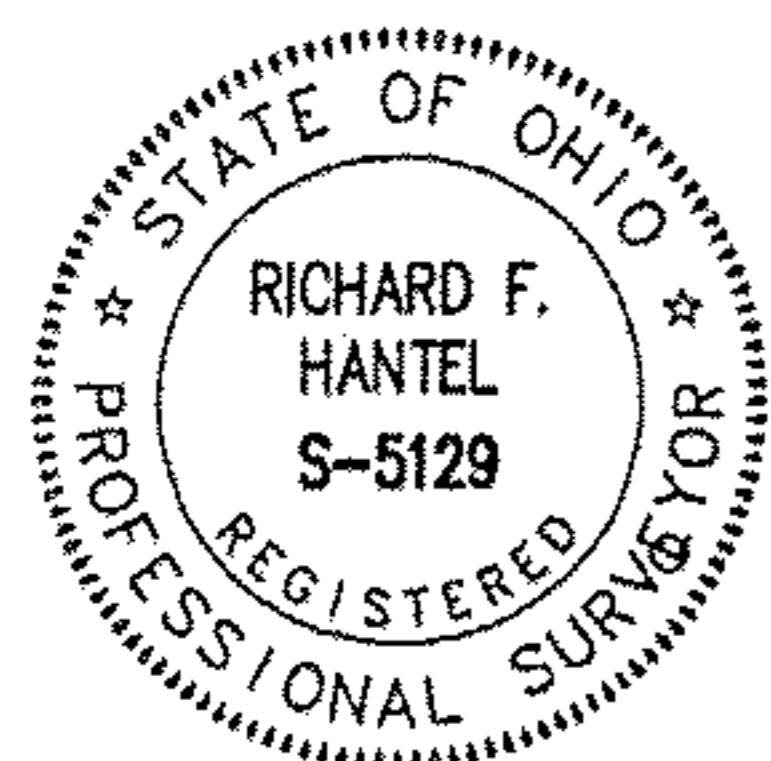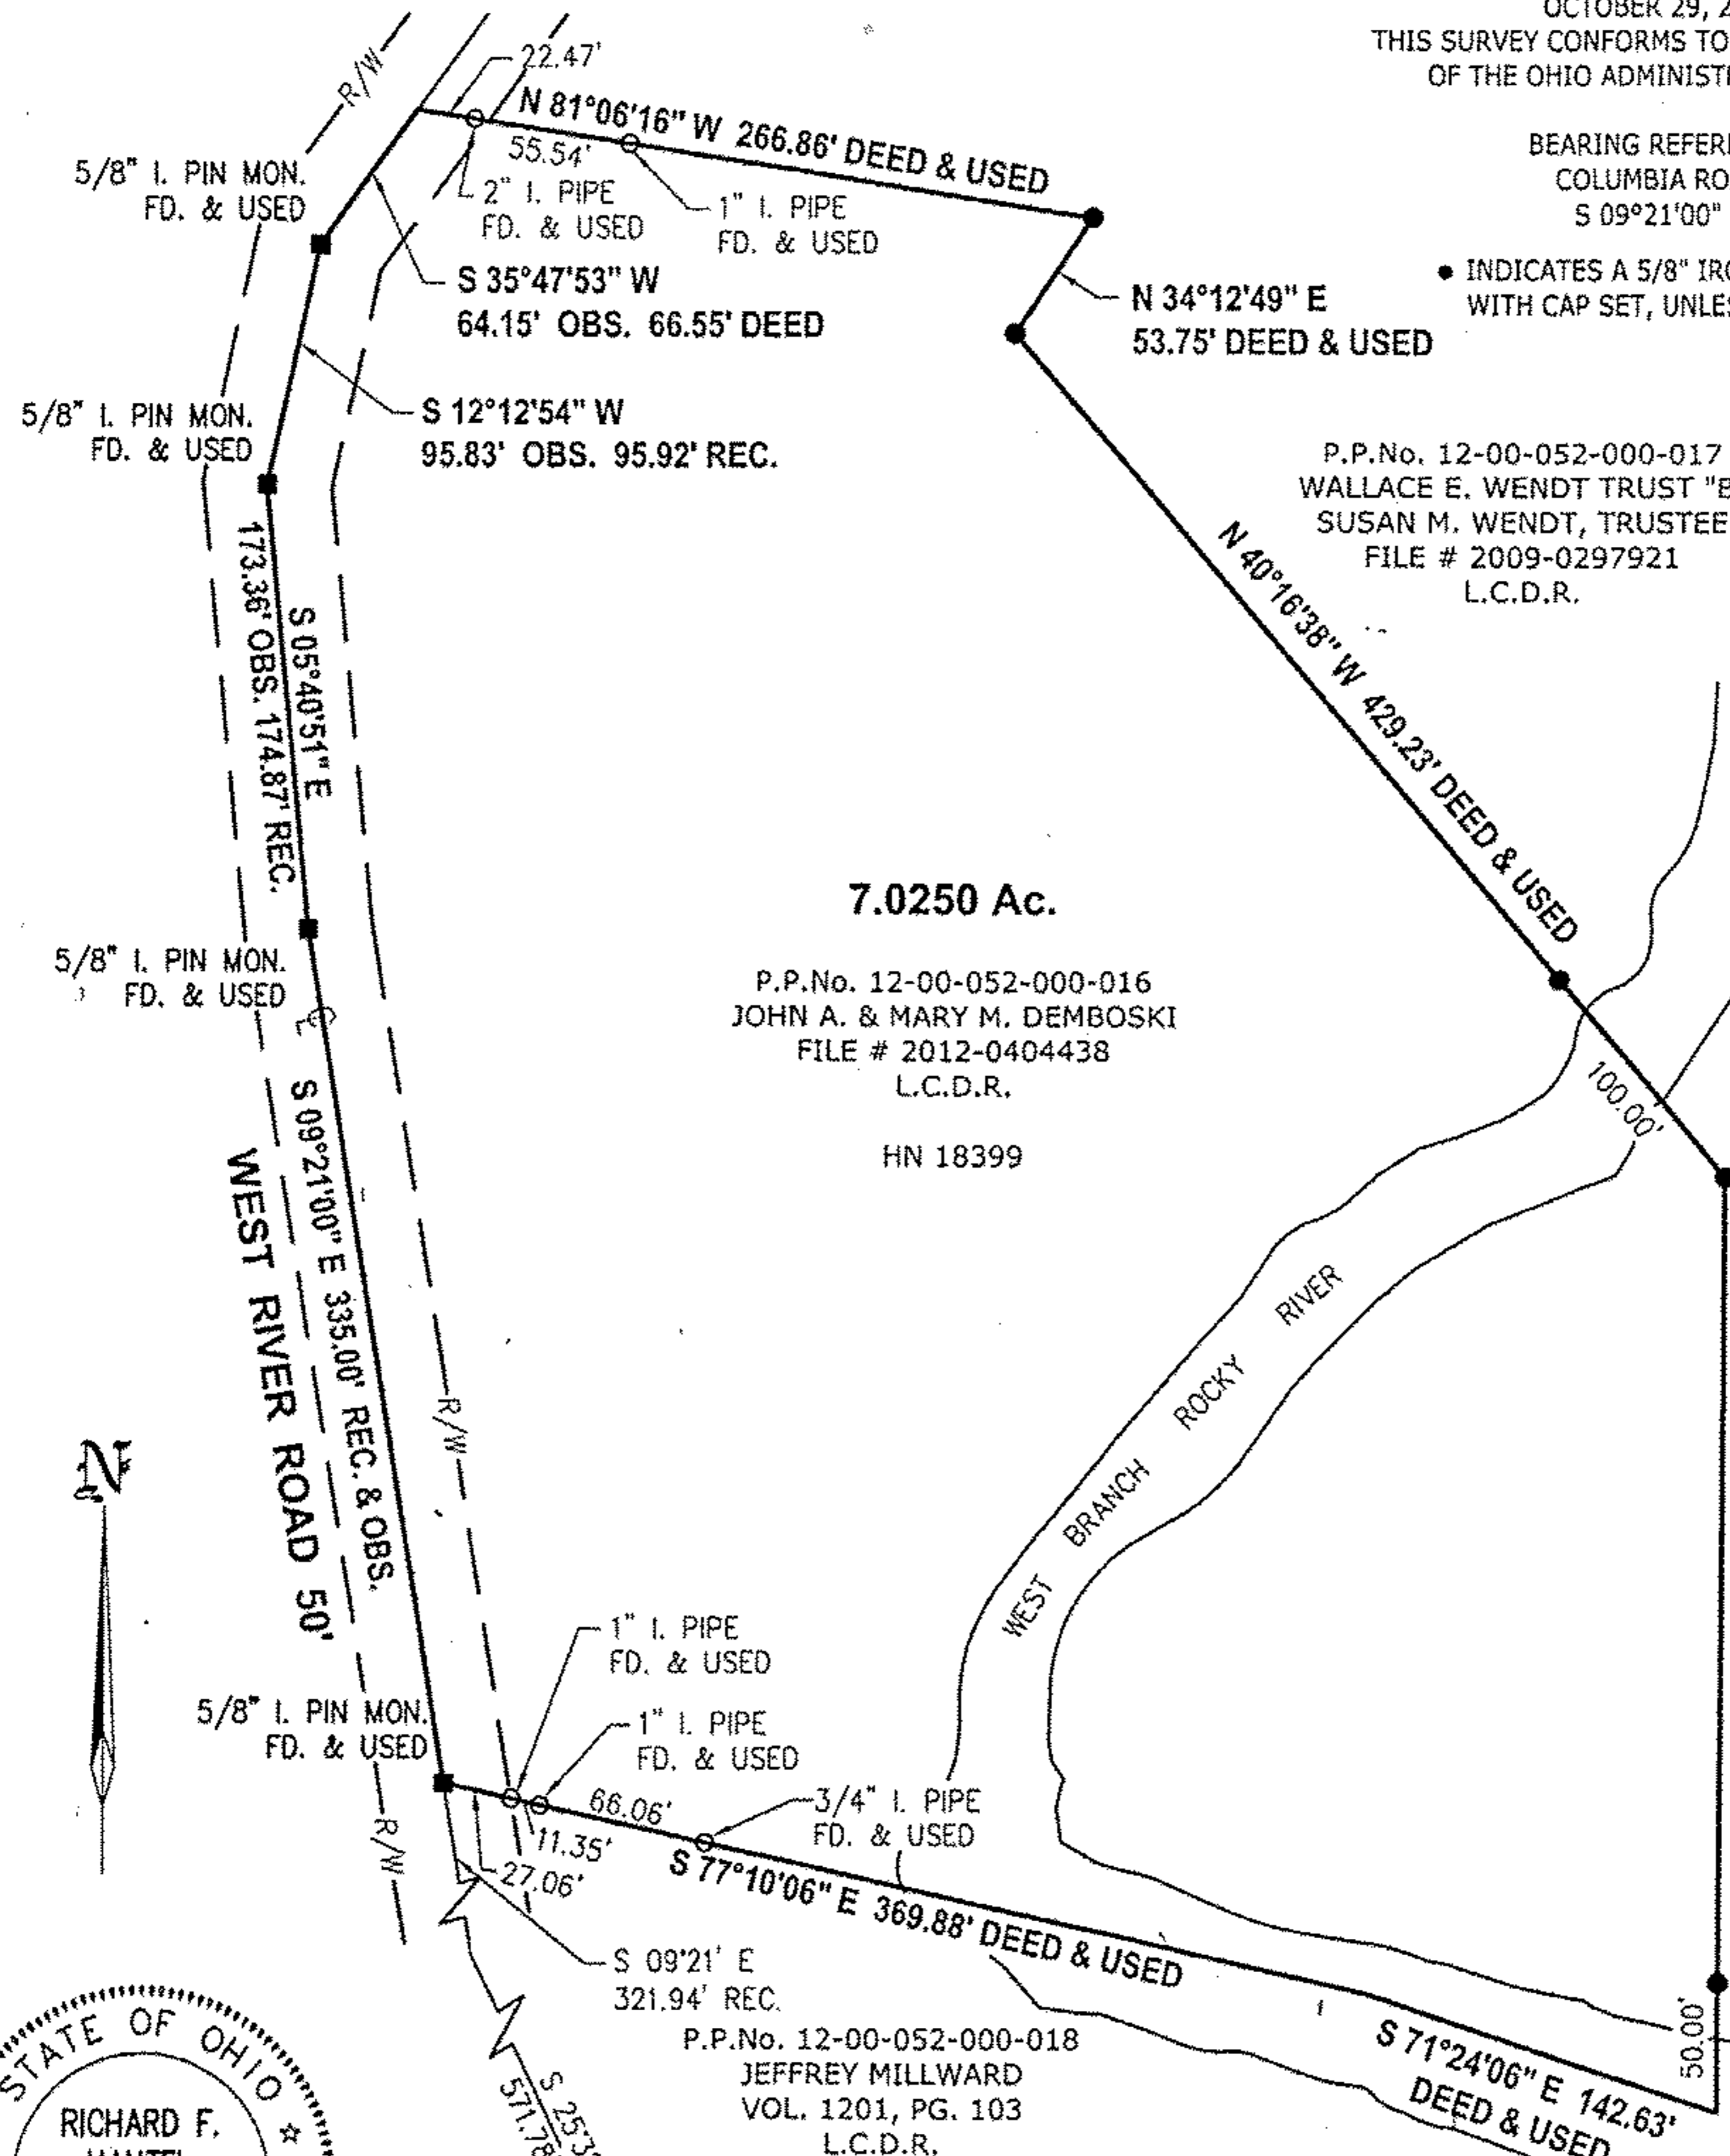

O.L. 52  
O.L. 51

