18-00-021-108-001
-003
18-00-021-C -004
SCAN# 47655 005
006
007
008
009

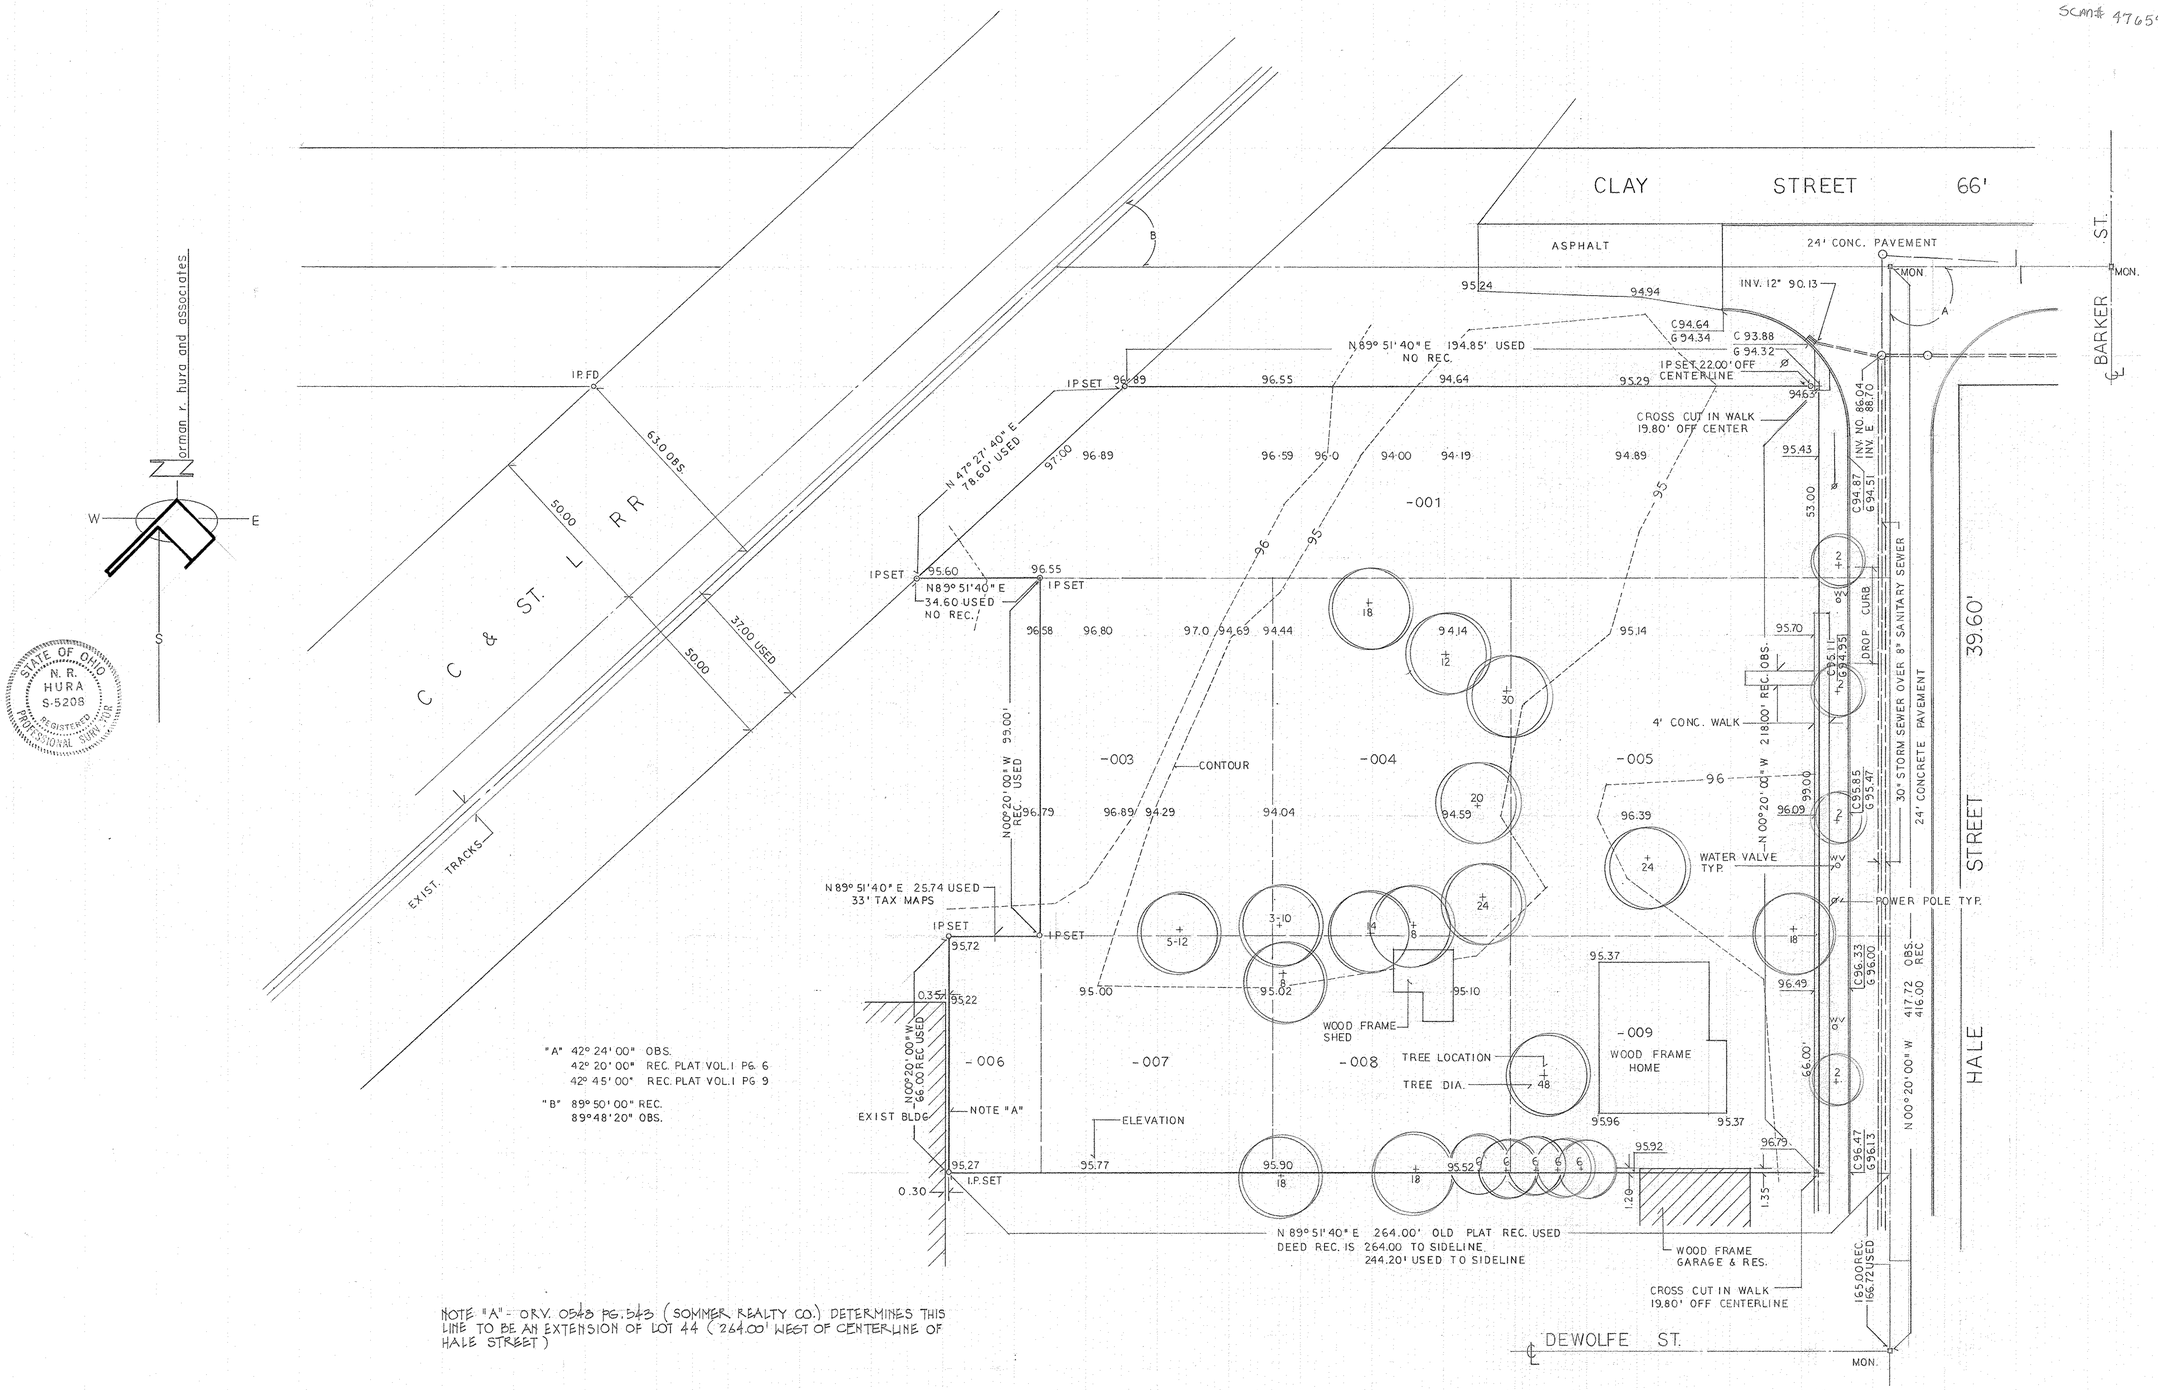

NOTE "A" - O.R.V. 0548 PG. 543 (SOMMER REALTY CO.) DETERMINES THIS LINE TO BE AN EXTENSION OF LOT 44 (264.00' WEST OF CENTERLINE OF HALE STREET)

APRIL 1993
SCALE 1" = 20'-0"

OUTLINE — TOPOGRAPHIC SURVEY
PPN 18 00 021 108 001, 003, 004, 005
006, 007, 008, 009

FOREST CITY TECHNOLOGIES
WELLINGTON - OHIO

5026