06-24-006-500-002
06-24-005-500-001
06-24-004-500-001
Scan # 47659

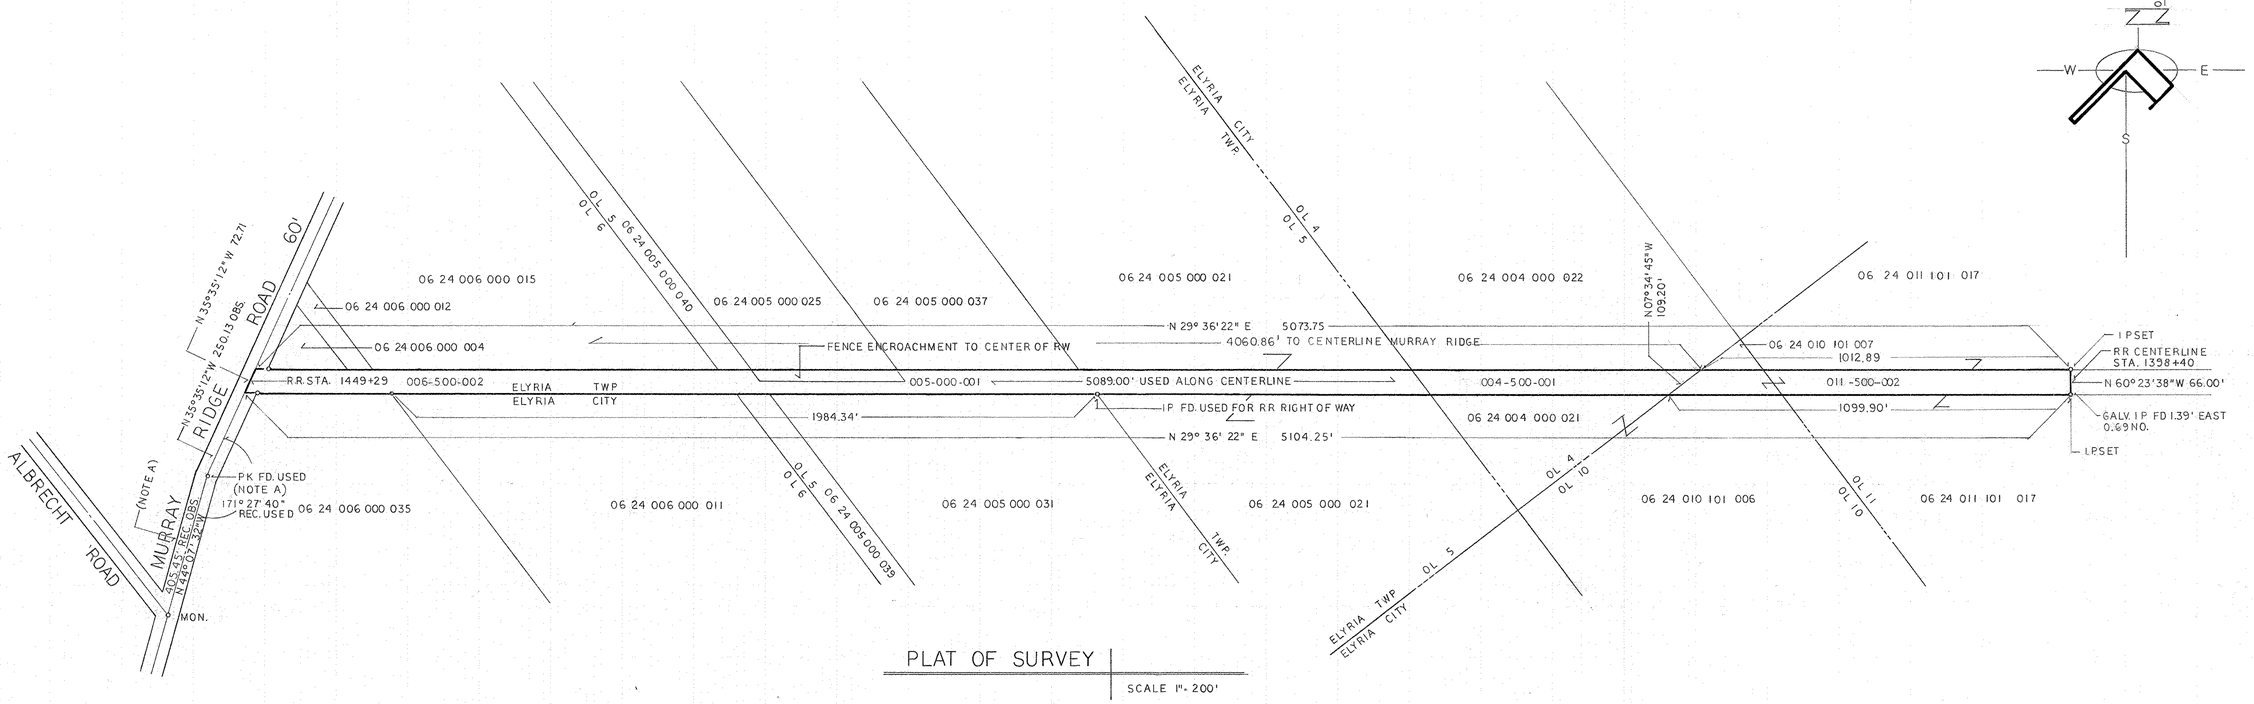

PLAT OF SURVEY

SCALE 1" = 200'

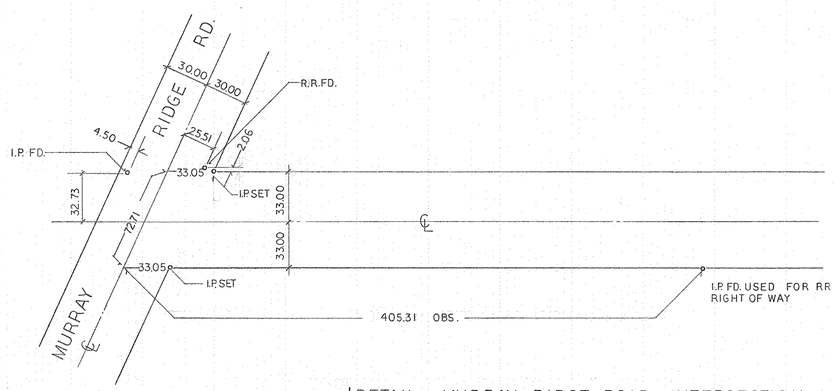

DETAIL - MURRAY RIDGE ROAD INTERSECTION

SCALE 1" = 50'-0"

NOTE A — CENTERLINE RECORD DATA FROM CITY OF ELYRIA ENGINEERING DEPT.

LISTING OF ABUTTING PROPERTY OWNERS

	06-24-006-000-004	Richard A. & Wendy D. Kobasic	Vol. 188	Pg. 766
	06-24-006-000-012	City of Elyria	Vol.1081	Pg. 162
	06-24-006-000-013	Mary C. Pavlenda & John P. Vanco	Vol. 844	Pg. 341
	06-24-006-000-040	Mary C. Pavlenda & John P. Vanco	Vol. 844	Pg. 341
	06-24-005-000-025	Herman C. & Juliette Larkins	Vol. 244	Pg. 429
	06-24-005-000-037	Kenneth E.Crawford & Shelvie J. CoTrustee	Vol. 399	Pg. 310
	06-24-005-000-021	Kenneth E. Crawford & Shelvie J. CoTrustee	Vol. 399	Pg. 308
06-24-010-101-007 +	06-24-004-000-022	Robert W. & Emma M. Grobe	Vol. 661	Pg. 29
	06-24-011-101-017	John J. Jr. & Ann M. Lasko	Vol. 552	Pg. 525
06-24-004-000-21 +	06-24-010-101-006	Aztec Catalyst Co.	Vol.1309	Pg. 468
	06-24-005-000-031	City of Elyria	Vol. 904	Pg. 345
	06-24-005-000-039	City of Elyria	Vol.1081	Pg. 162
	06-24-006-000-011	City of Elyria	Vol.1081	Pg. 162
	06-24-006-000-035	Fred Wallhead Etal	Vol. 172	Pg. 146

ACREAGE BREAKDOWN BY PPN

06-24-006-500-002	2.17 acres
06-24-005-500-001	2.83 acres
06-24-004-500-001	1.11 acres
06-24-011-500-002	1.6006 acres
TOTAL	7.7106 acres

ACREAGE BREAKDOWN BY LOT

LOT NO.	ACRES
4	1.11
5	2.83
6	2.17
10	0.38
11	1.2206
TOTAL	7.7106 ACRES

STATE OF OHIO
NORMAN R. HURA
HURA
S-5208
Registered
PROFESSIONAL SURVEYOR

MARCH 1993

SURVEY OF PPN'S 06-24-006-500-002
06-24-005-500-001, 06-24-004-500-001
AND LOT SPLIT FROM 06-24-011-500-002
PART OF ORIGINAL LOTS 4-5-6-10-11 WEST OF
RIVER ELYRIA TOWNSHIP LORAIN CO. OHIO

LORAIN COUNTY METROPOLITAN PARK DISTRICT

5022