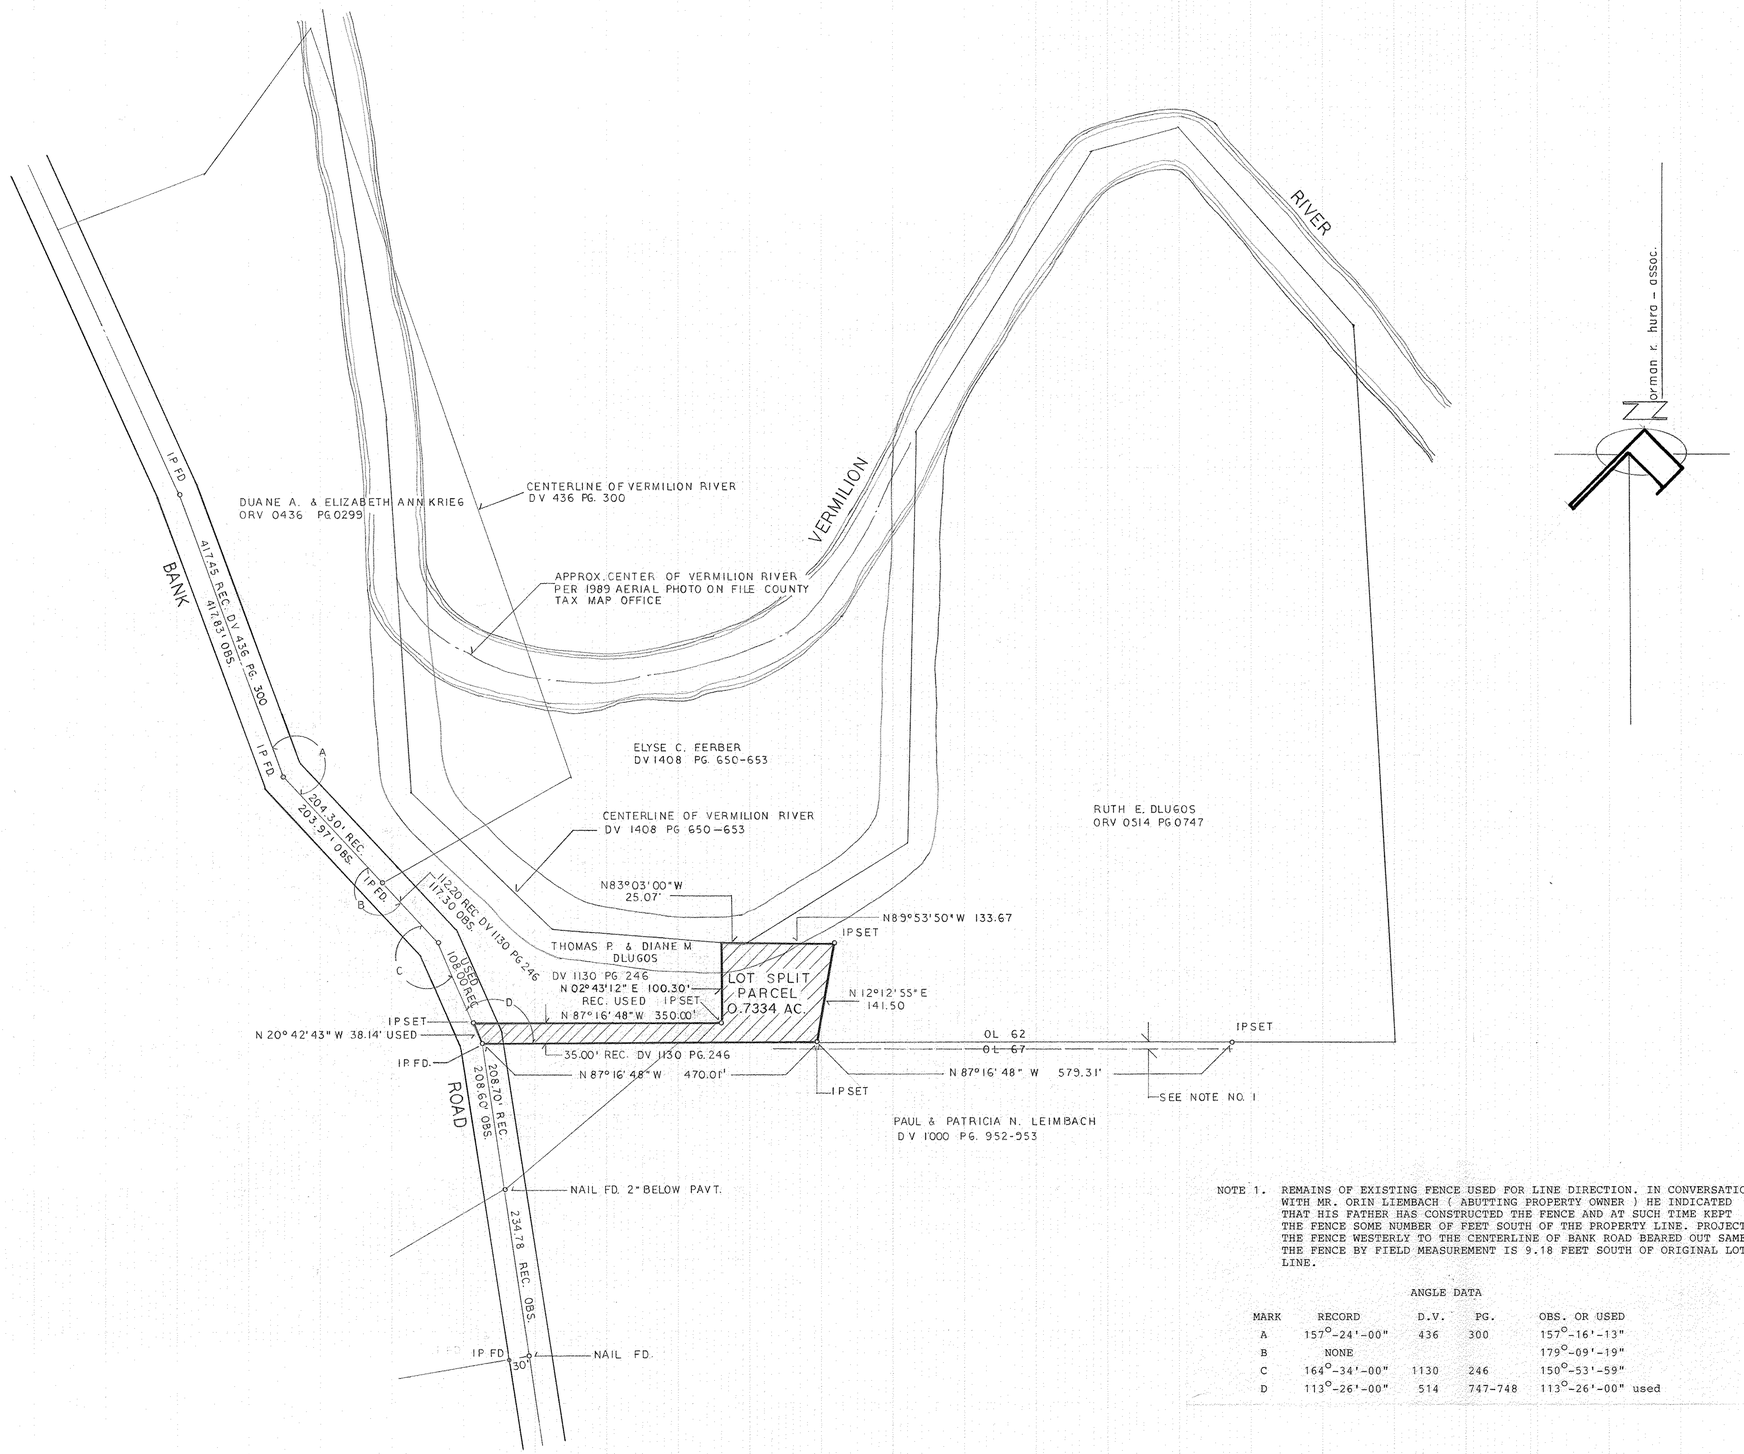

NOTE 1. REMAINS OF EXISTING FENCE USED FOR LINE DIRECTION. IN CONVERSATION WITH MR. ORIN LIEMBACH (ABUTTING PROPERTY OWNER) HE INDICATED THAT HIS FATHER HAS CONSTRUCTED THE FENCE AND AT SUCH TIME KEPT THE FENCE SOME NUMBER OF FEET SOUTH OF THE PROPERTY LINE. PROJECTING THE FENCE WESTERLY TO THE CENTERLINE OF BANK ROAD BEARED OUT SAME. THE FENCE BY FIELD MEASUREMENT IS 9.18 FEET SOUTH OF ORIGINAL LOT LINE.

ANGLE DATA

MARK	RECORD	D.V.	PG.	OBS. OR USED
A	157°-24'-00"	436	300	157°-16'-13"
B	NONE			179°-09'-19"
C	164°-34'-00"	1130	246	150°-53'-59"
D	113°-26'-00"	514	747-748	113°-26'-00" used

STATE OF OHIO
N. R. HURA
S-5208
REGISTERED PROFESSIONAL SURVEYOR

AUGUST 1993
SCALE 1"=100'

RUTH E DLUGOS

LOT SPLIT FROM PPN 01-00-062-000-007
PART OF ORIGINAL LOT NO. 62 BROWNHELM
TOWNSHIP — LORAIN COUNTY-OHIO

LORAIN COUNTY METROPOLITAN PARK DISTRICT

01-00-062-000-007
1-J SCAN # 17668

5041