05-00-041-110-057, 052, 059
SCAN # 47671

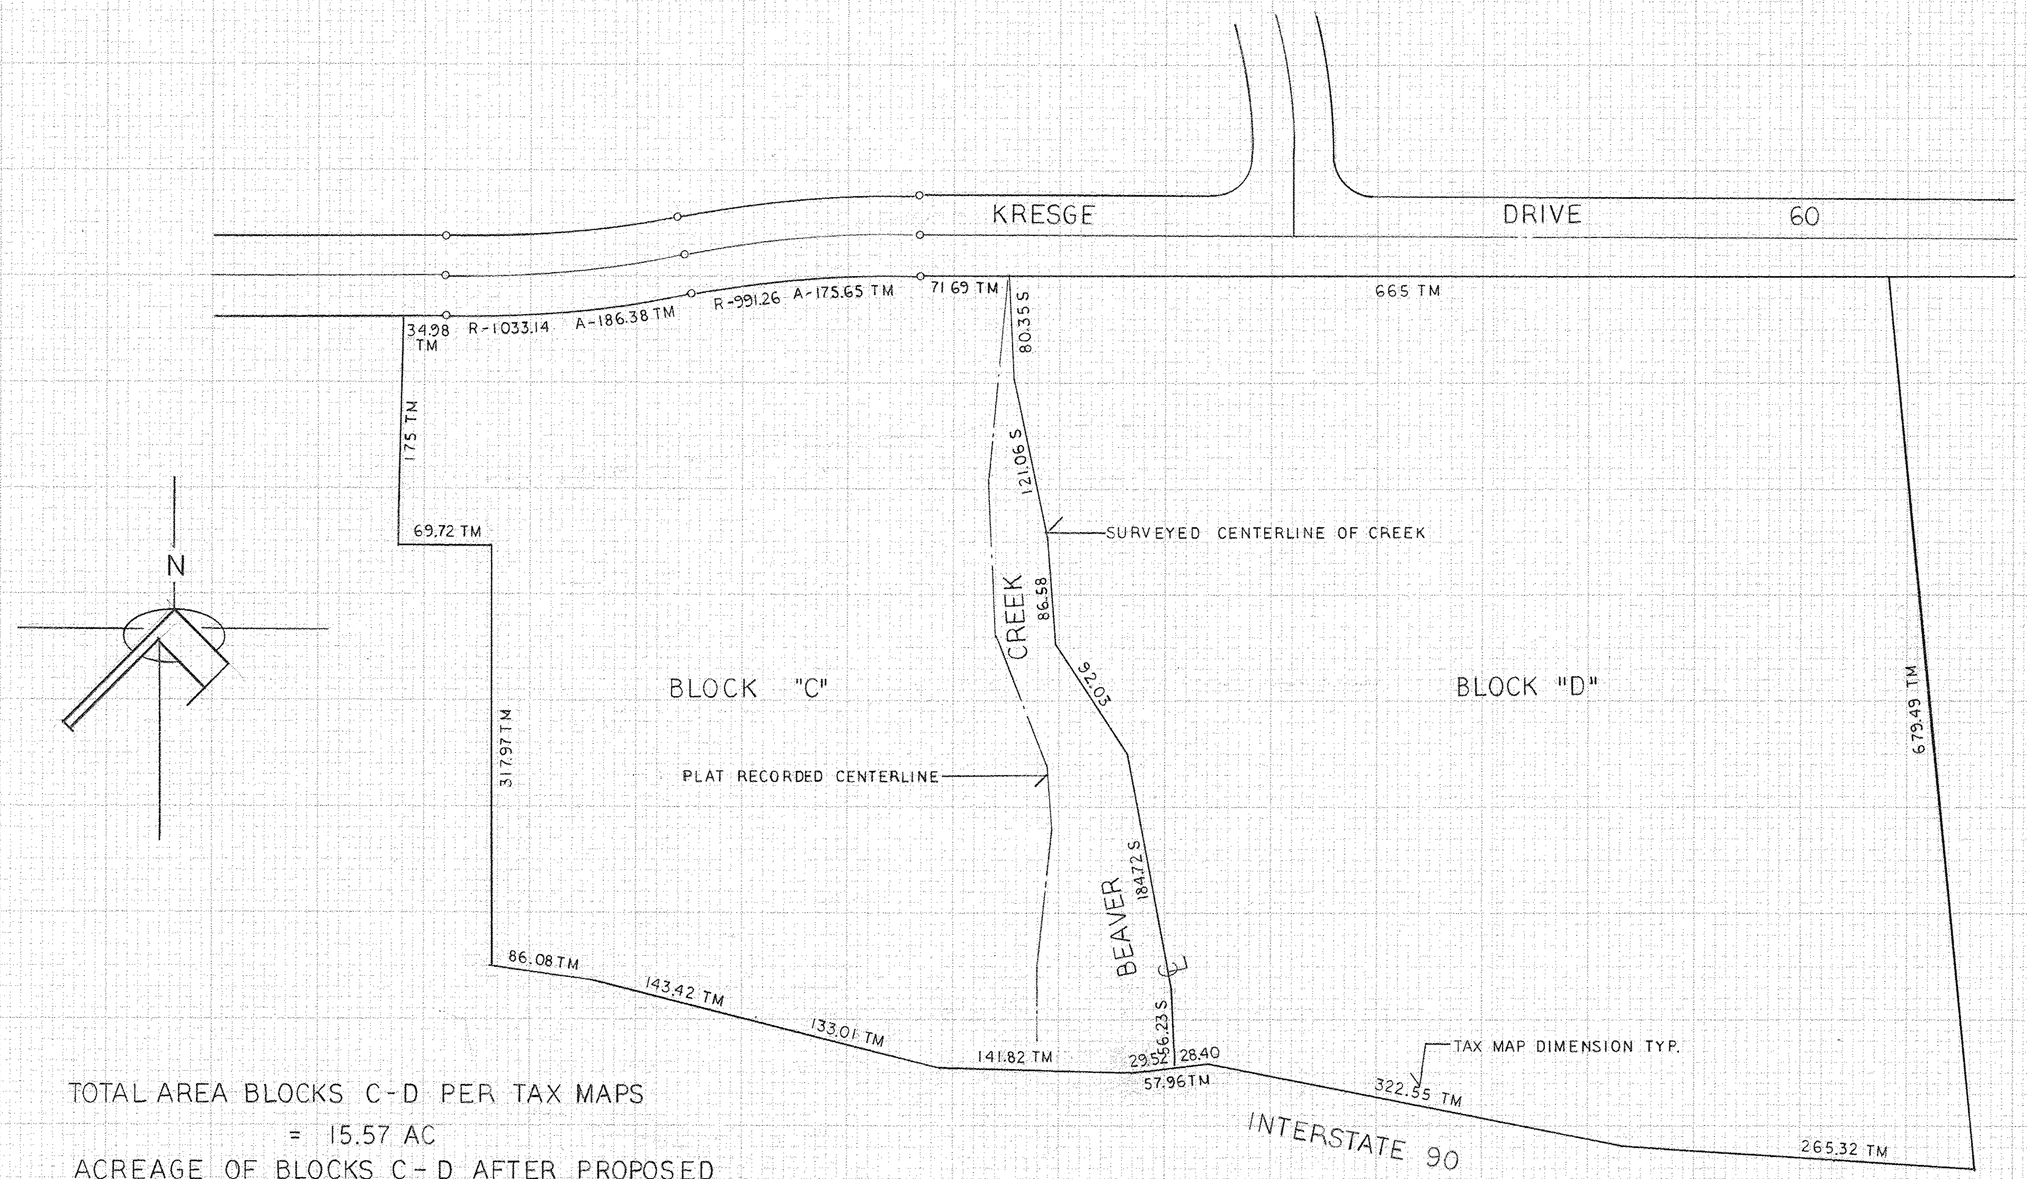

TOTAL AREA BLOCKS C-D PER TAX MAPS
= 15.57 AC

ACREAGE OF BLOCKS C-D AFTER PROPOSED
CREEK CENTERLINE CORRECTION CALCULATION
BLOCK C - 6.161 AC
BLOCK D - 9.413 AC

VICTOR NARDINI	PLAT OF BLOCK C AND D OF INDEPENDENCE PARK	OCT 1994 SCALE 1"=80' NOT A PLAT OF SURVEY

5037