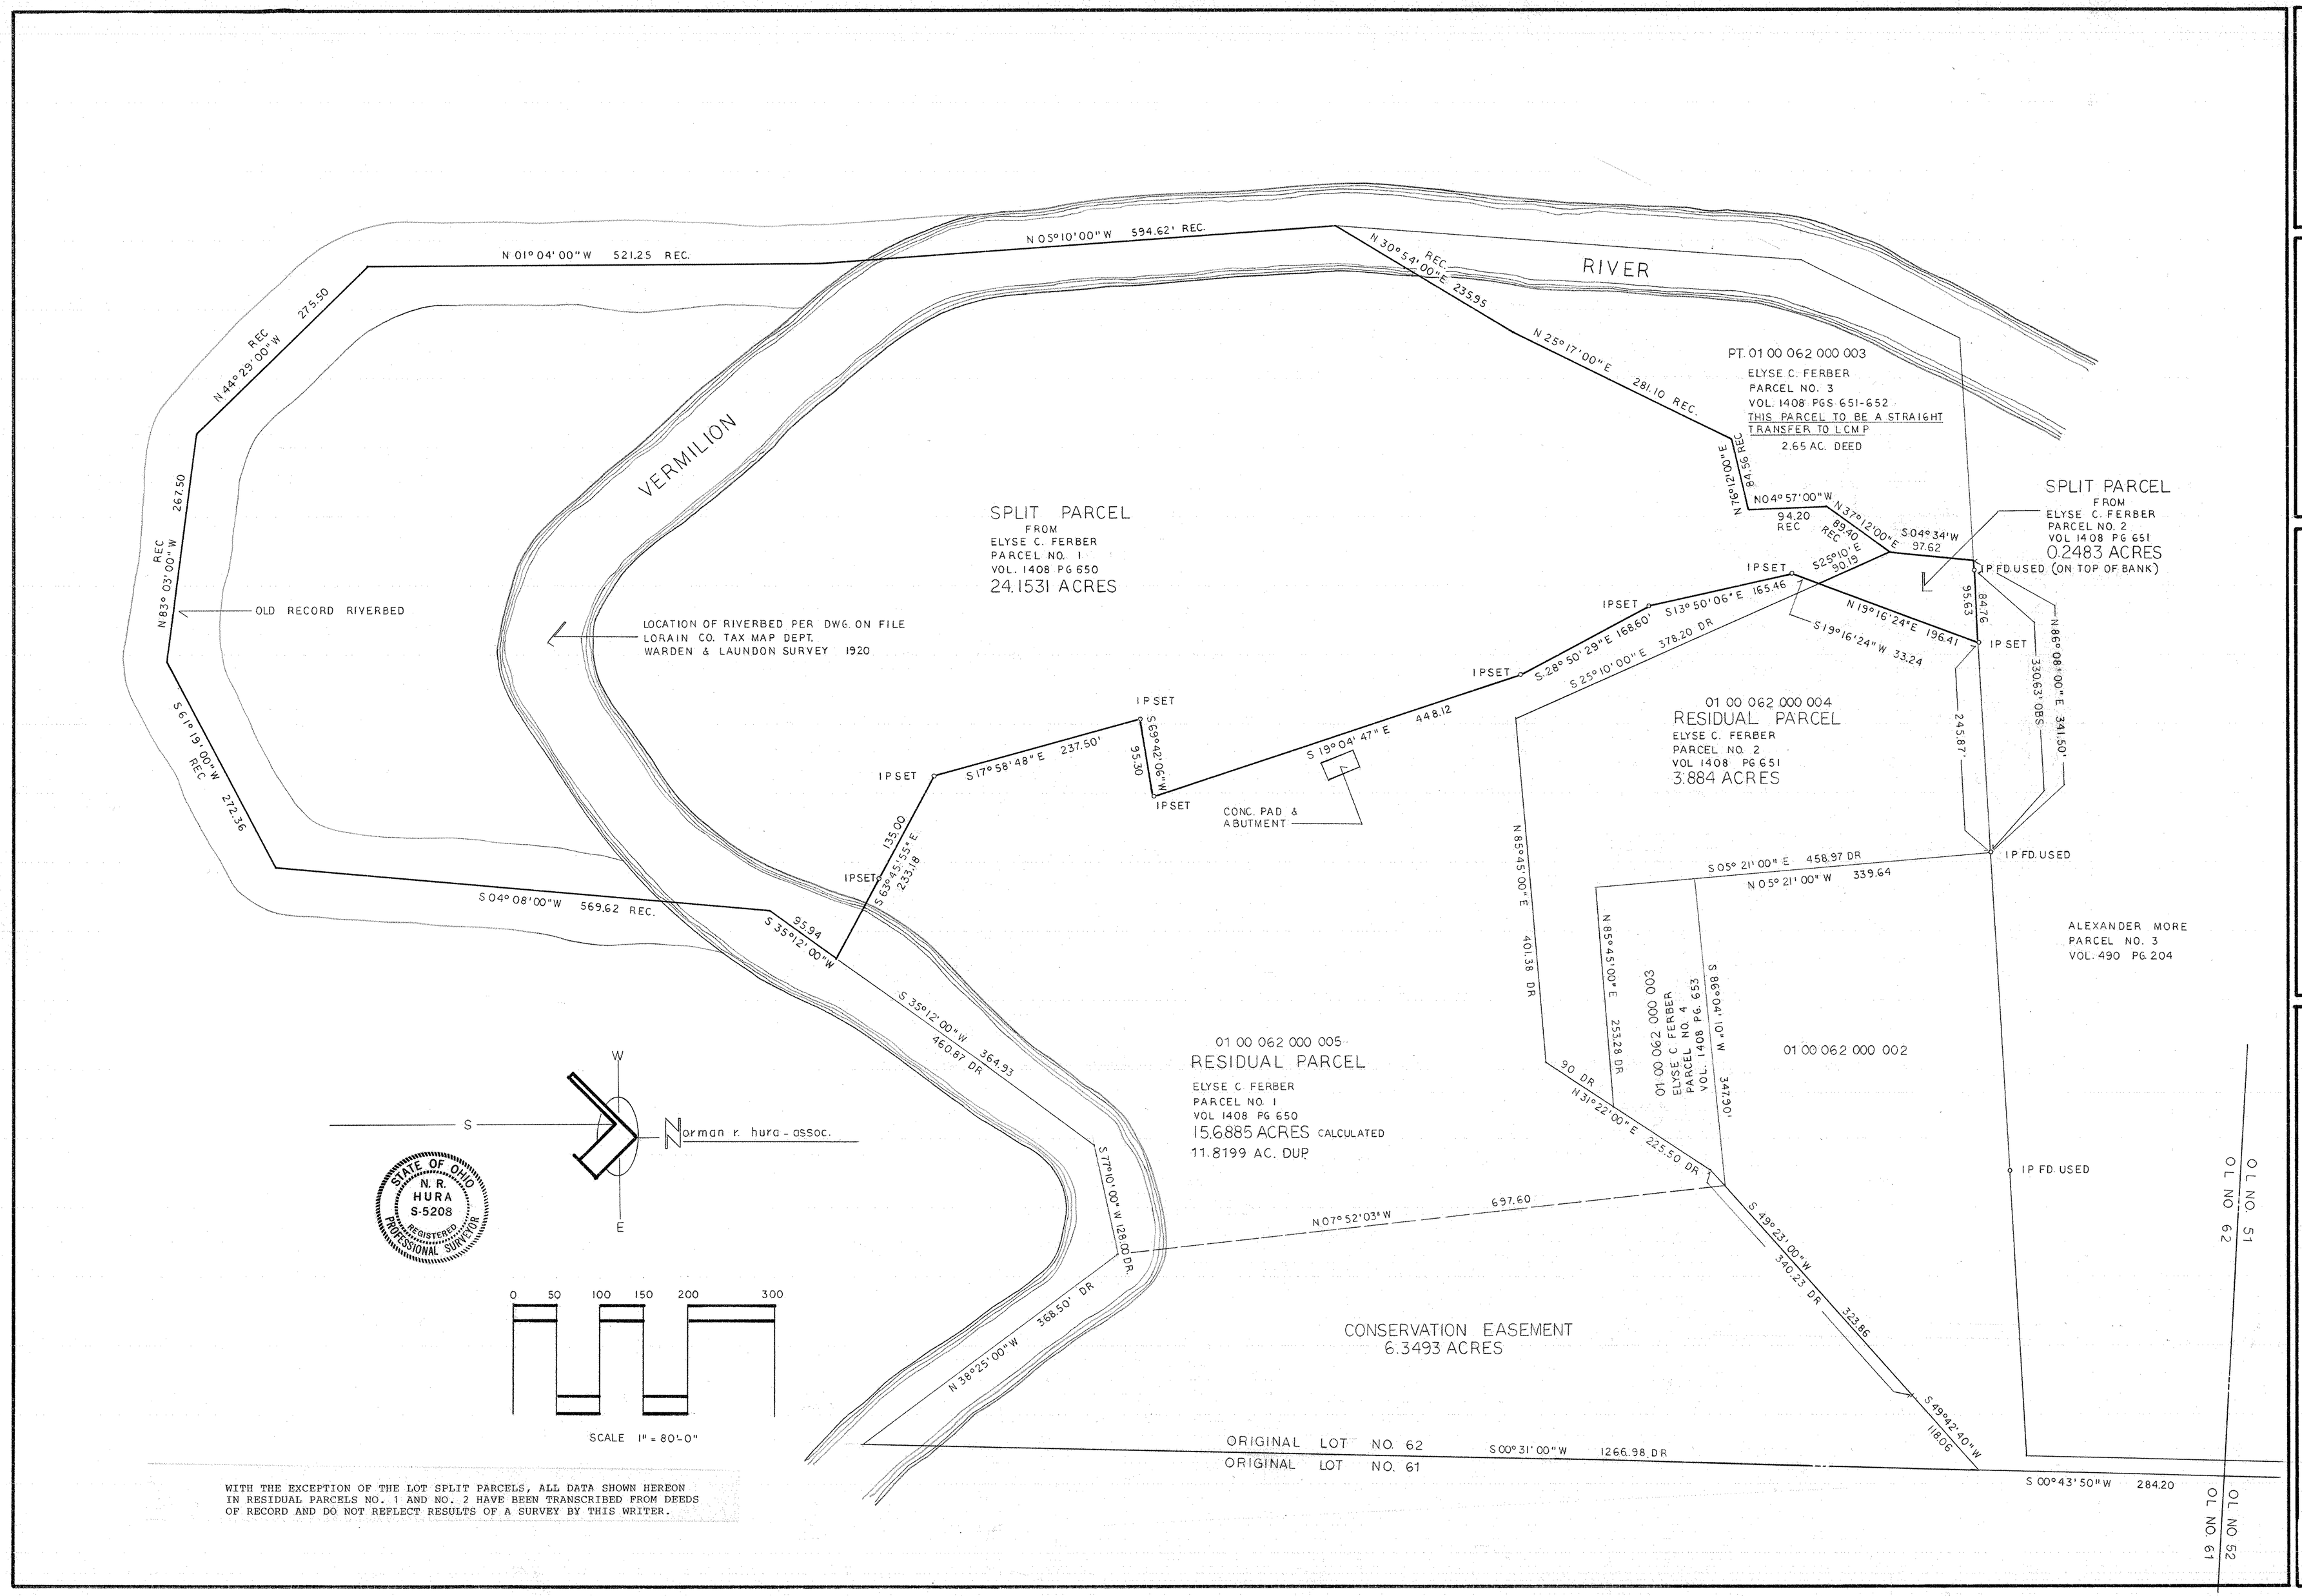

WITH THE EXCEPTION OF THE LOT SPLIT PARCELS, ALL DATA SHOWN HEREON IN RESIDUAL PARCELS NO. 1 AND NO. 2 HAVE BEEN TRANSCRIBED FROM DEEDS OF RECORD AND DO NOT REFLECT RESULTS OF A SURVEY BY THIS WRITER.

APRIL 1994

ELYSE C. FERBER

LOT SPLITS FROM PPN 01 00 062 000 004
AND PPN 01 00 062 000 005 - PART OF
ORIGINAL LOT NO. 62 - BROWNHELM TWP.
LORAIN COUNTY-OHIO

LORAIN COUNTY METROPOLITAN PARK DISTRICT

01-00-062-000-027, 025, 026, 024, 021
1-J Scan # 47672

5045