09-00-076-104-019 020
09-00-076-B Scan# 147674

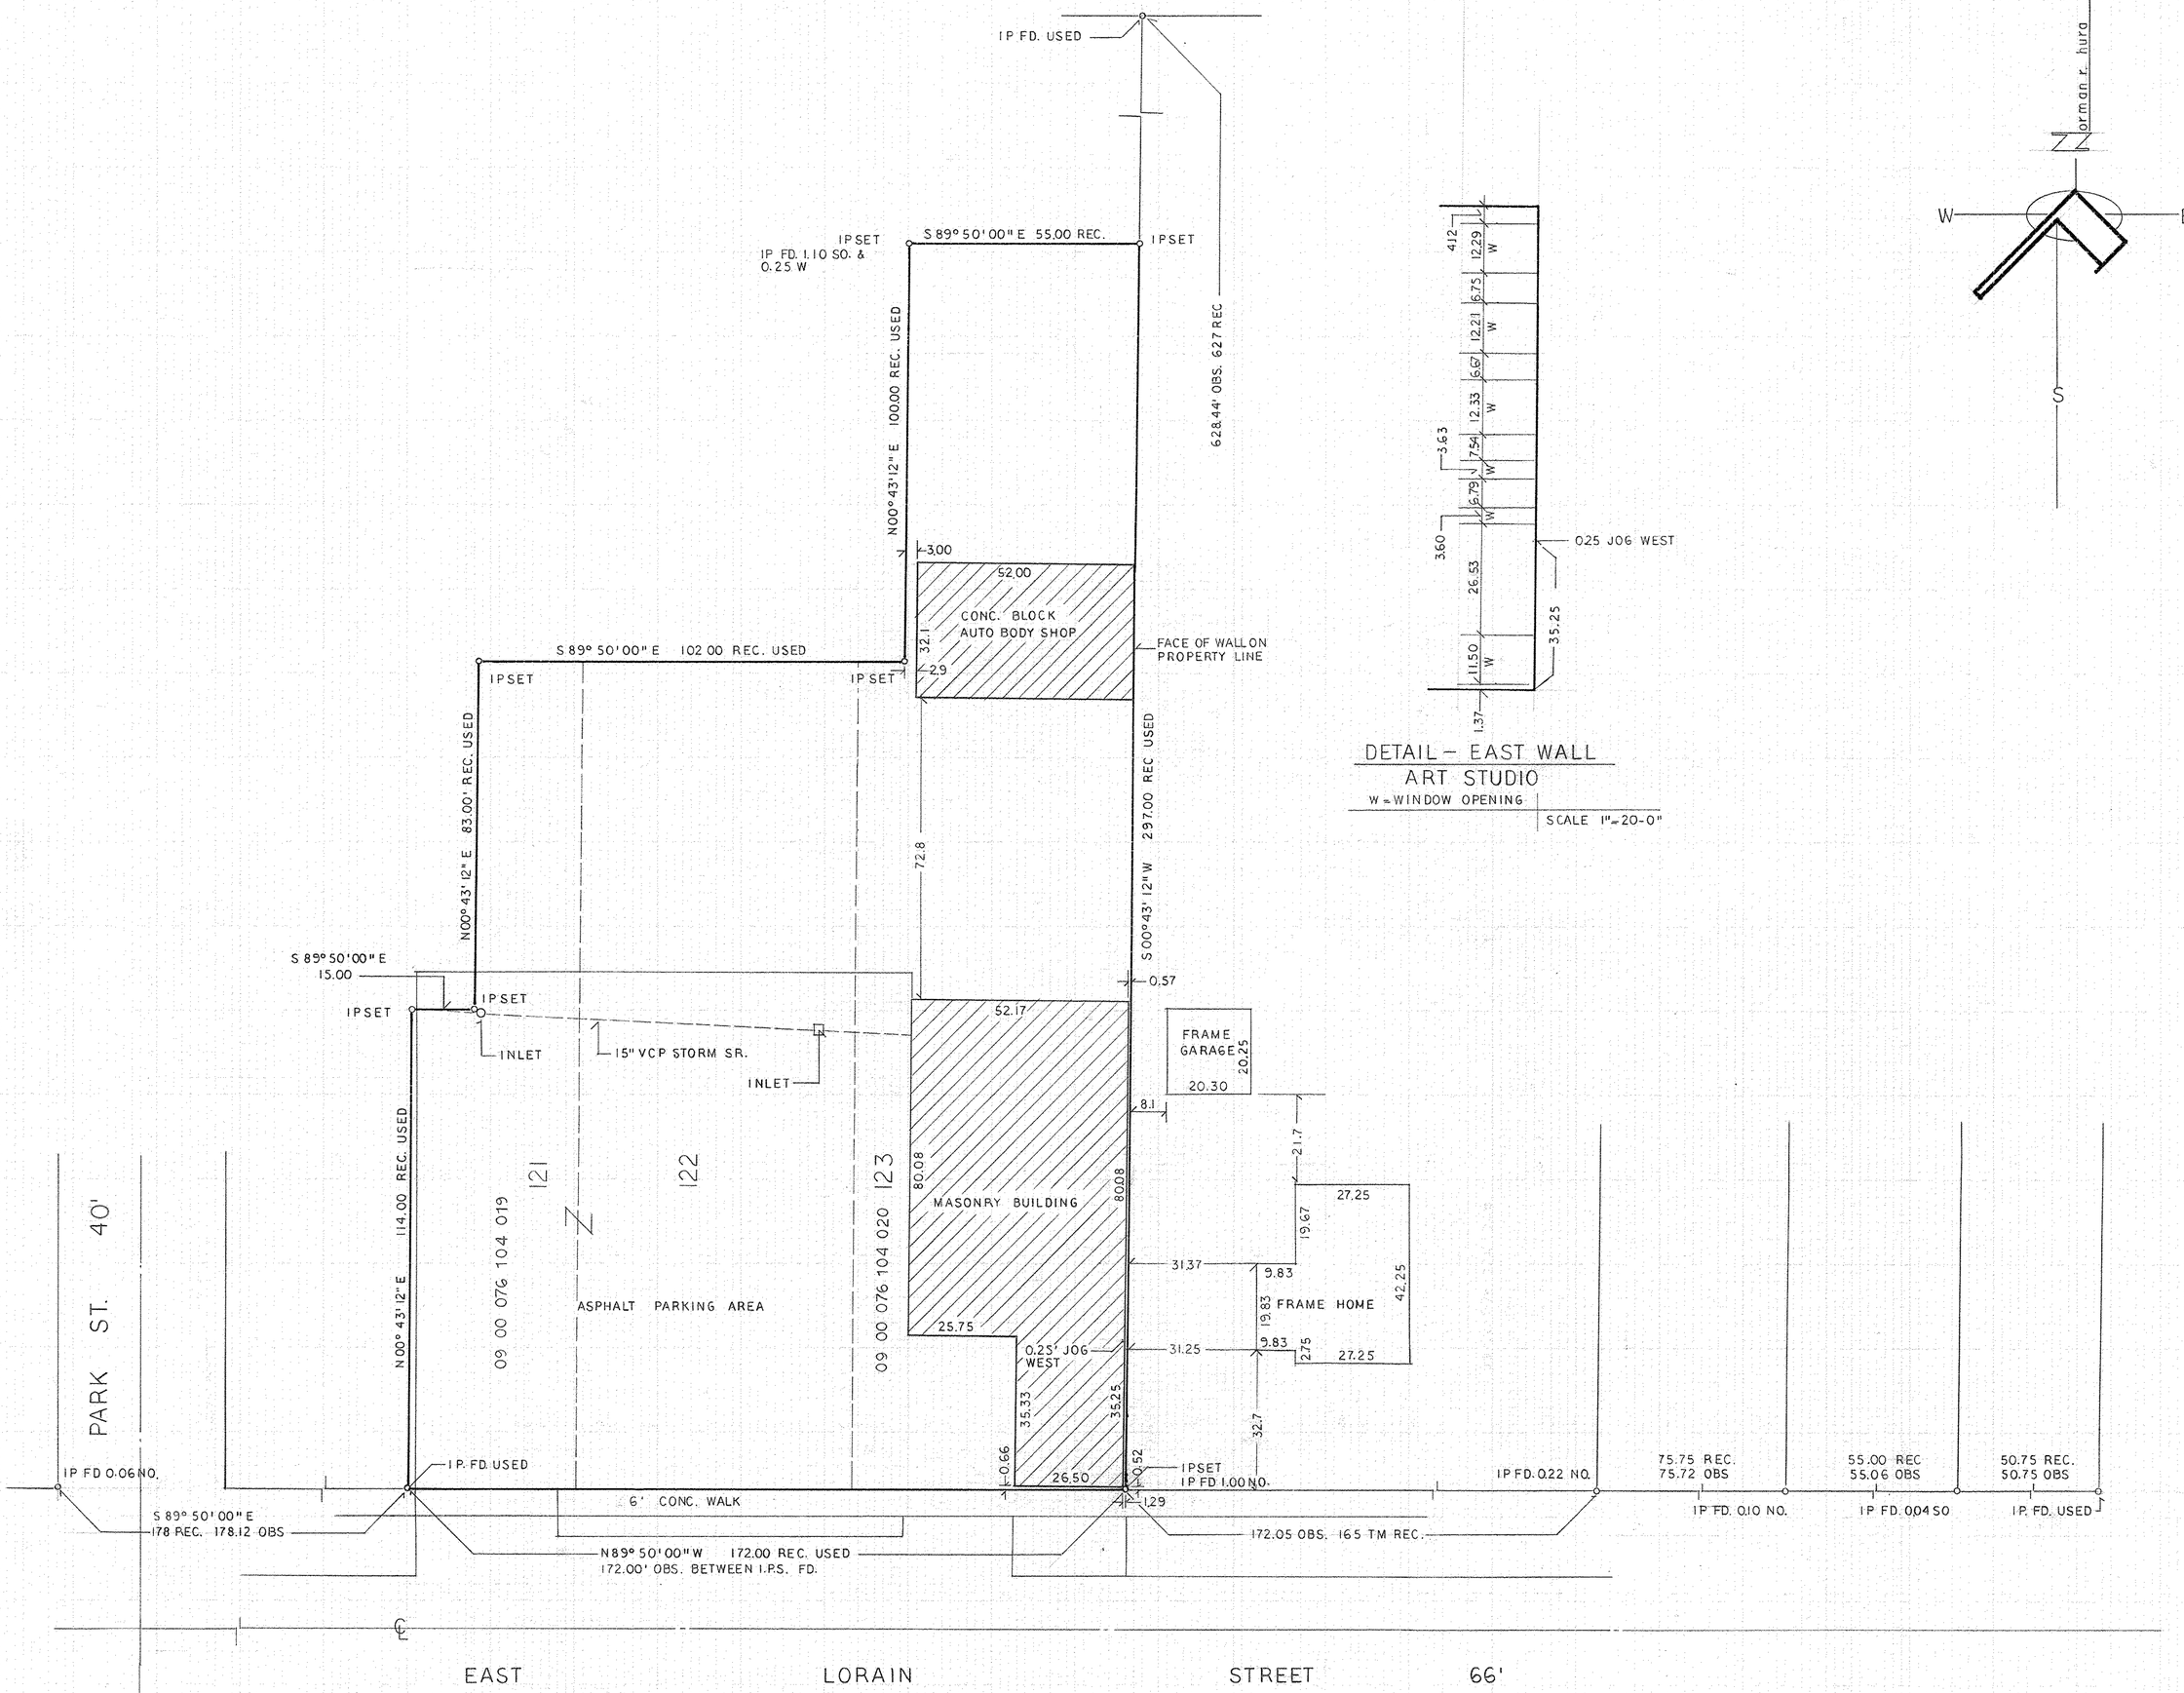

DETAIL – EAST WALL
ART STUDIO
W = WINDOW OPENING
SCALE 1" = 20'-0"

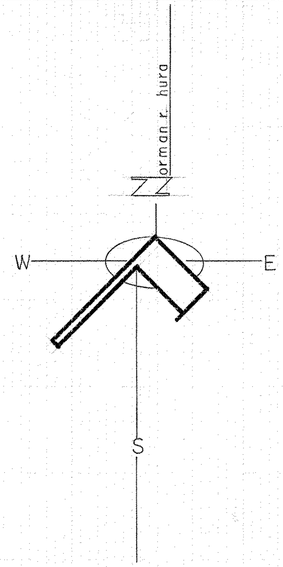

STATE OF OHIO
N. R. HURA
S-5208
REGISTERED PROFESSIONAL SURVEYOR

SEPTEMBER 1994
SCALE 1" = 20'-0"

PLAT OF SURVEY
PART OF VILLAGE LOTS 121-122-123 OF THE ORIGINAL VILLAGE PLAT OF OBERLIN
RUSSIA TOWNSHIP — LORAIN CO. OHIO

OBERLIN COLLEGE

5056