REVISIONS
OCT 26 95 ADDED EASEMENTS

SHEFFIELD TWP.
LORAIN COUNTY OHIO
SEPTEMBER 1995
SCALE - 1" = 80'-0"

OUTLINE SURVEY
PPNO.S 03 00 076 112 003
076 112 005
076 112 006
075 112 011

CONSUMERS BUILDERS SUPPLY

EASEMENTS SHOWN HEREON HAVE BEEN TRANSCRIBED FROM FIRST AMERICAN TITLE INSURANCE COMPANY COMMITMENT DATED AUGUST 22, 1995 AND PROVIDED BY OWNER.

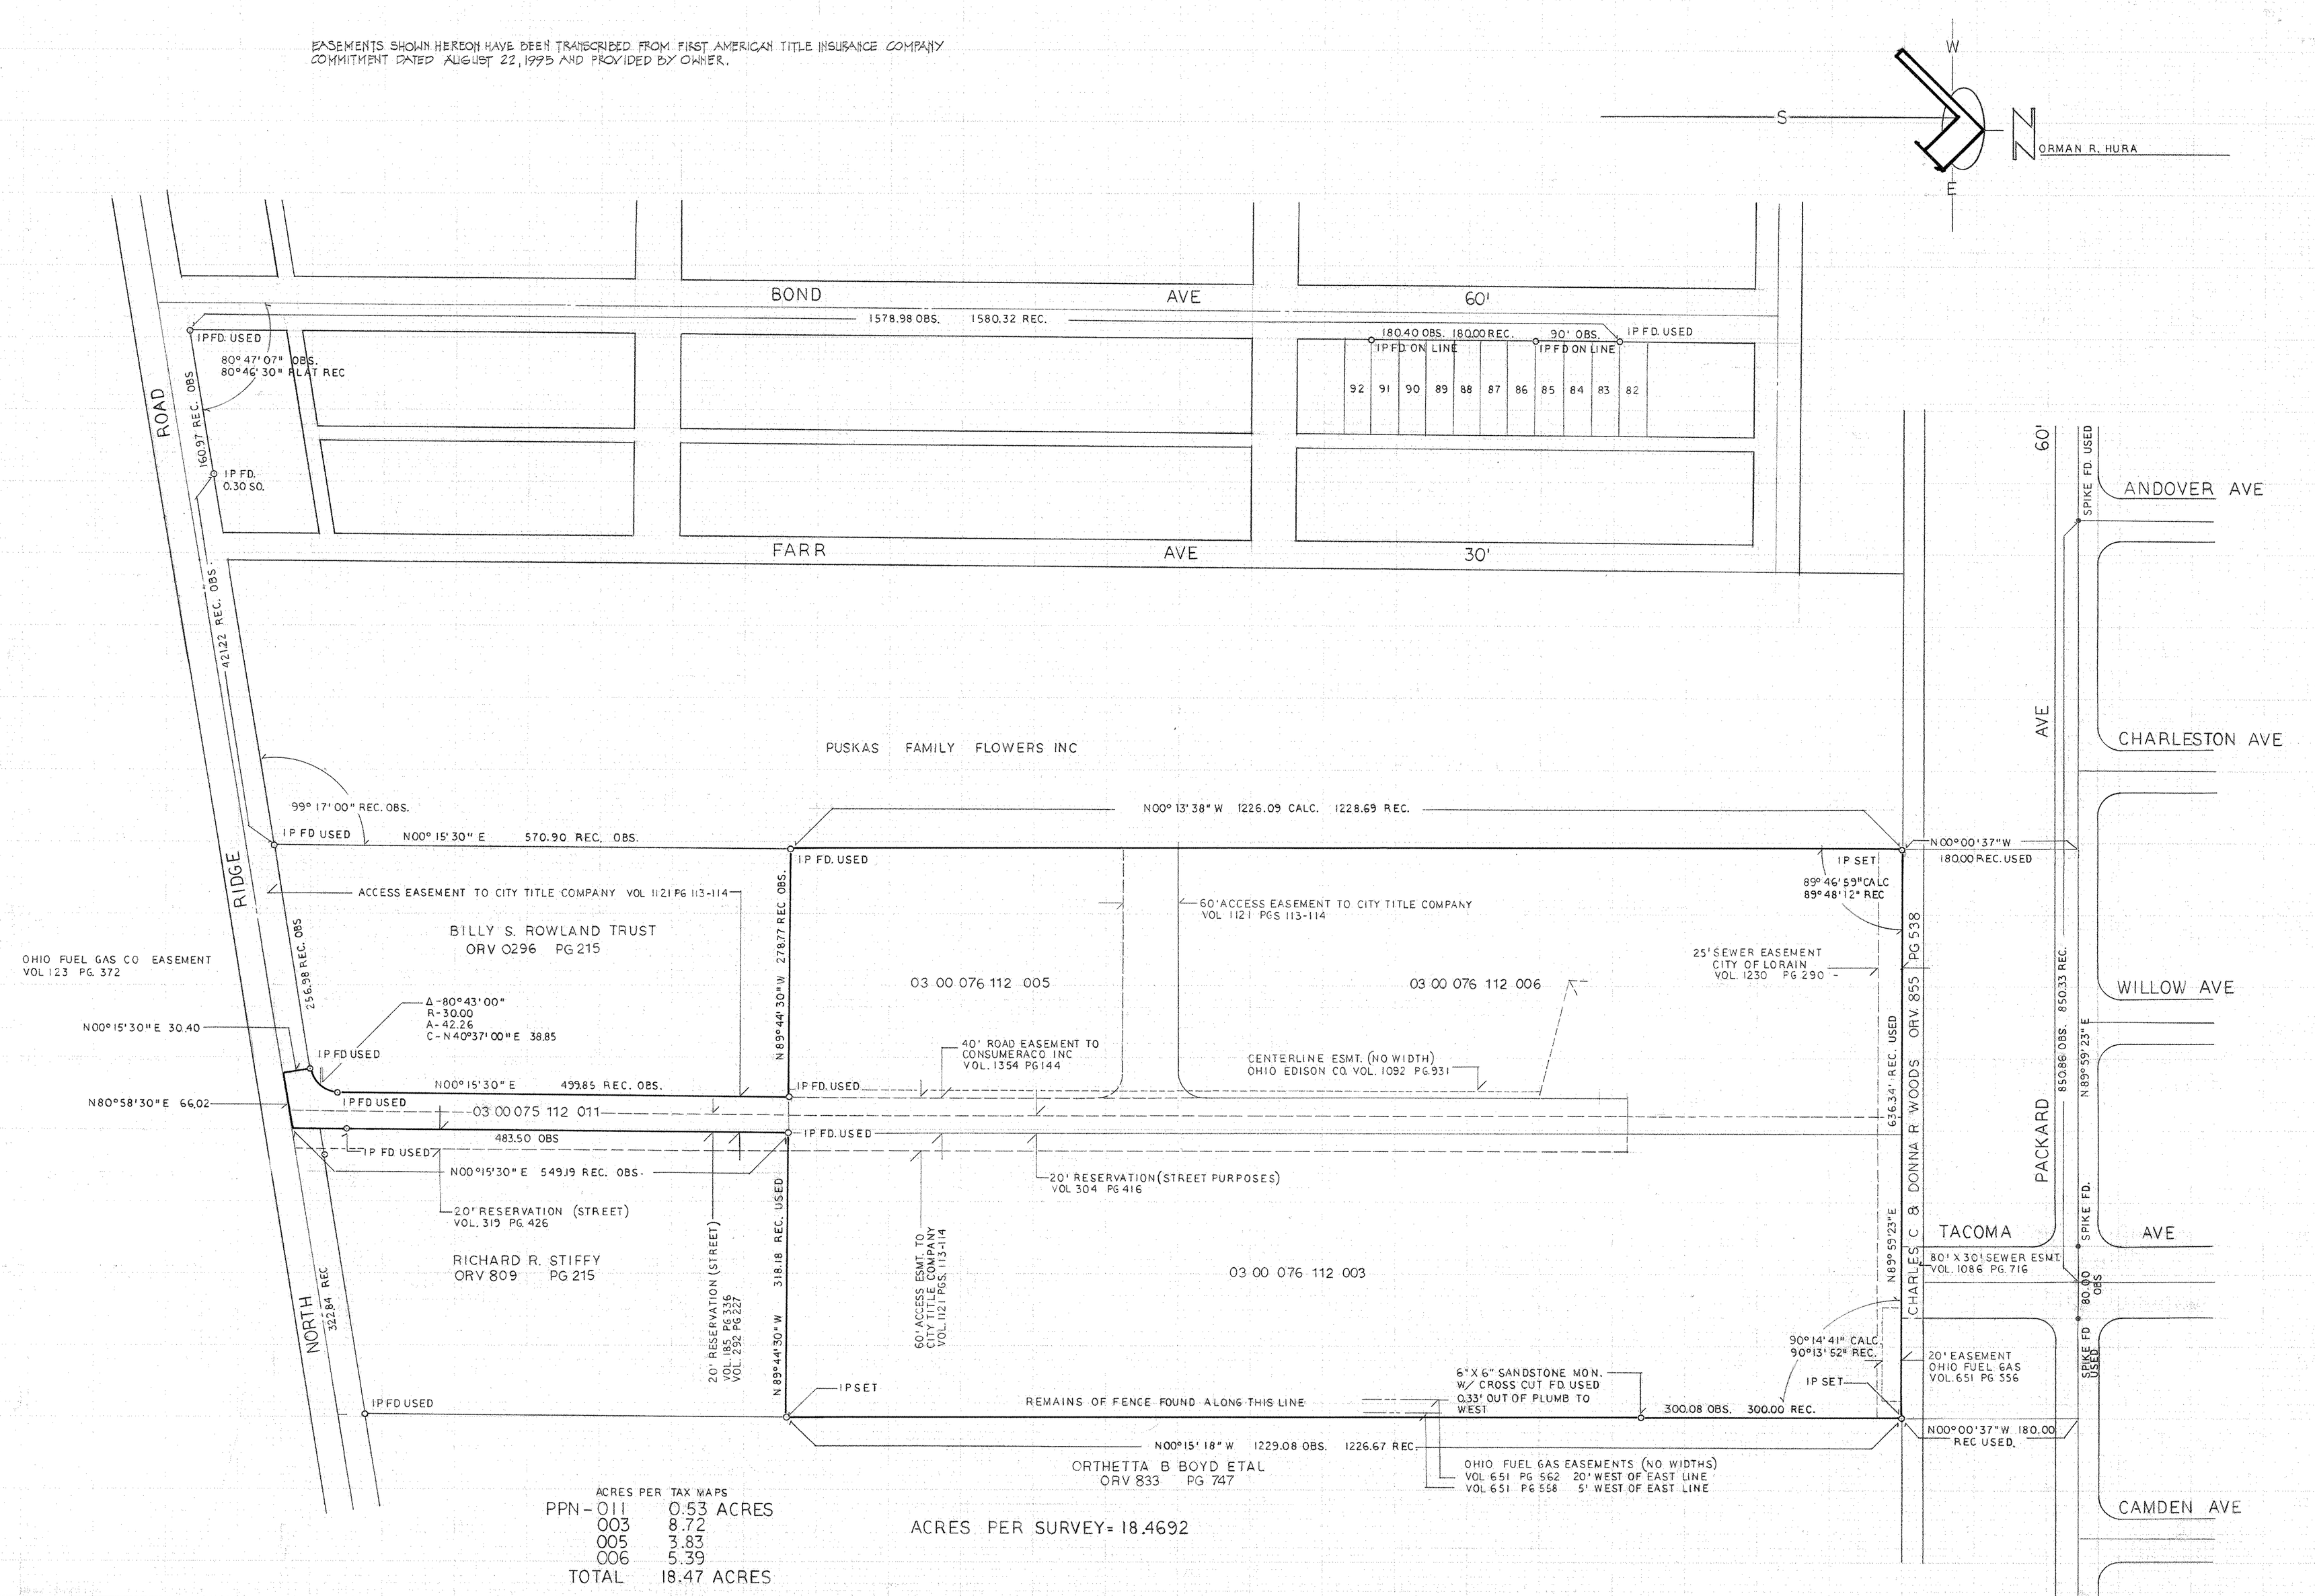

ACRES PER TAX MAPS

PPN - 011	0.53 ACRES
003	8.72
005	3.83
006	5.39
TOTAL	18.47 ACRES

ACRES PER SURVEY = 18.4692

03-00-076-112-003, 005, 006, 011
03-00-075-112
SCan # 47-1488

5088