02-03-001-103
02-03-001-A
Scan # 47699

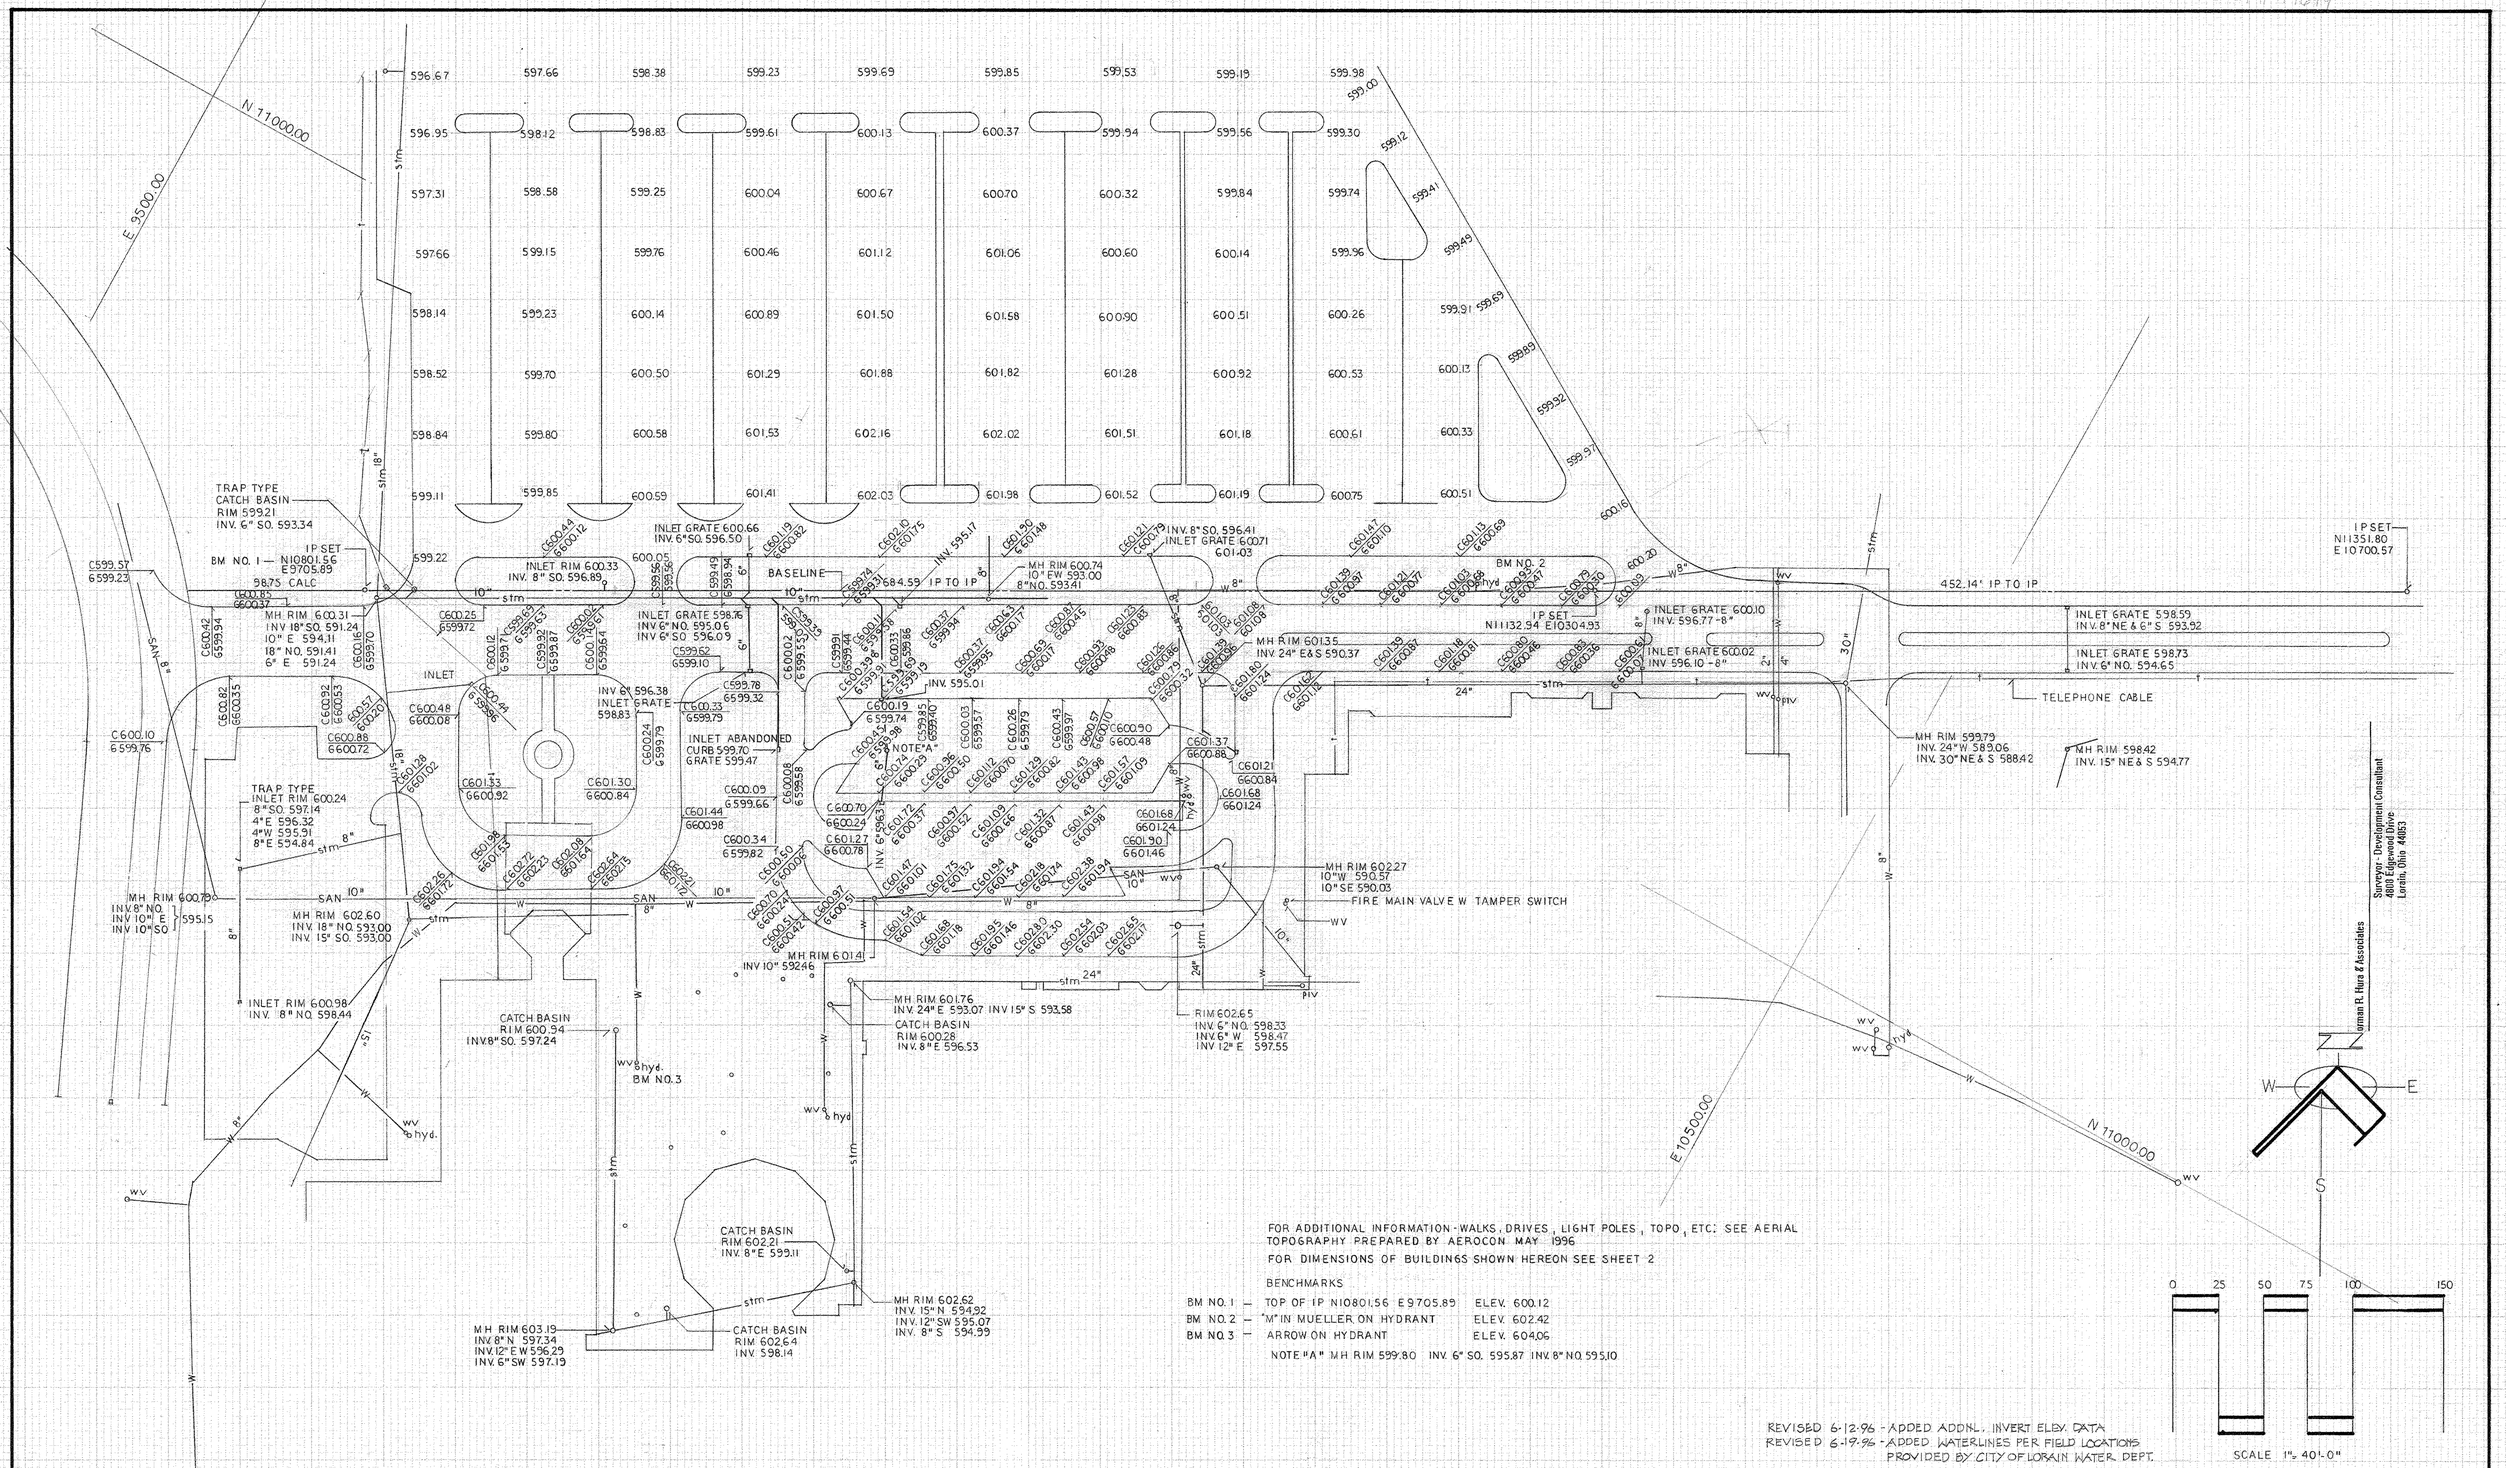

FOR ADDITIONAL INFORMATION - WALKS, DRIVES, LIGHT POLES, TOPO, ETC: SEE AERIAL TOPOGRAPHY PREPARED BY AEROCON MAY 1996

FOR DIMENSIONS OF BUILDINGS SHOWN HEREON SEE SHEET 2

BENCHMARKS

BM NO. 1 —	TOP OF IP N10801.56 E9705.89	ELEV. 600.12
BM NO. 2 —	"M" IN MUELLER ON HYDRANT	ELEV. 602.42
BM NO. 3 —	ARROW ON HYDRANT	ELEV. 604.06

NOTE "A" MH RIM 599.80 INV. 6" SO. 595.87 INV. 8" NO. 595.10

REVISED 6-12-96 - ADDED ADDITL. INVERT ELEV. DATA
REVISED 6-19-96 - ADDED WATERLINES PER FIELD LOCATIONS PROVIDED BY CITY OF LORAIN WATER DEPT.

LORAIN COMMUNITY / ST. JOSEPH'S HEALTH CENTER / WEST CAMPUS		TOPOGRAPHIC SURVEY	MAY 1996

6006 A