06-25-007-000-230
06-25-007-000-181
06-25-007-000-229
Scan # 47715

6-126

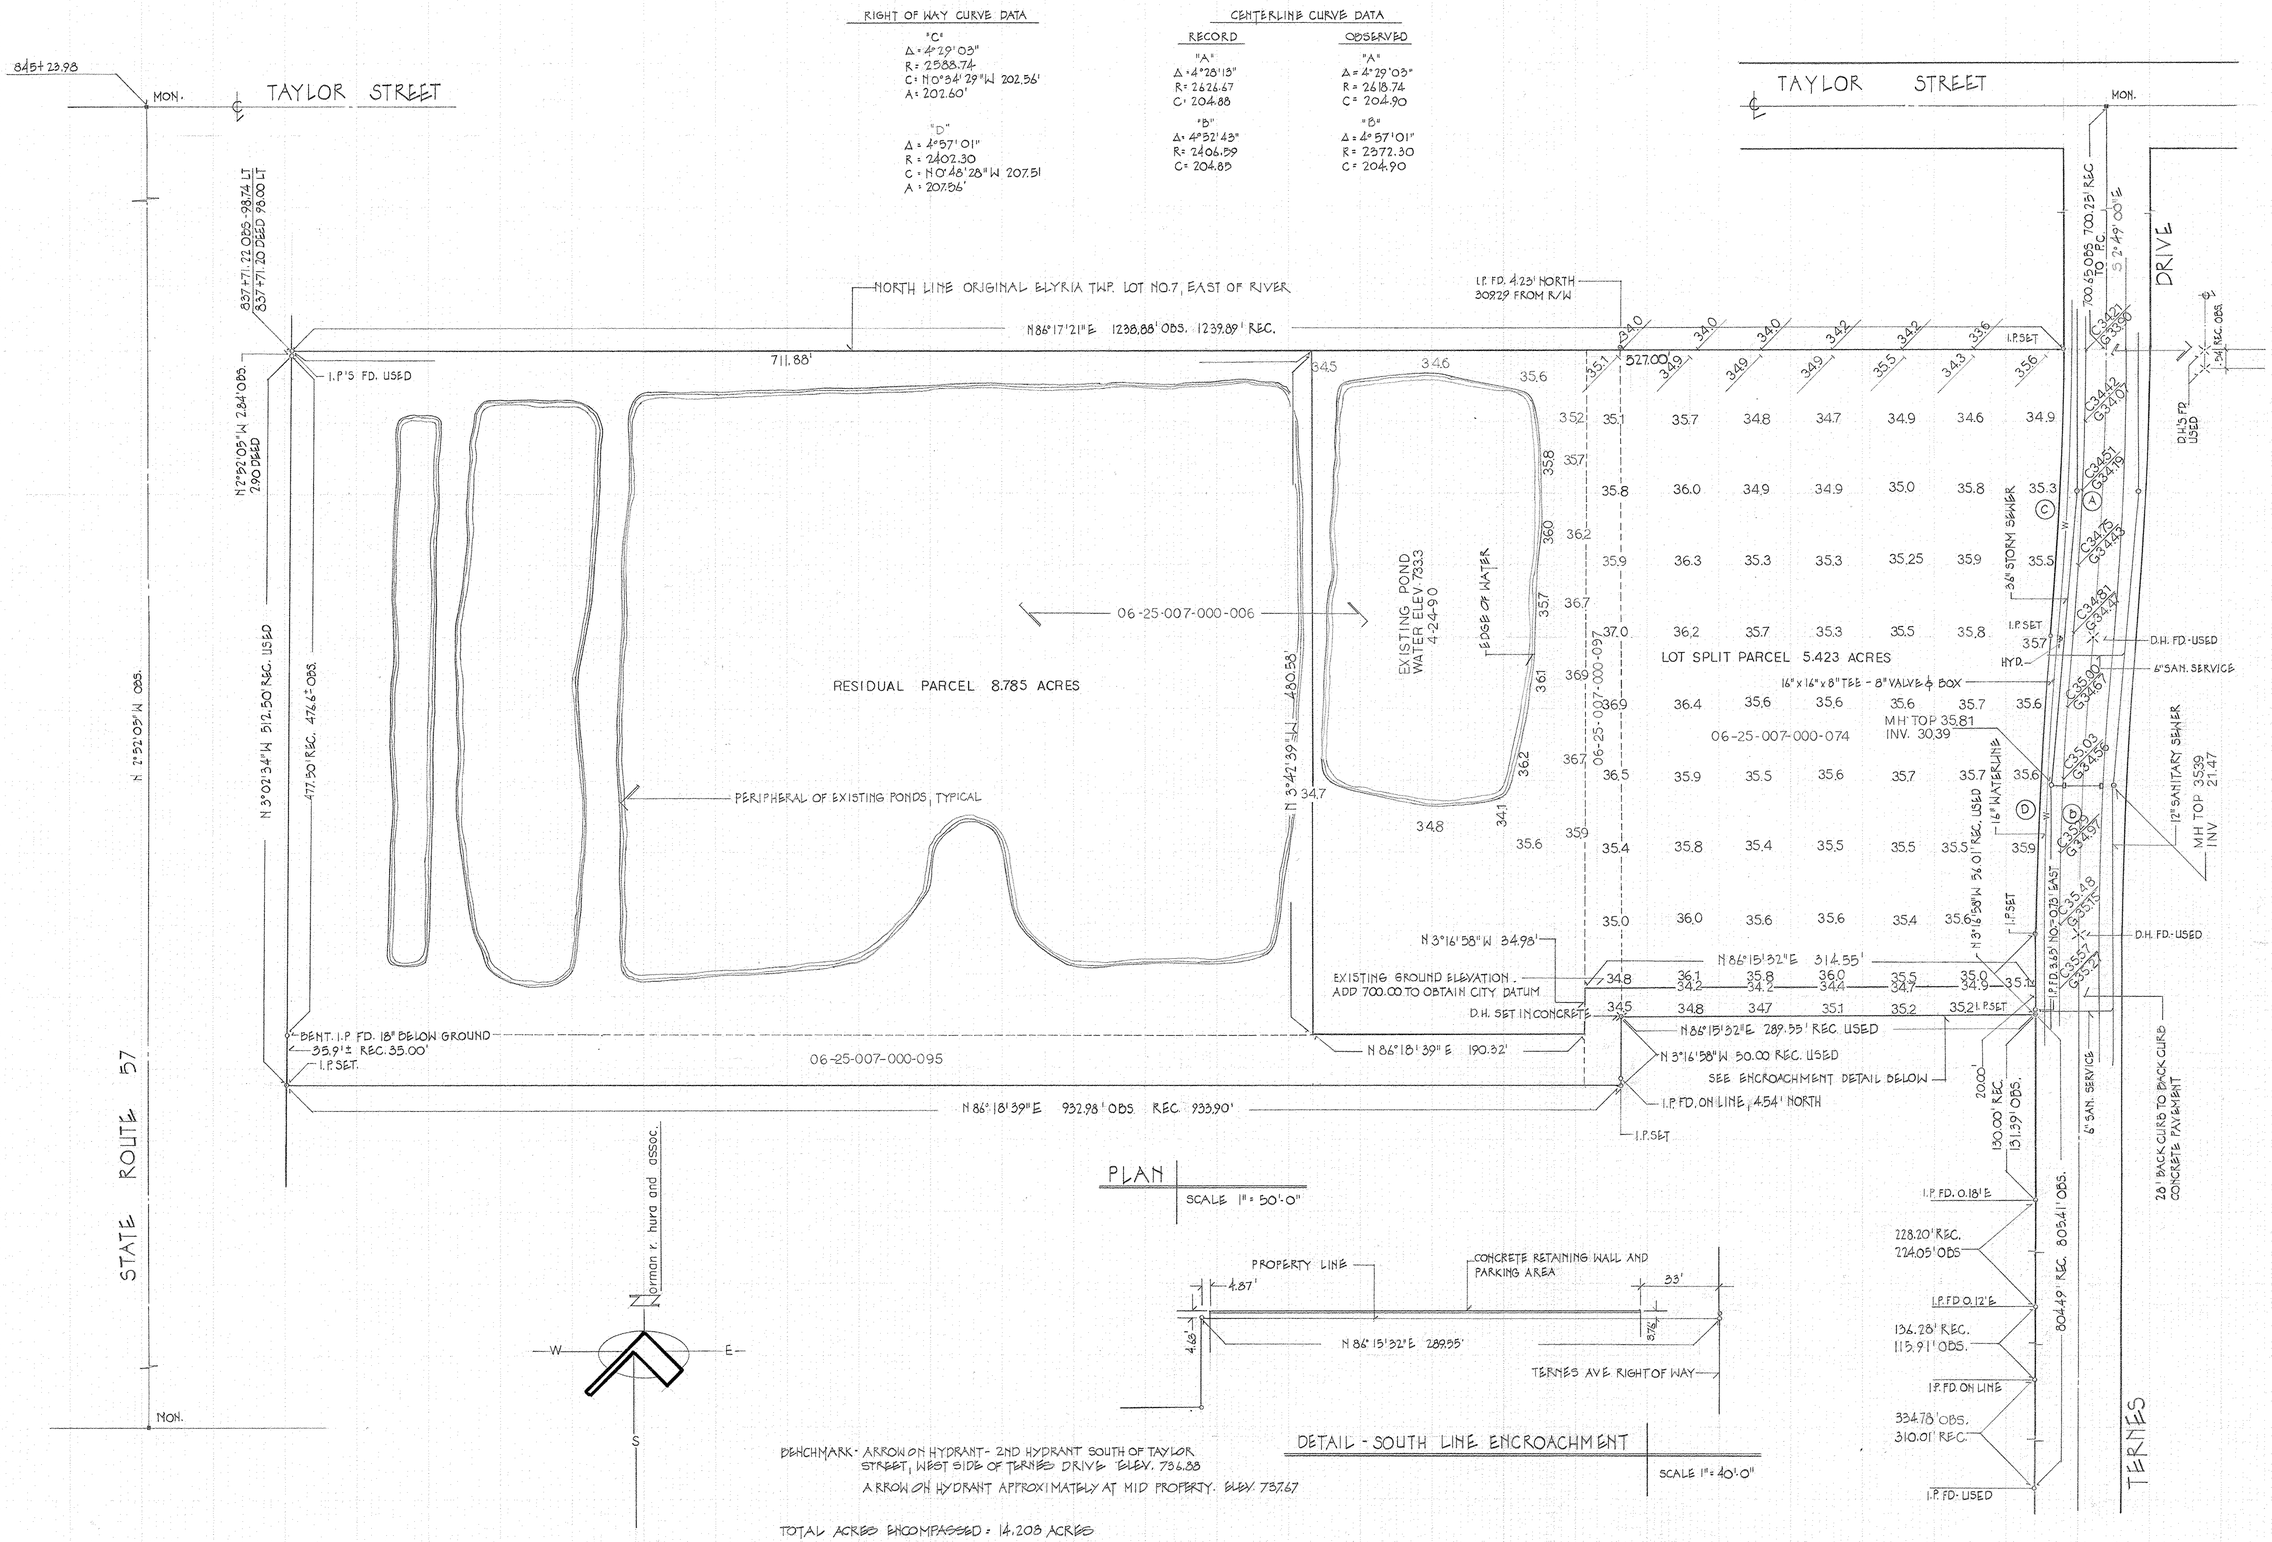

APRIL 1990
FB 53 PG 50-56

STATE OF OHIO
N.R. HURA
S-5208
REGISTERED
PROFESSIONAL
SURVEYOR

REVISED 6-8-90 - ADDED LOT SPLIT

OUTLINE, TOPOGRAPHICAL SURVEY - LOT SPLIT
PPNO.'S 06-25-007-000-006, 06-25-007-000-074
06-25-007-000-095, 06-25-007-000-097

CASCADE PATTERN
TERNES AVENUE
ELYRIA, OHIO

4037 A