10-00-006-111-039, -041, 040, 042, -055, -054, -056
038, -037, -051, -050
10-00-006-G Scan # 47717

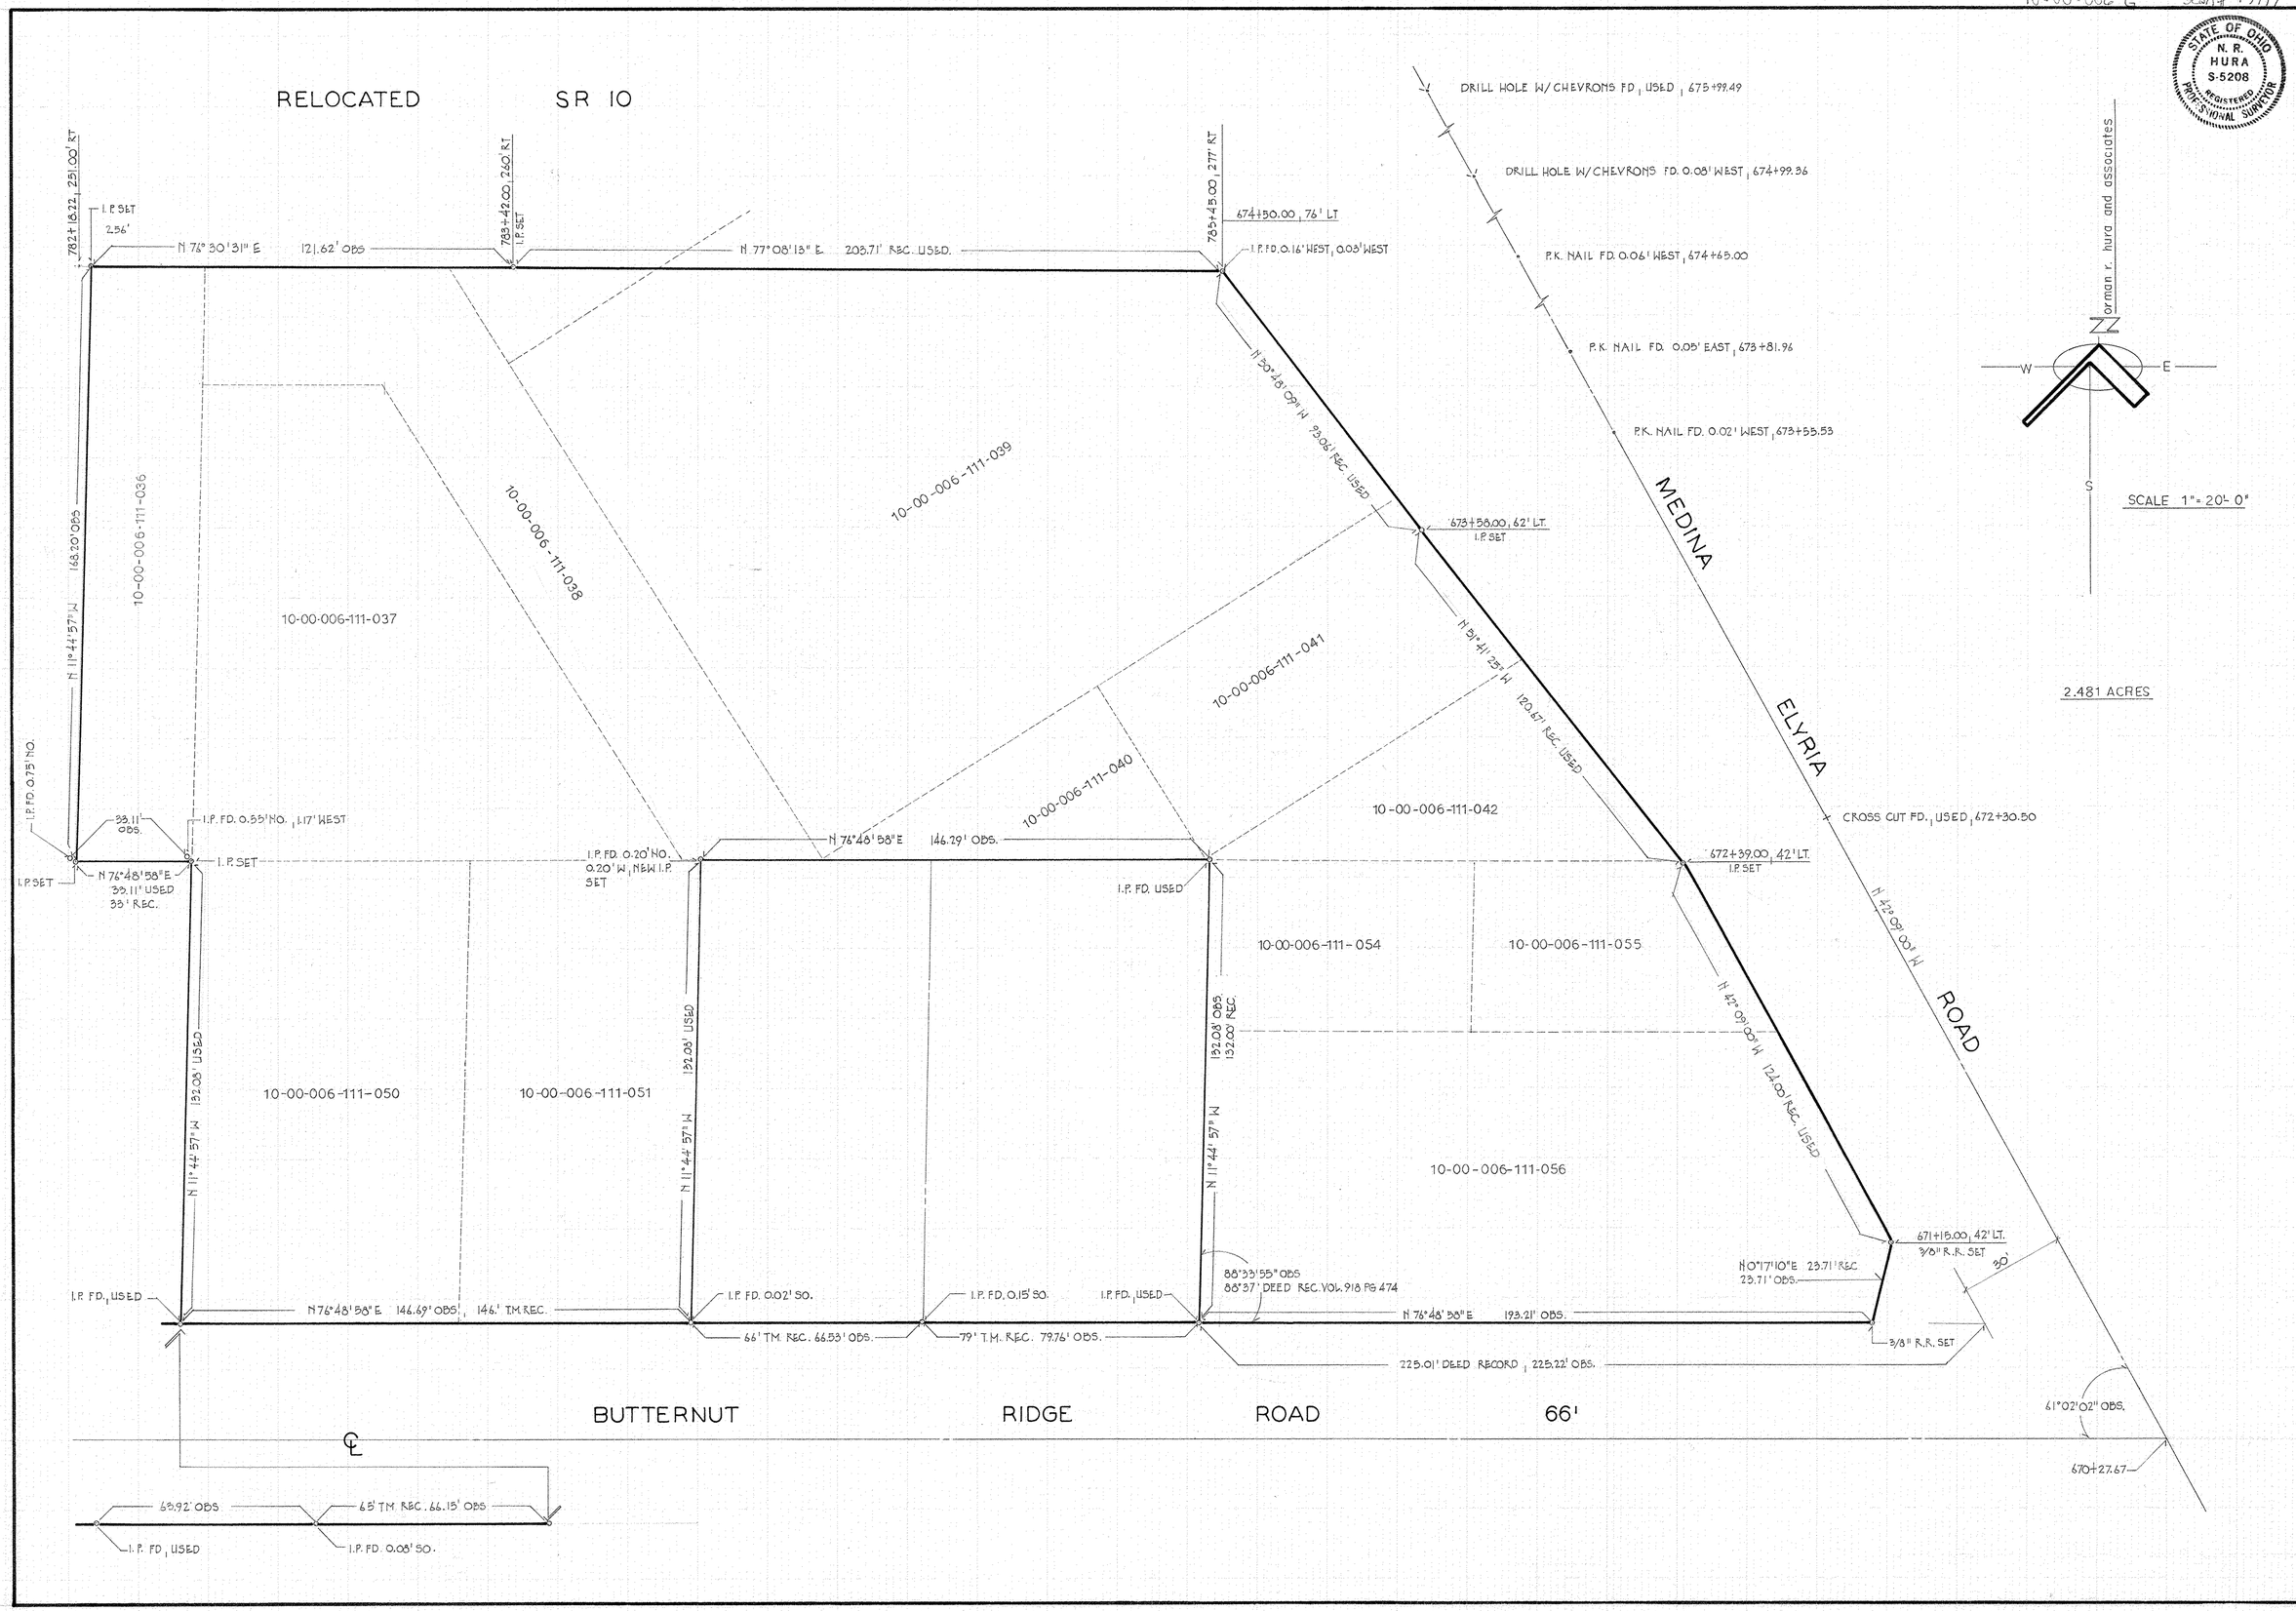

FB 51 PG 32, 33

CARLISLE TWP.
OCTOBER 1989

OUTLINE SURVEY

LAPORTE UNITED METHODIST CHURCH

4029