07-00-043-101
07-00-043-C #4778

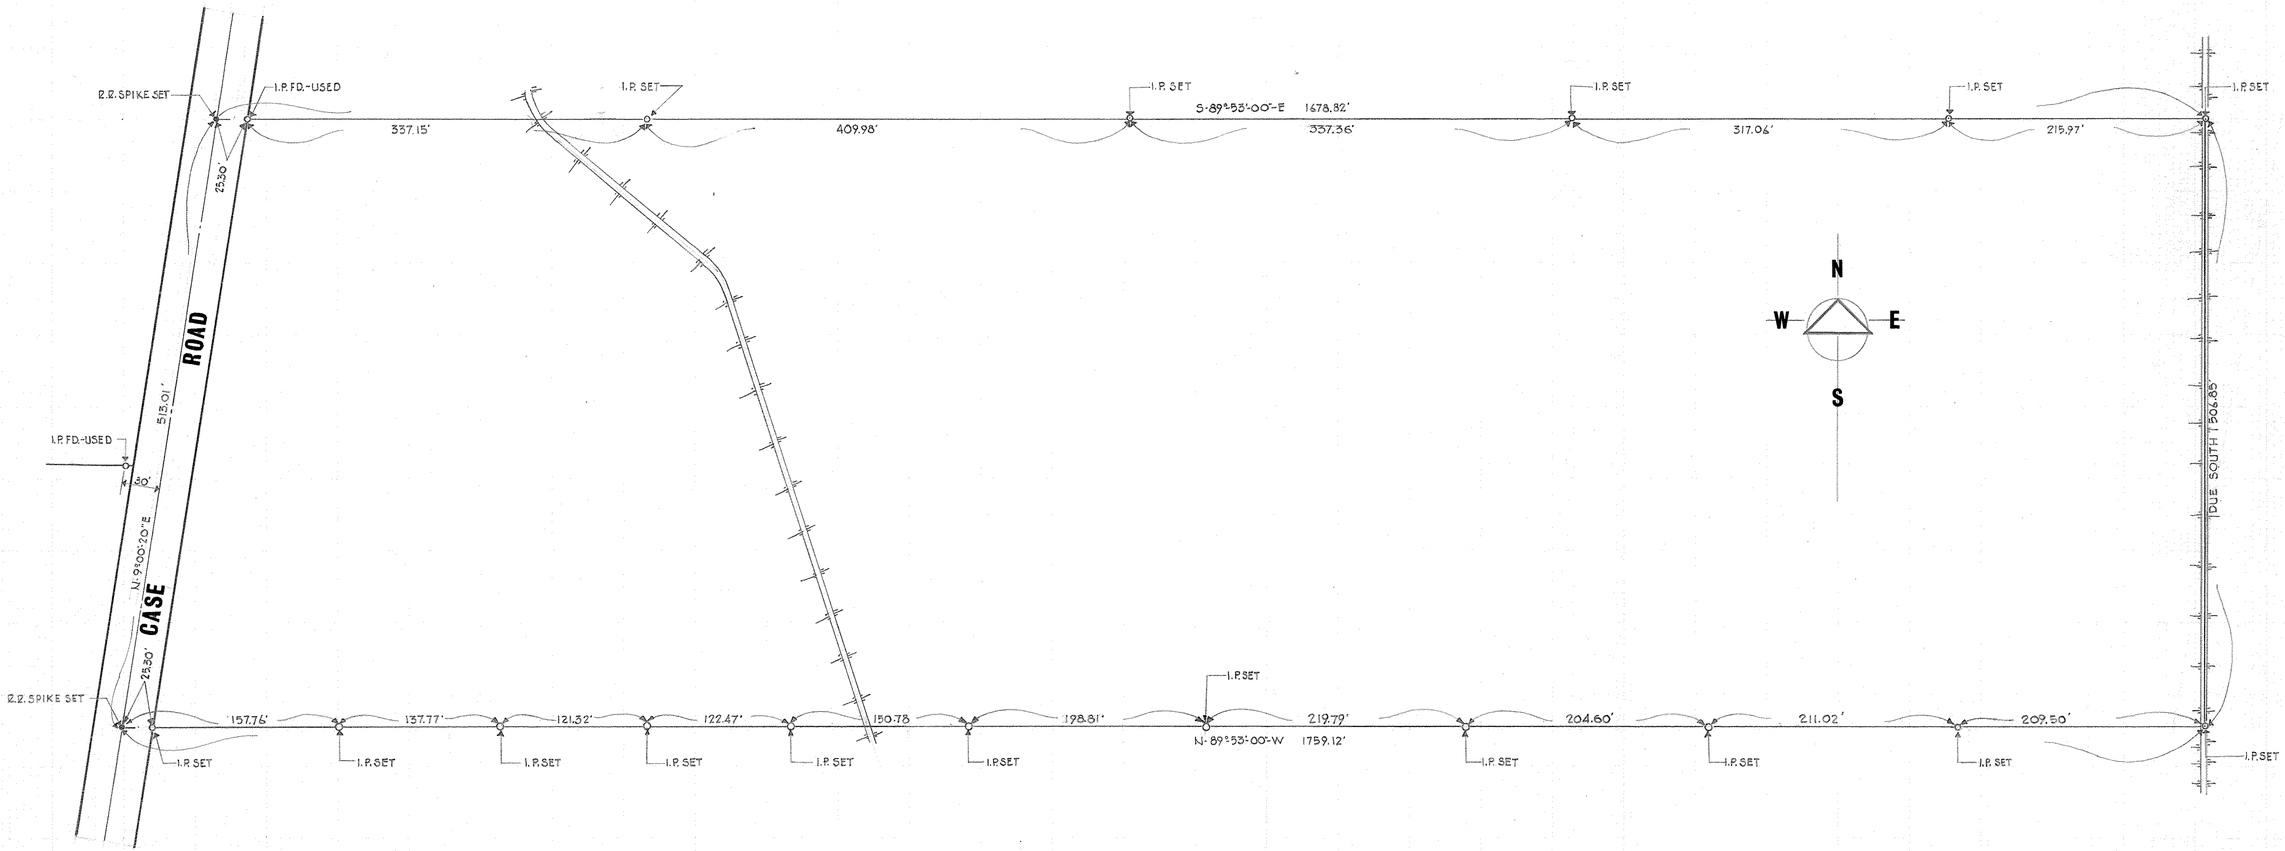

SURVEY OF PART OF ORIGINAL LOT NO. 43
OF RIDGEVILLE TOWNSHIP - LORAIN CO.
OHIO SCALE 1"=60' SEPT 16, 1975

20.001 ACRES

norman r. hura - registered surveyor

FB 4 P60

4021