



OBERLIN AVENUE

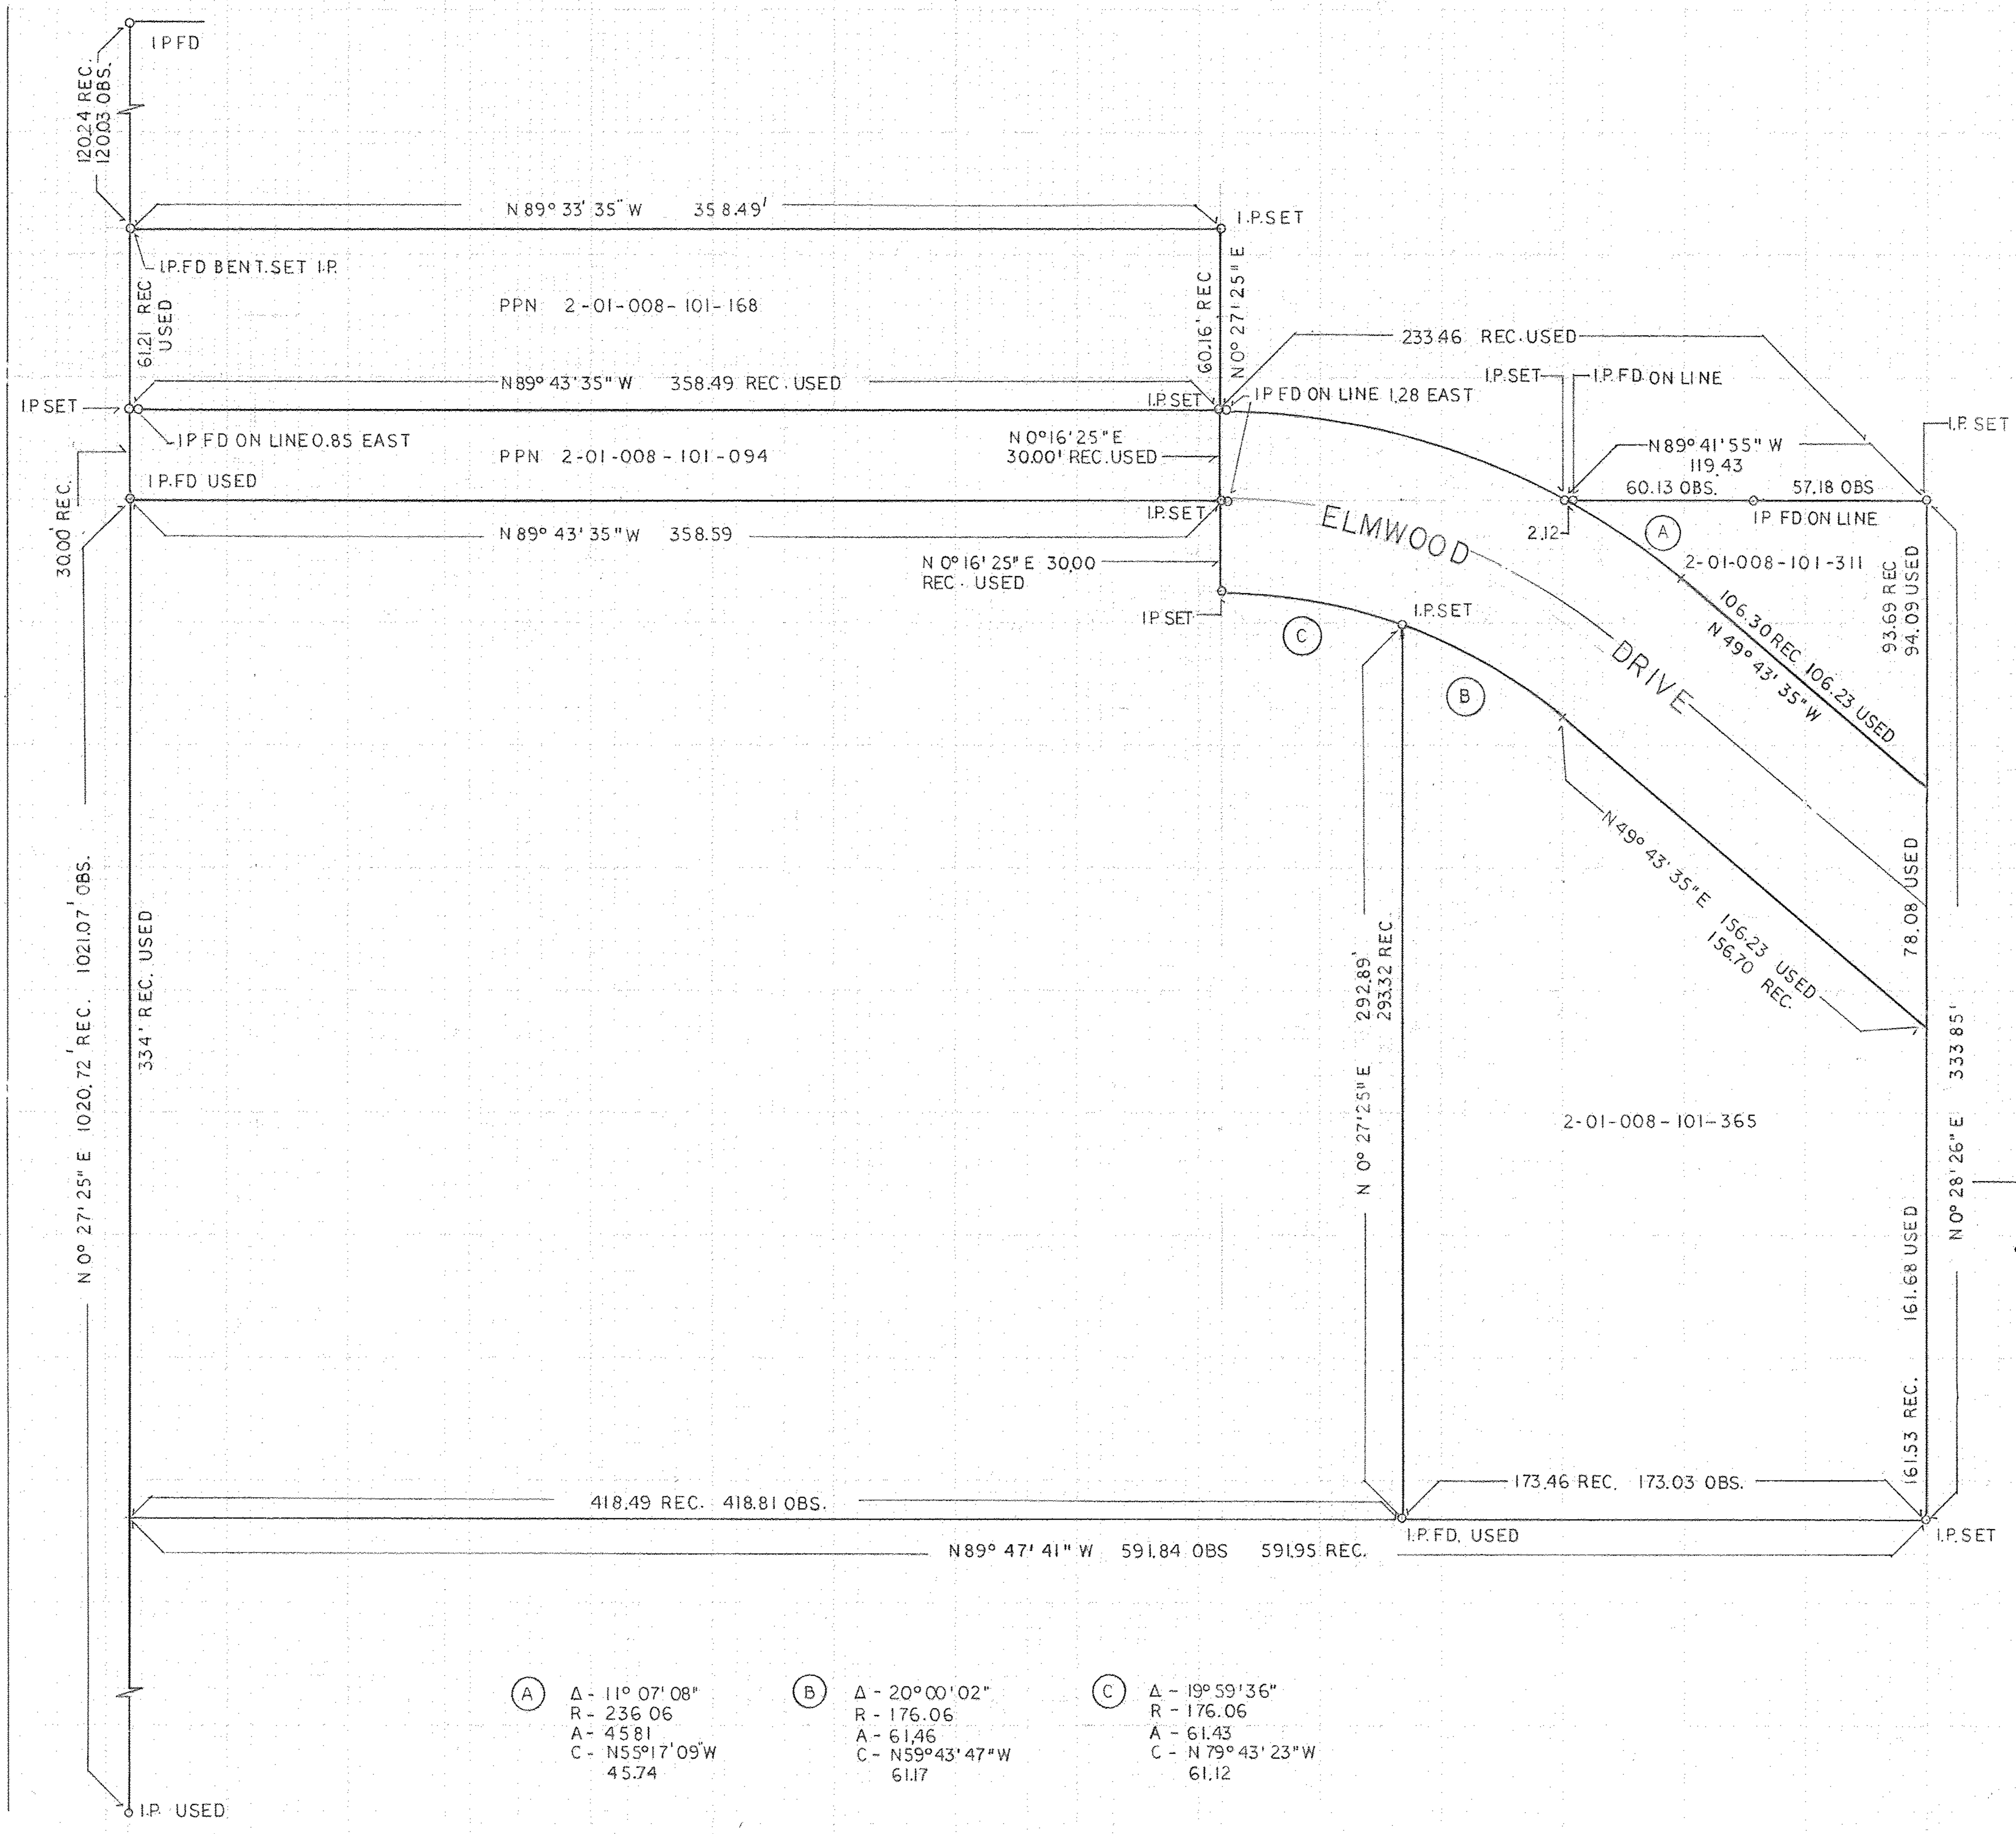

- (A) Δ - 11° 07' 08"  
R - 236.06  
A - 45.81  
C - N55°17'09"W  
45.74
- (B) Δ - 20° 00' 02"  
R - 176.06  
A - 61.46  
C - N59°43'47"W  
61.17
- (C) Δ - 19° 59' 36"  
R - 176.06  
A - 61.43  
C - N 79° 43' 23"W  
61.12

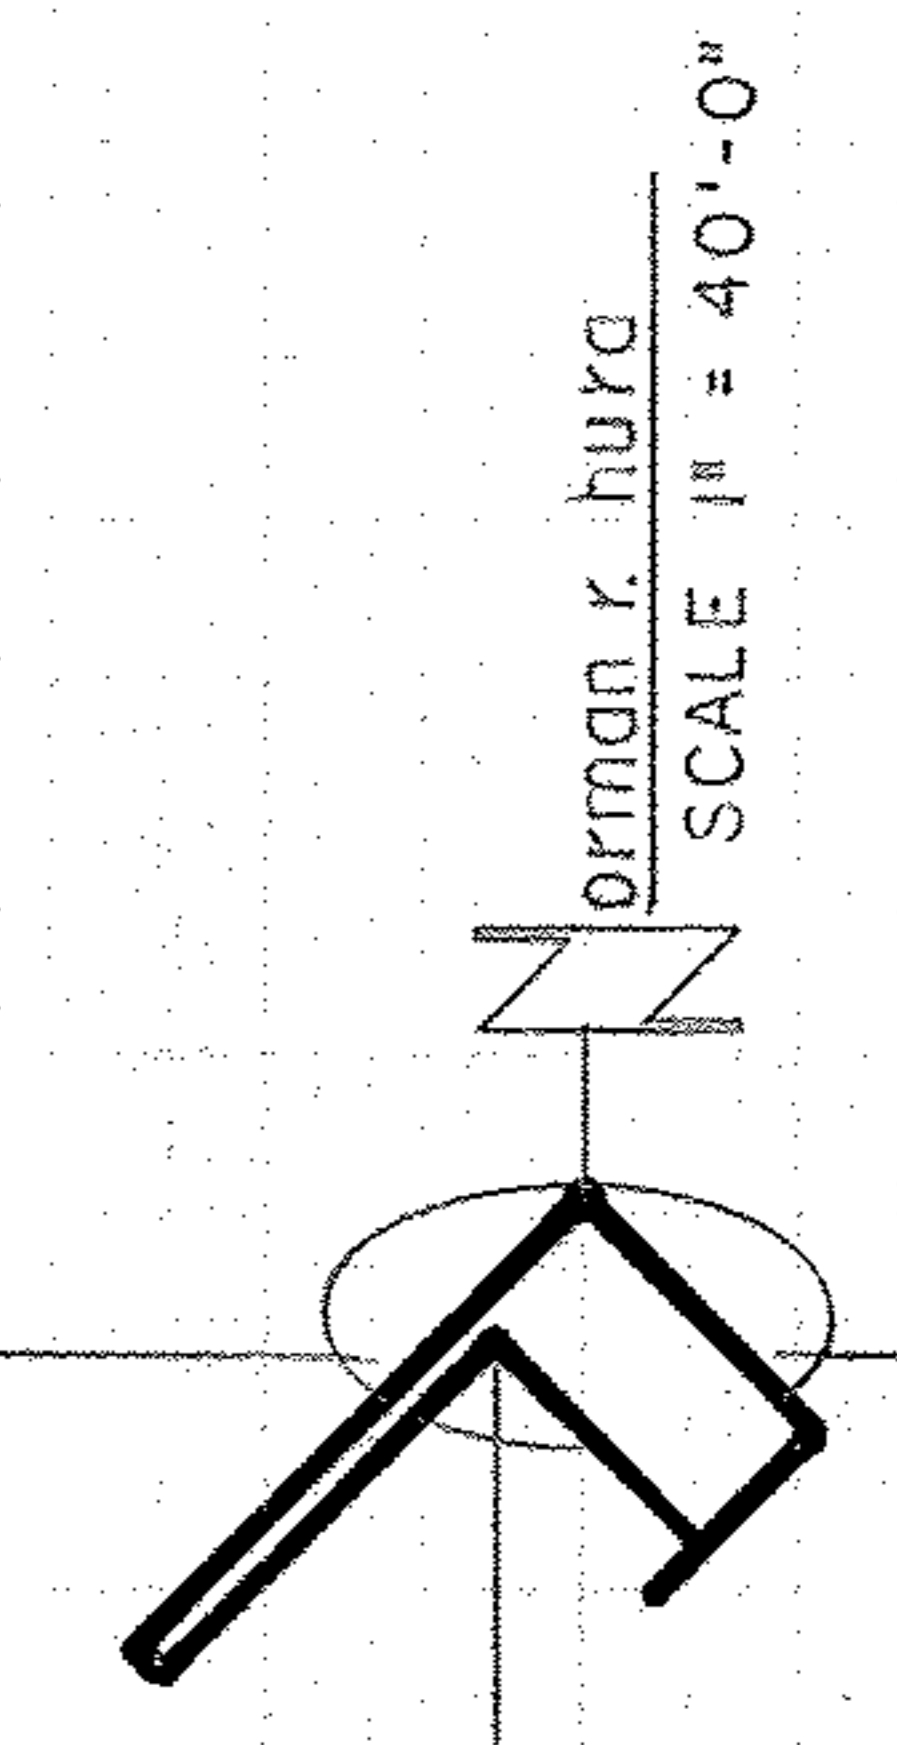

O.L. NO. 8 TRACT NO. 1  
BLACK RIVER TWP.  
CITY OF LORAIN, OHIO  
JULY 1991

OUTLINE SURVEY OF PPN'S  
02-01-008-101-094 02-01-008-101-168  
02-01-008-101-311 02-01-008-101-365

SMITTIES DISTRUBTING CO.