02-01-006-104-027
02-01-006-A Scan # 47740

NOV. 1984
SCALE 1/16" = 1'-0"

OUTLINE SURVEY - PARTIAL TOPO

WICKENS, HERZER, PANZA

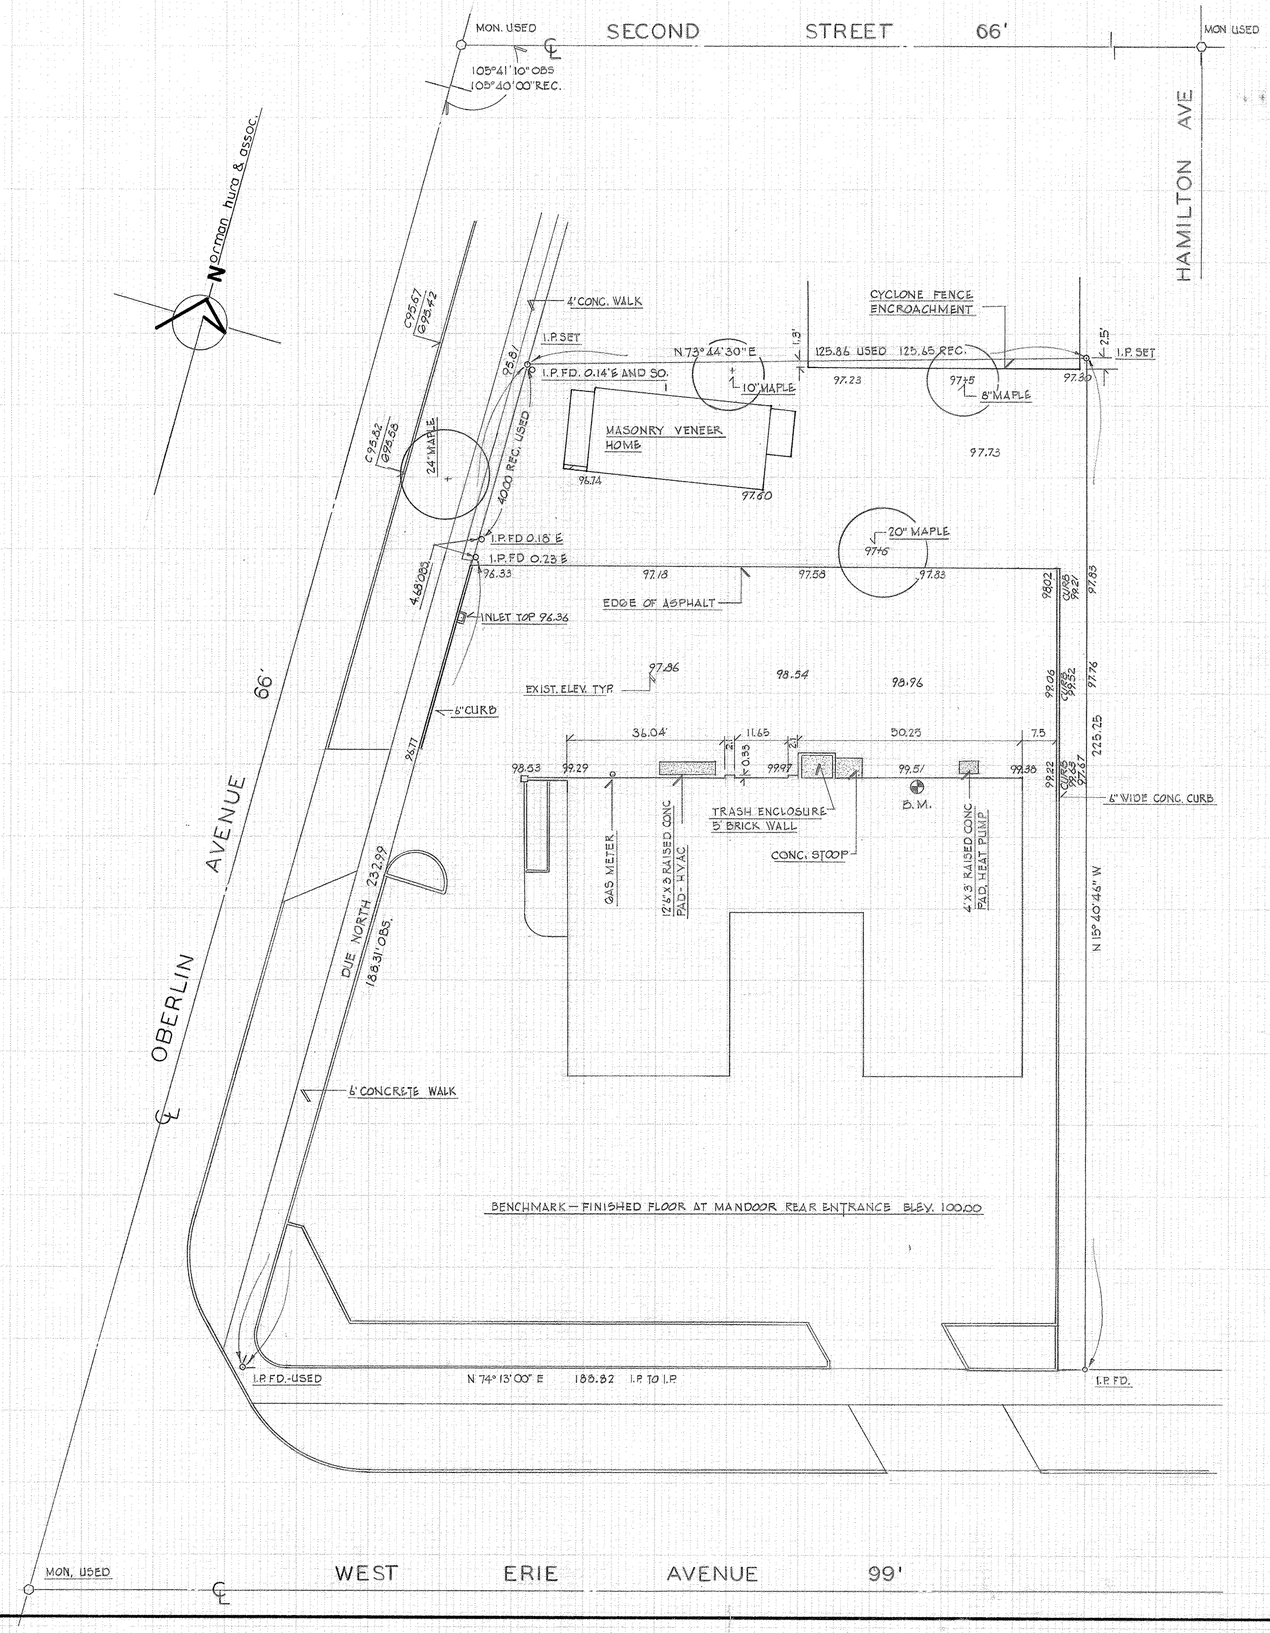

2026 A