


SCALE 1"=40'
APRIL 1985

PPN 5-00-003-105-029

LOCATION SURVEY

ALEX J. & JOAN M. KASUBIENSKI

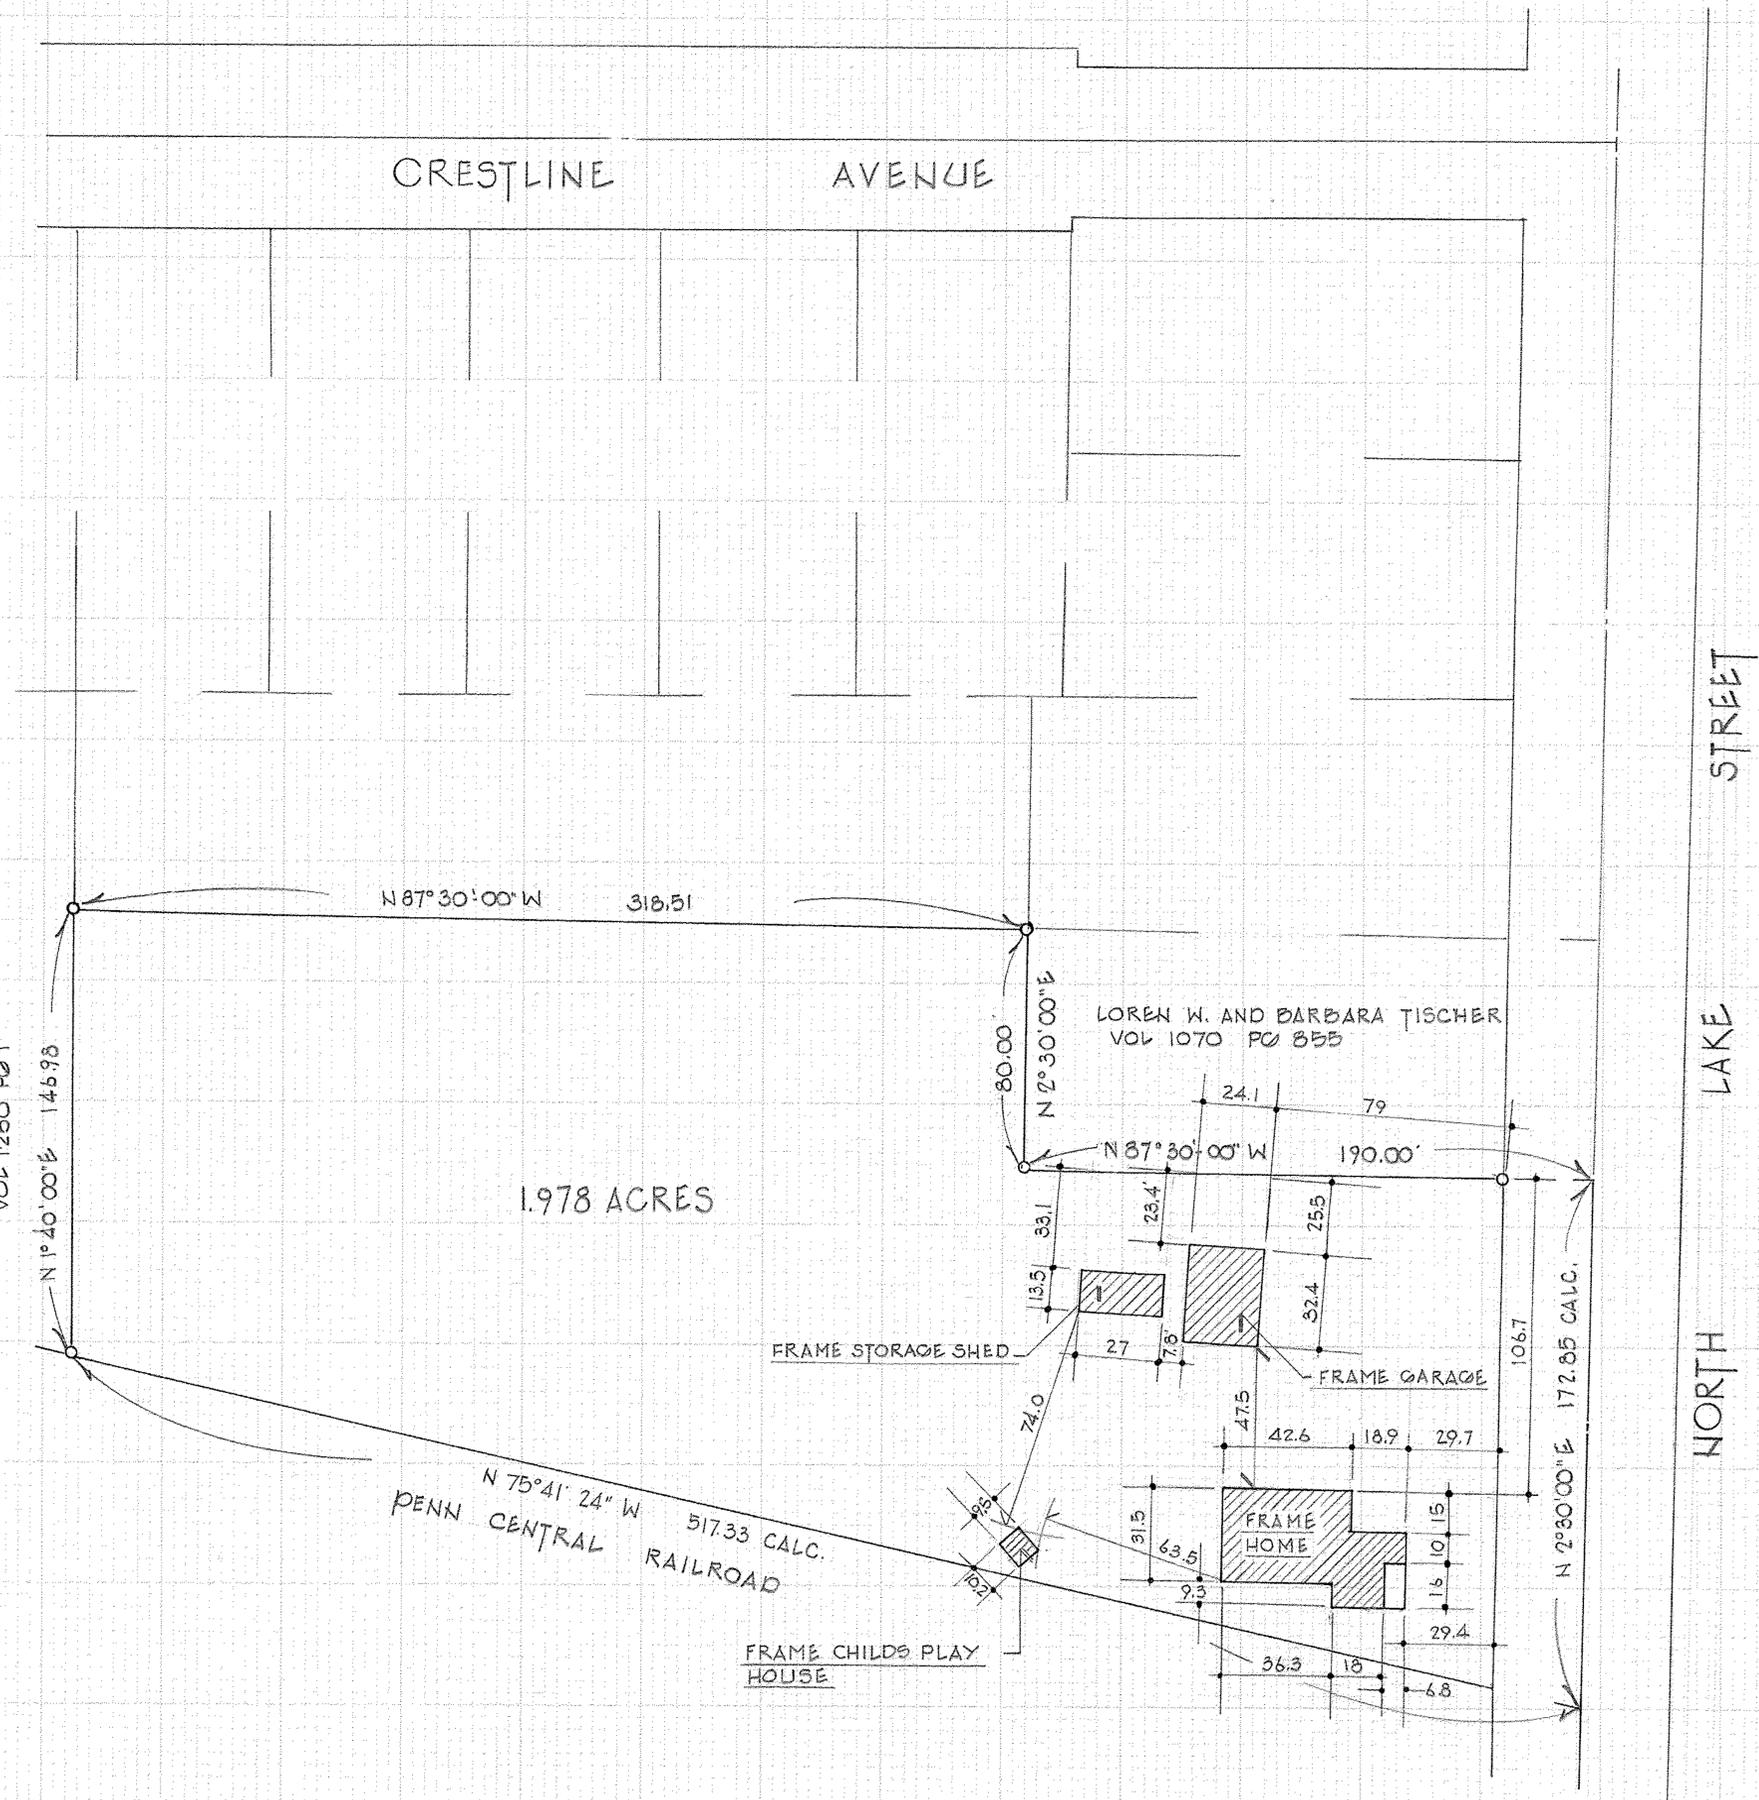

1.978 ACRES

LOREN W. AND BARBARA TISCHER
VOL 1070 PG 855

FRAME STORAGE SHED

FRAME GARAGE

FRAME HOME

FRAME CHILDS PLAY HOUSE

PENN CENTRAL RAILROAD

N 75° 41' 24" W 517.33 CALC.

N 87° 30' 00" W 318.51

N 2° 30' 00" E 80.00'

N 87° 30' 00" W 190.00'

N 2° 30' 00" E 172.85 CALC.

SAM AND DONNA FALDO
VOL 1250 PG 1

Norman Hura & Assoc.



NOT A PLAT OF SURVEY. FOR MORTGAGE PURPOSES