NORMAN R. HURA - REGISTERED SURVEYOR

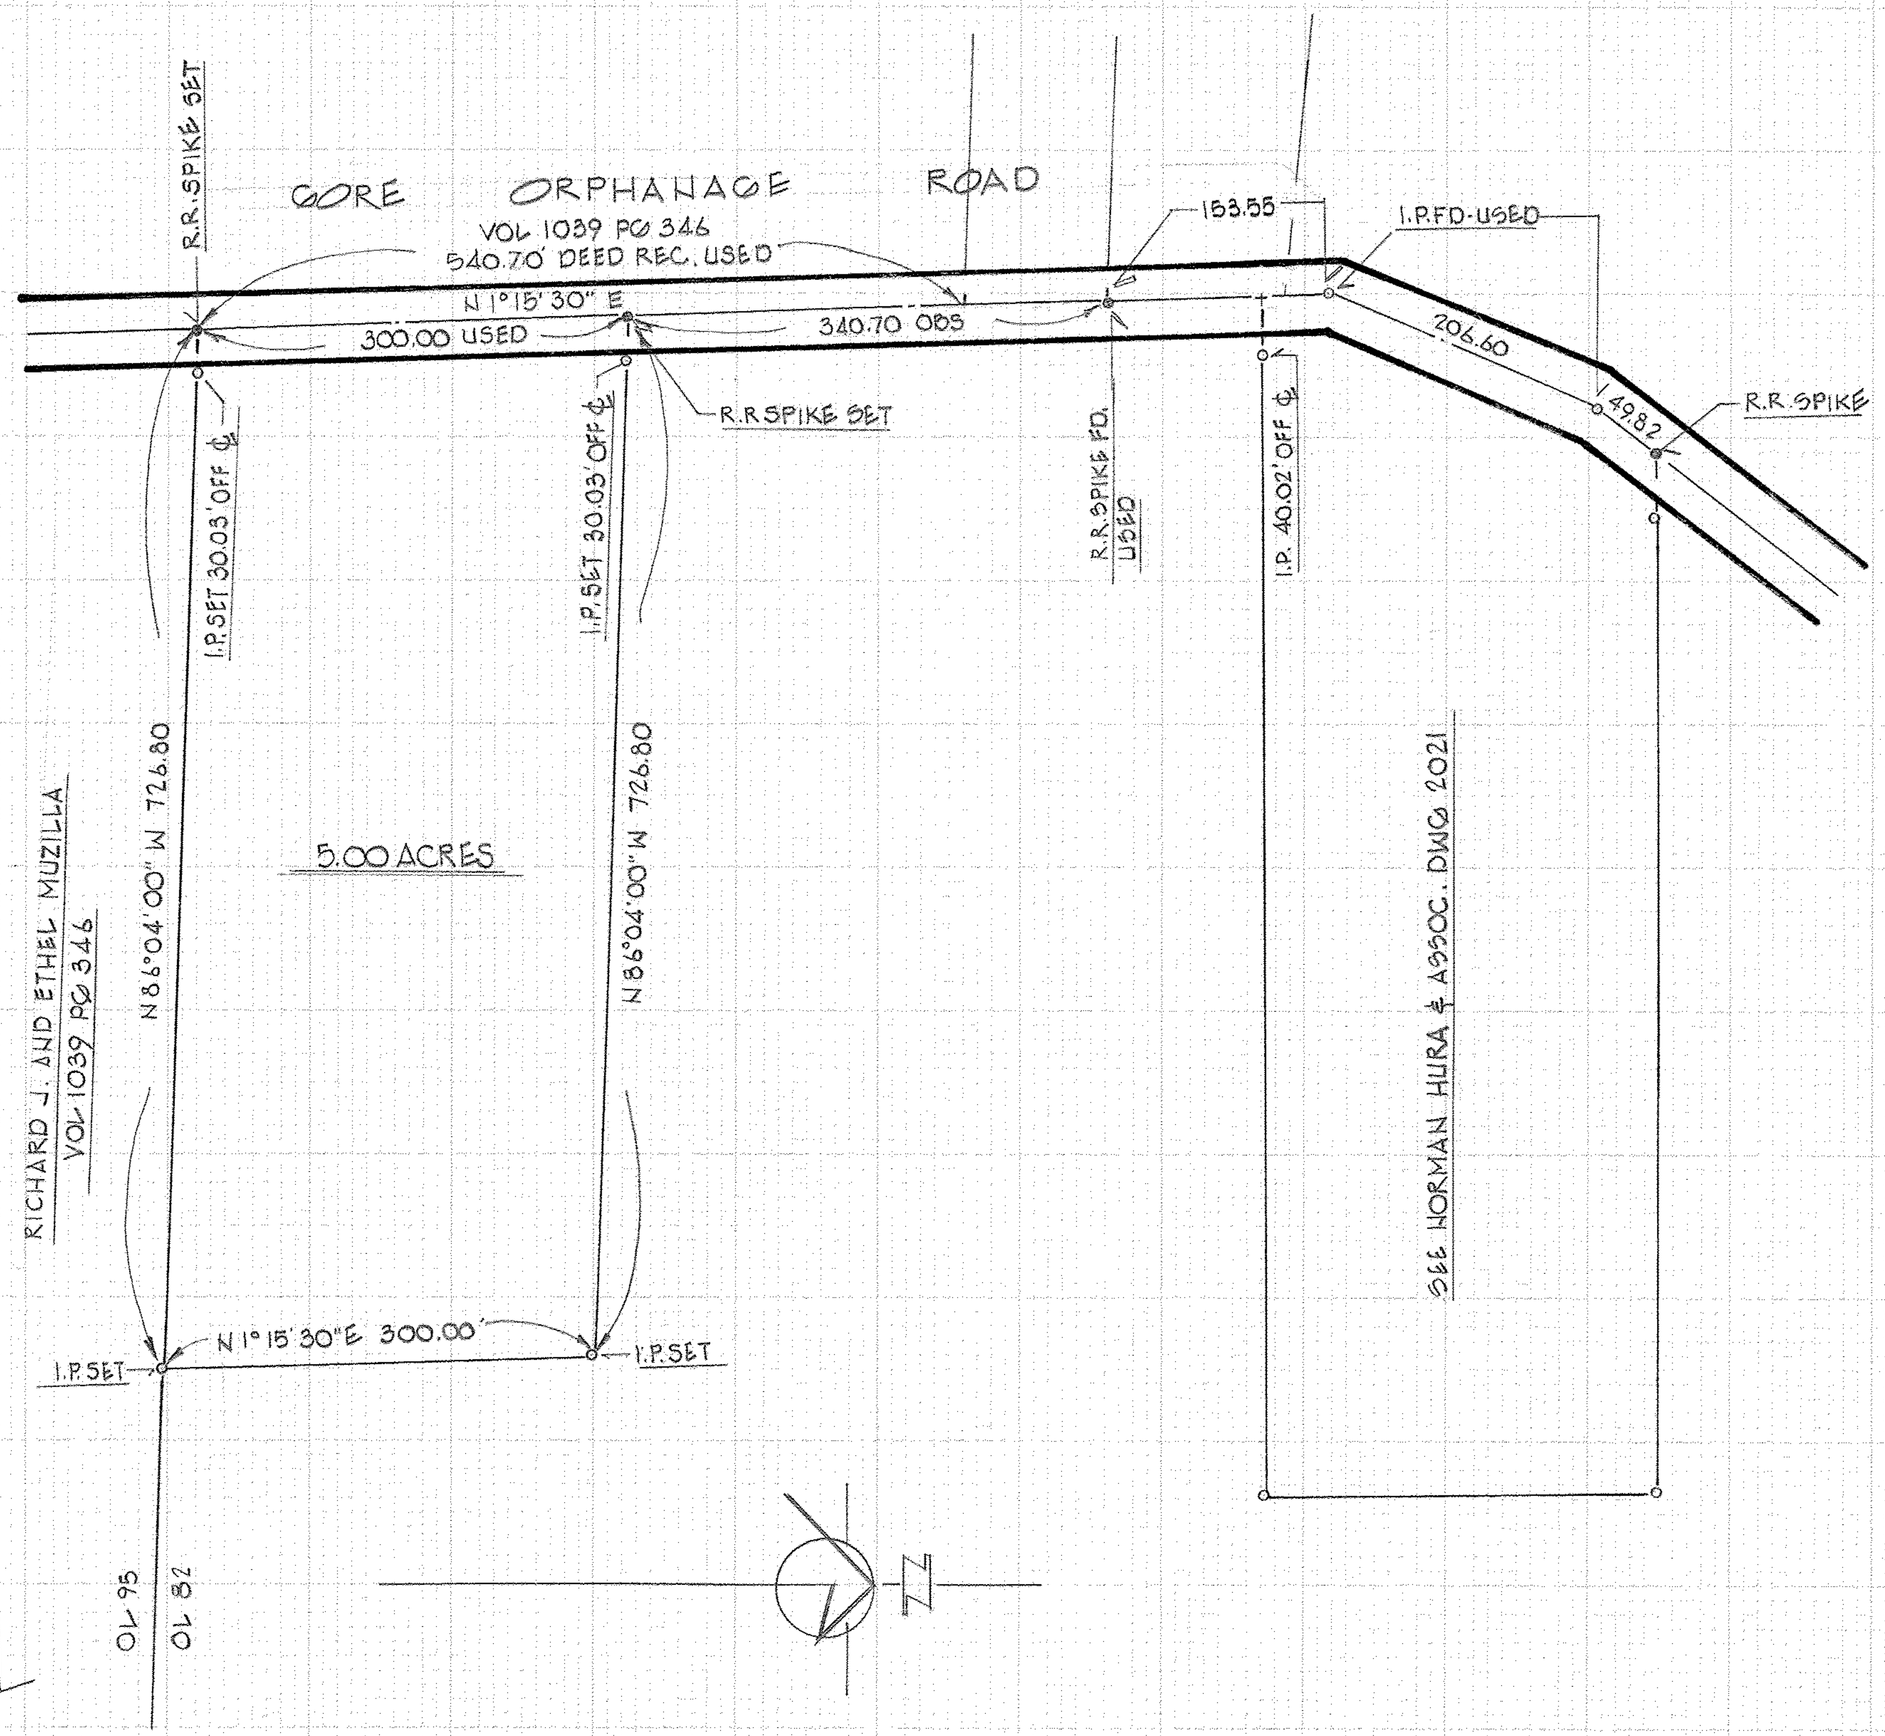

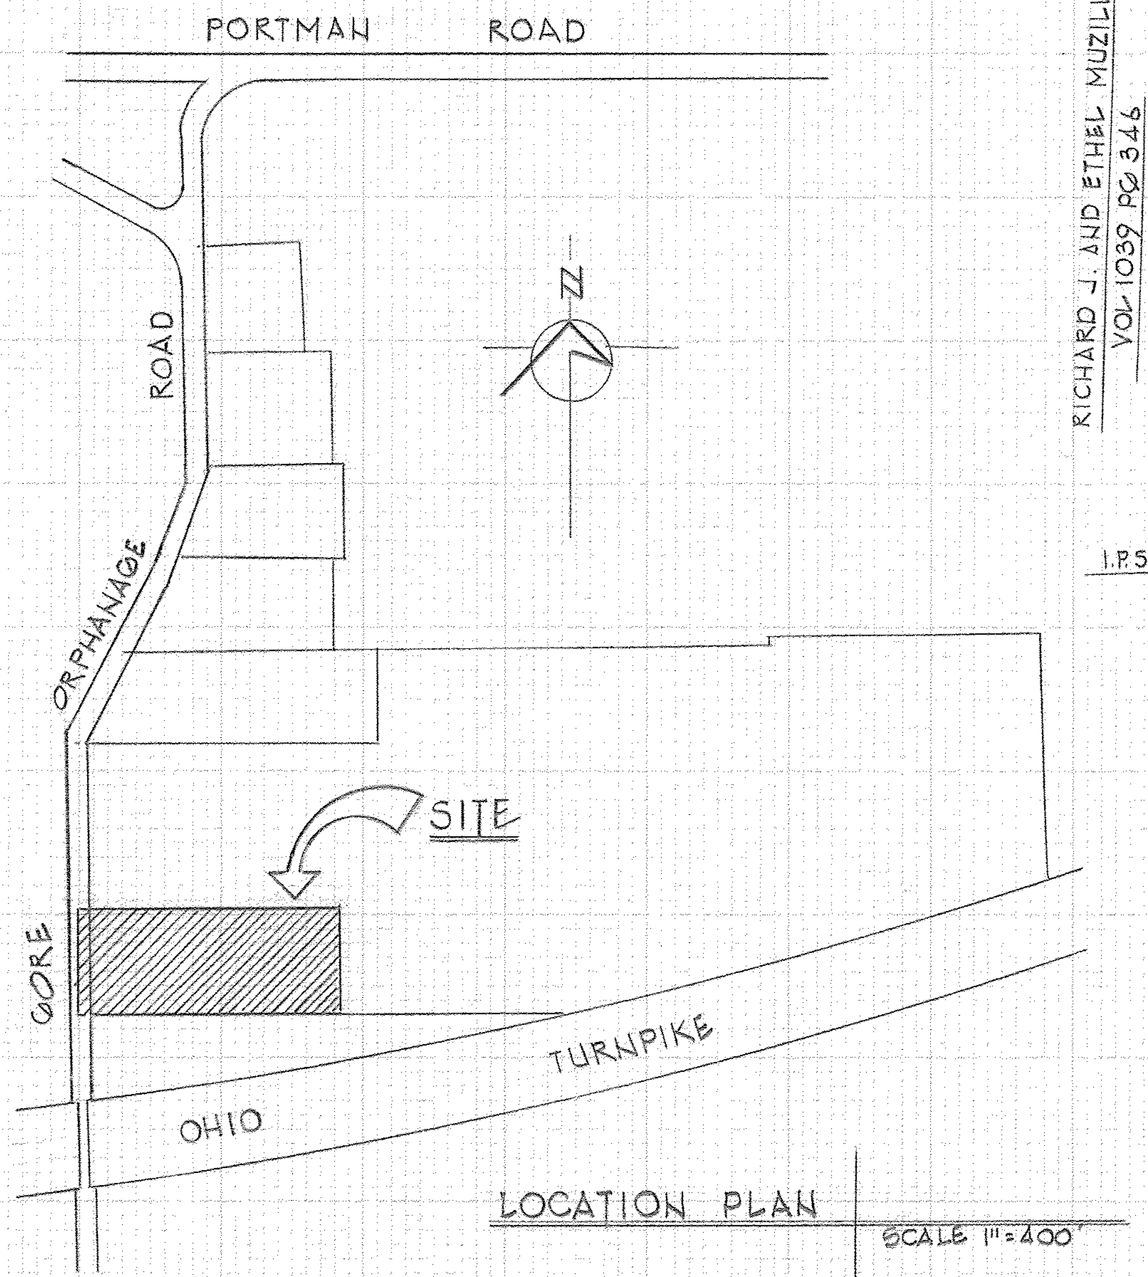

LOCATION PLAN
SCALE 1" = 400'

PLAT OF LOT SPLIT FROM P.P.N 8-00-082-000-021
PART OF ORIGINAL LOT NO. 82 - HENRIETTA TWP
LORAIN COUNTY - OHIO

SCALE 1" = 100' JUNE 1985

8-00-082-000-028, 030
8-A Scan # 47748

2050