THE CENTRAL TRUST COMPANY

OUTLINE & TOPOGRAPHICAL SURVEY
P.P.N. 2-01-003-158-018; 2-01-003-158-019
2-01-003-158-020

CITY OF LORAIN - OHIO
JULY 1 1985
SCALE 1" = 10'-0"

norman r hura & associates

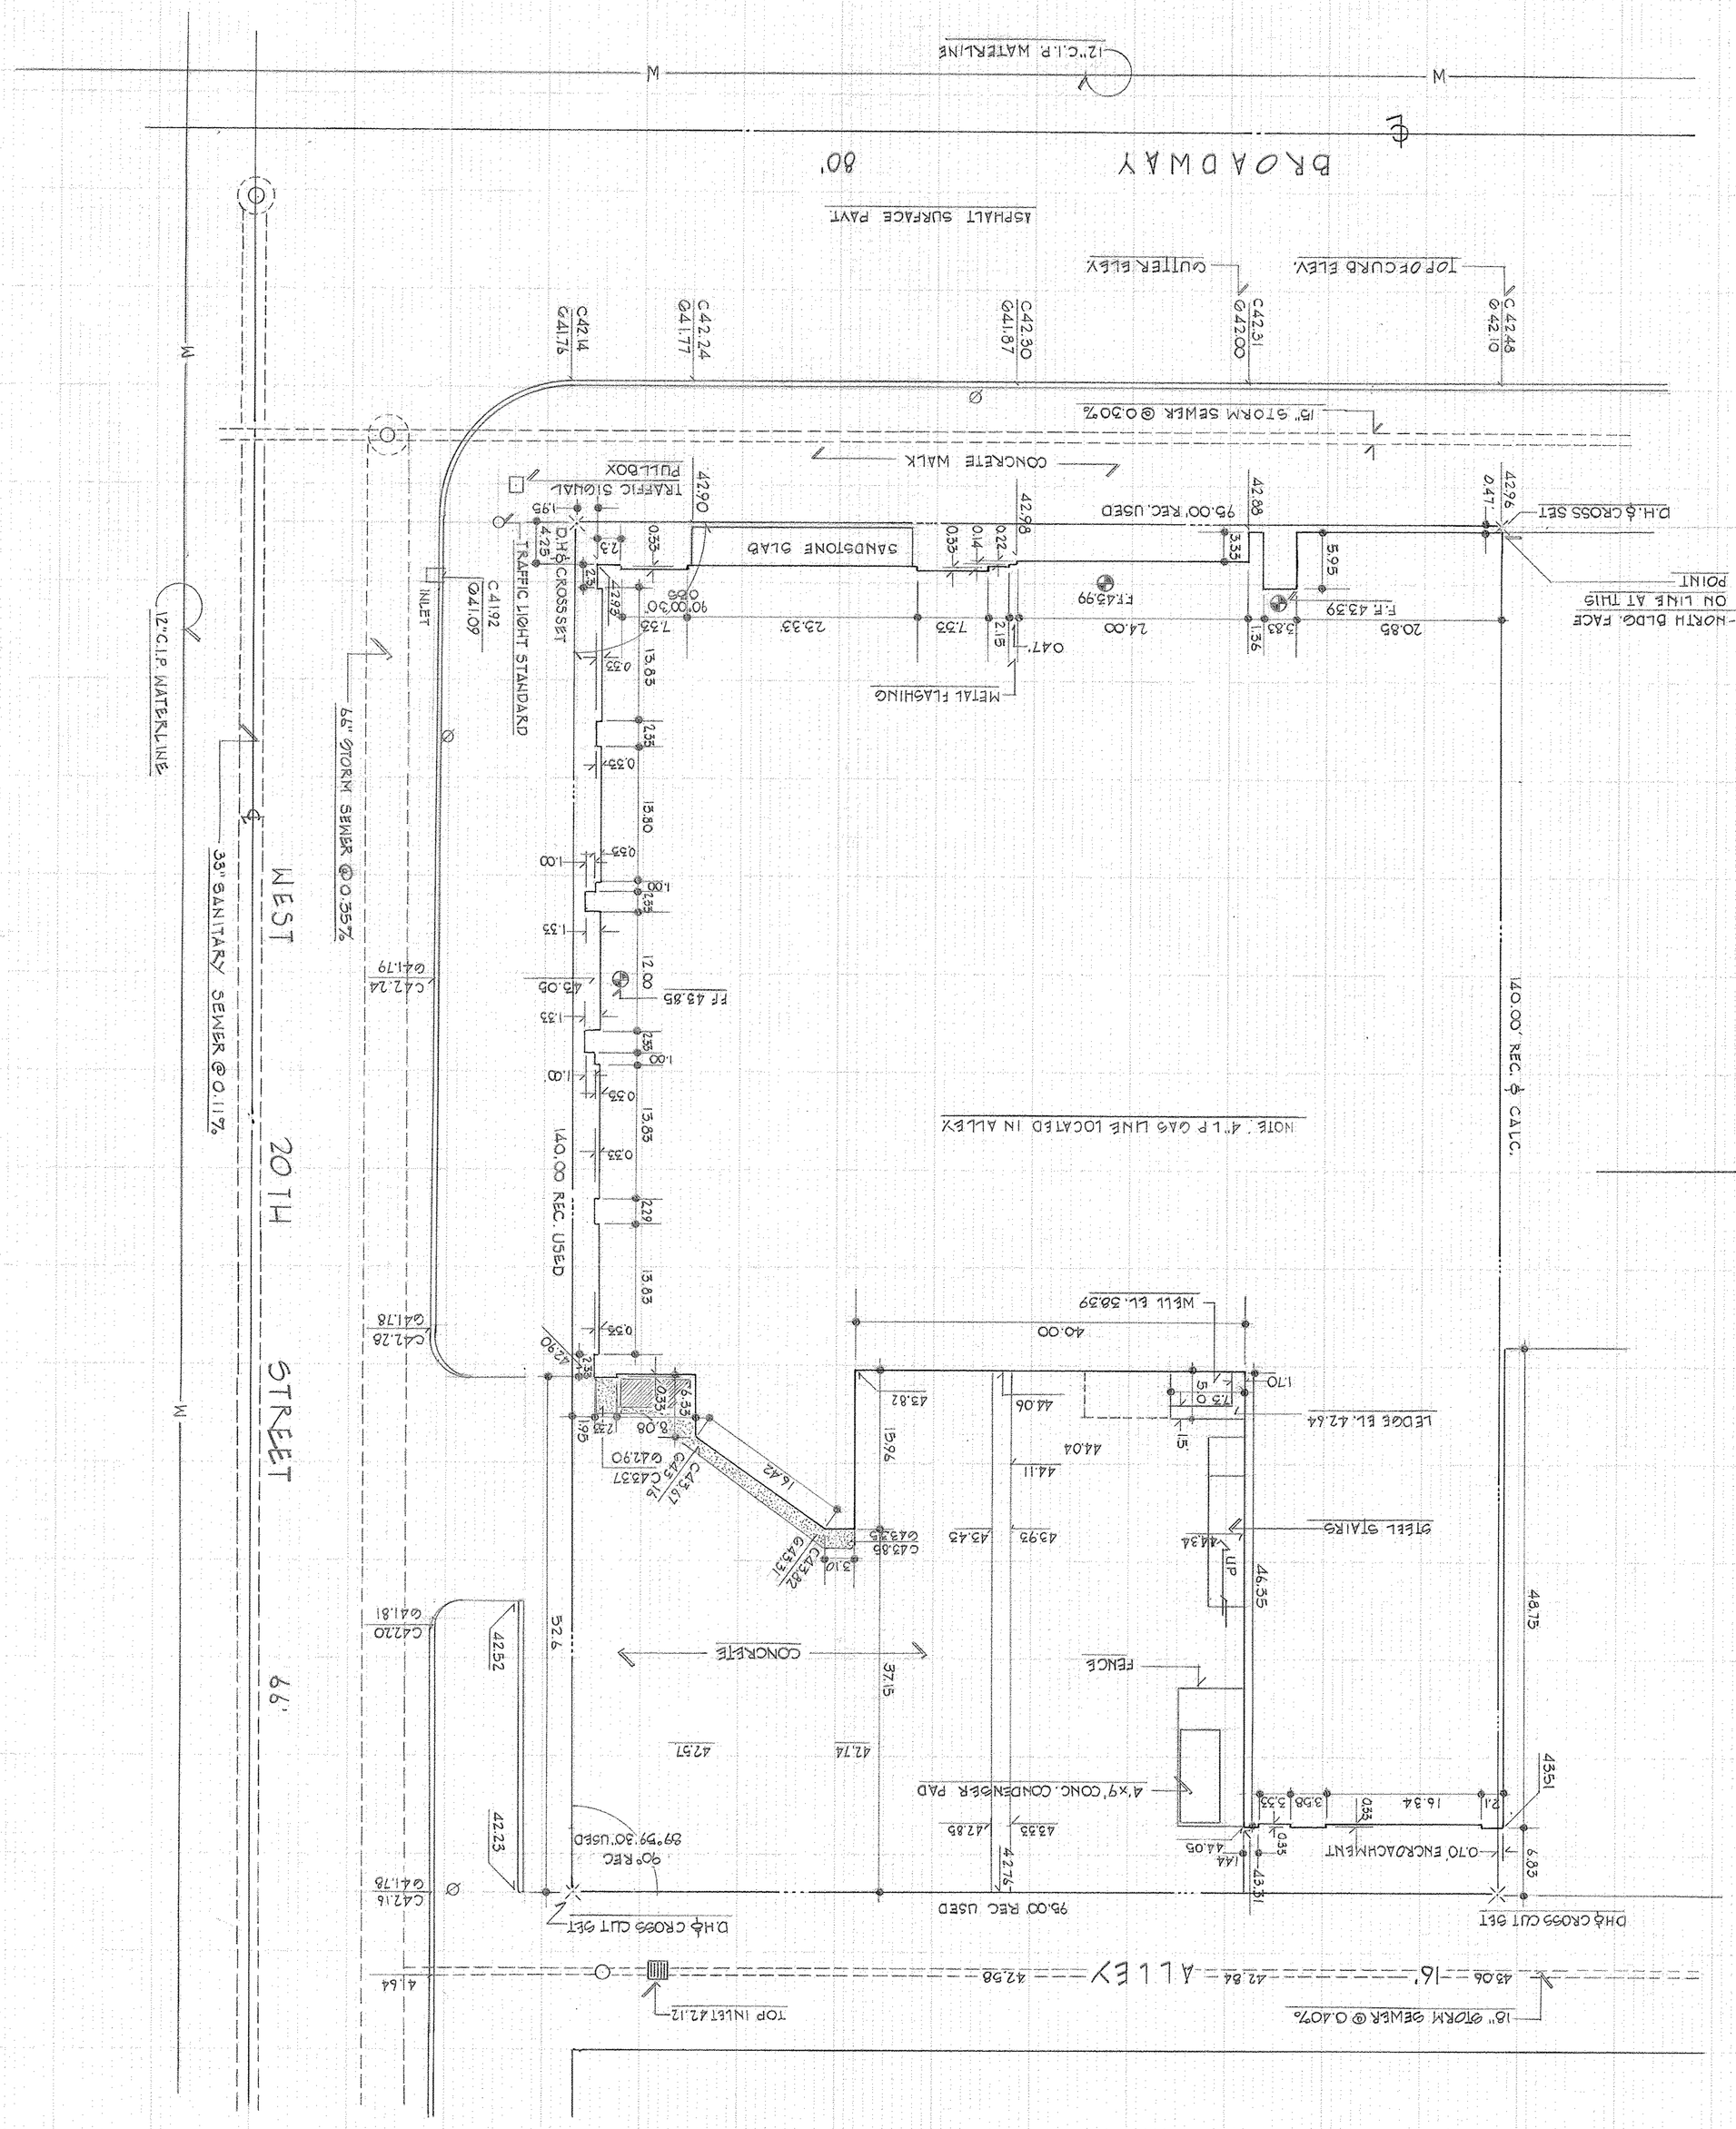

02-01-003-158-
02-01-003-F
Scan # 47749