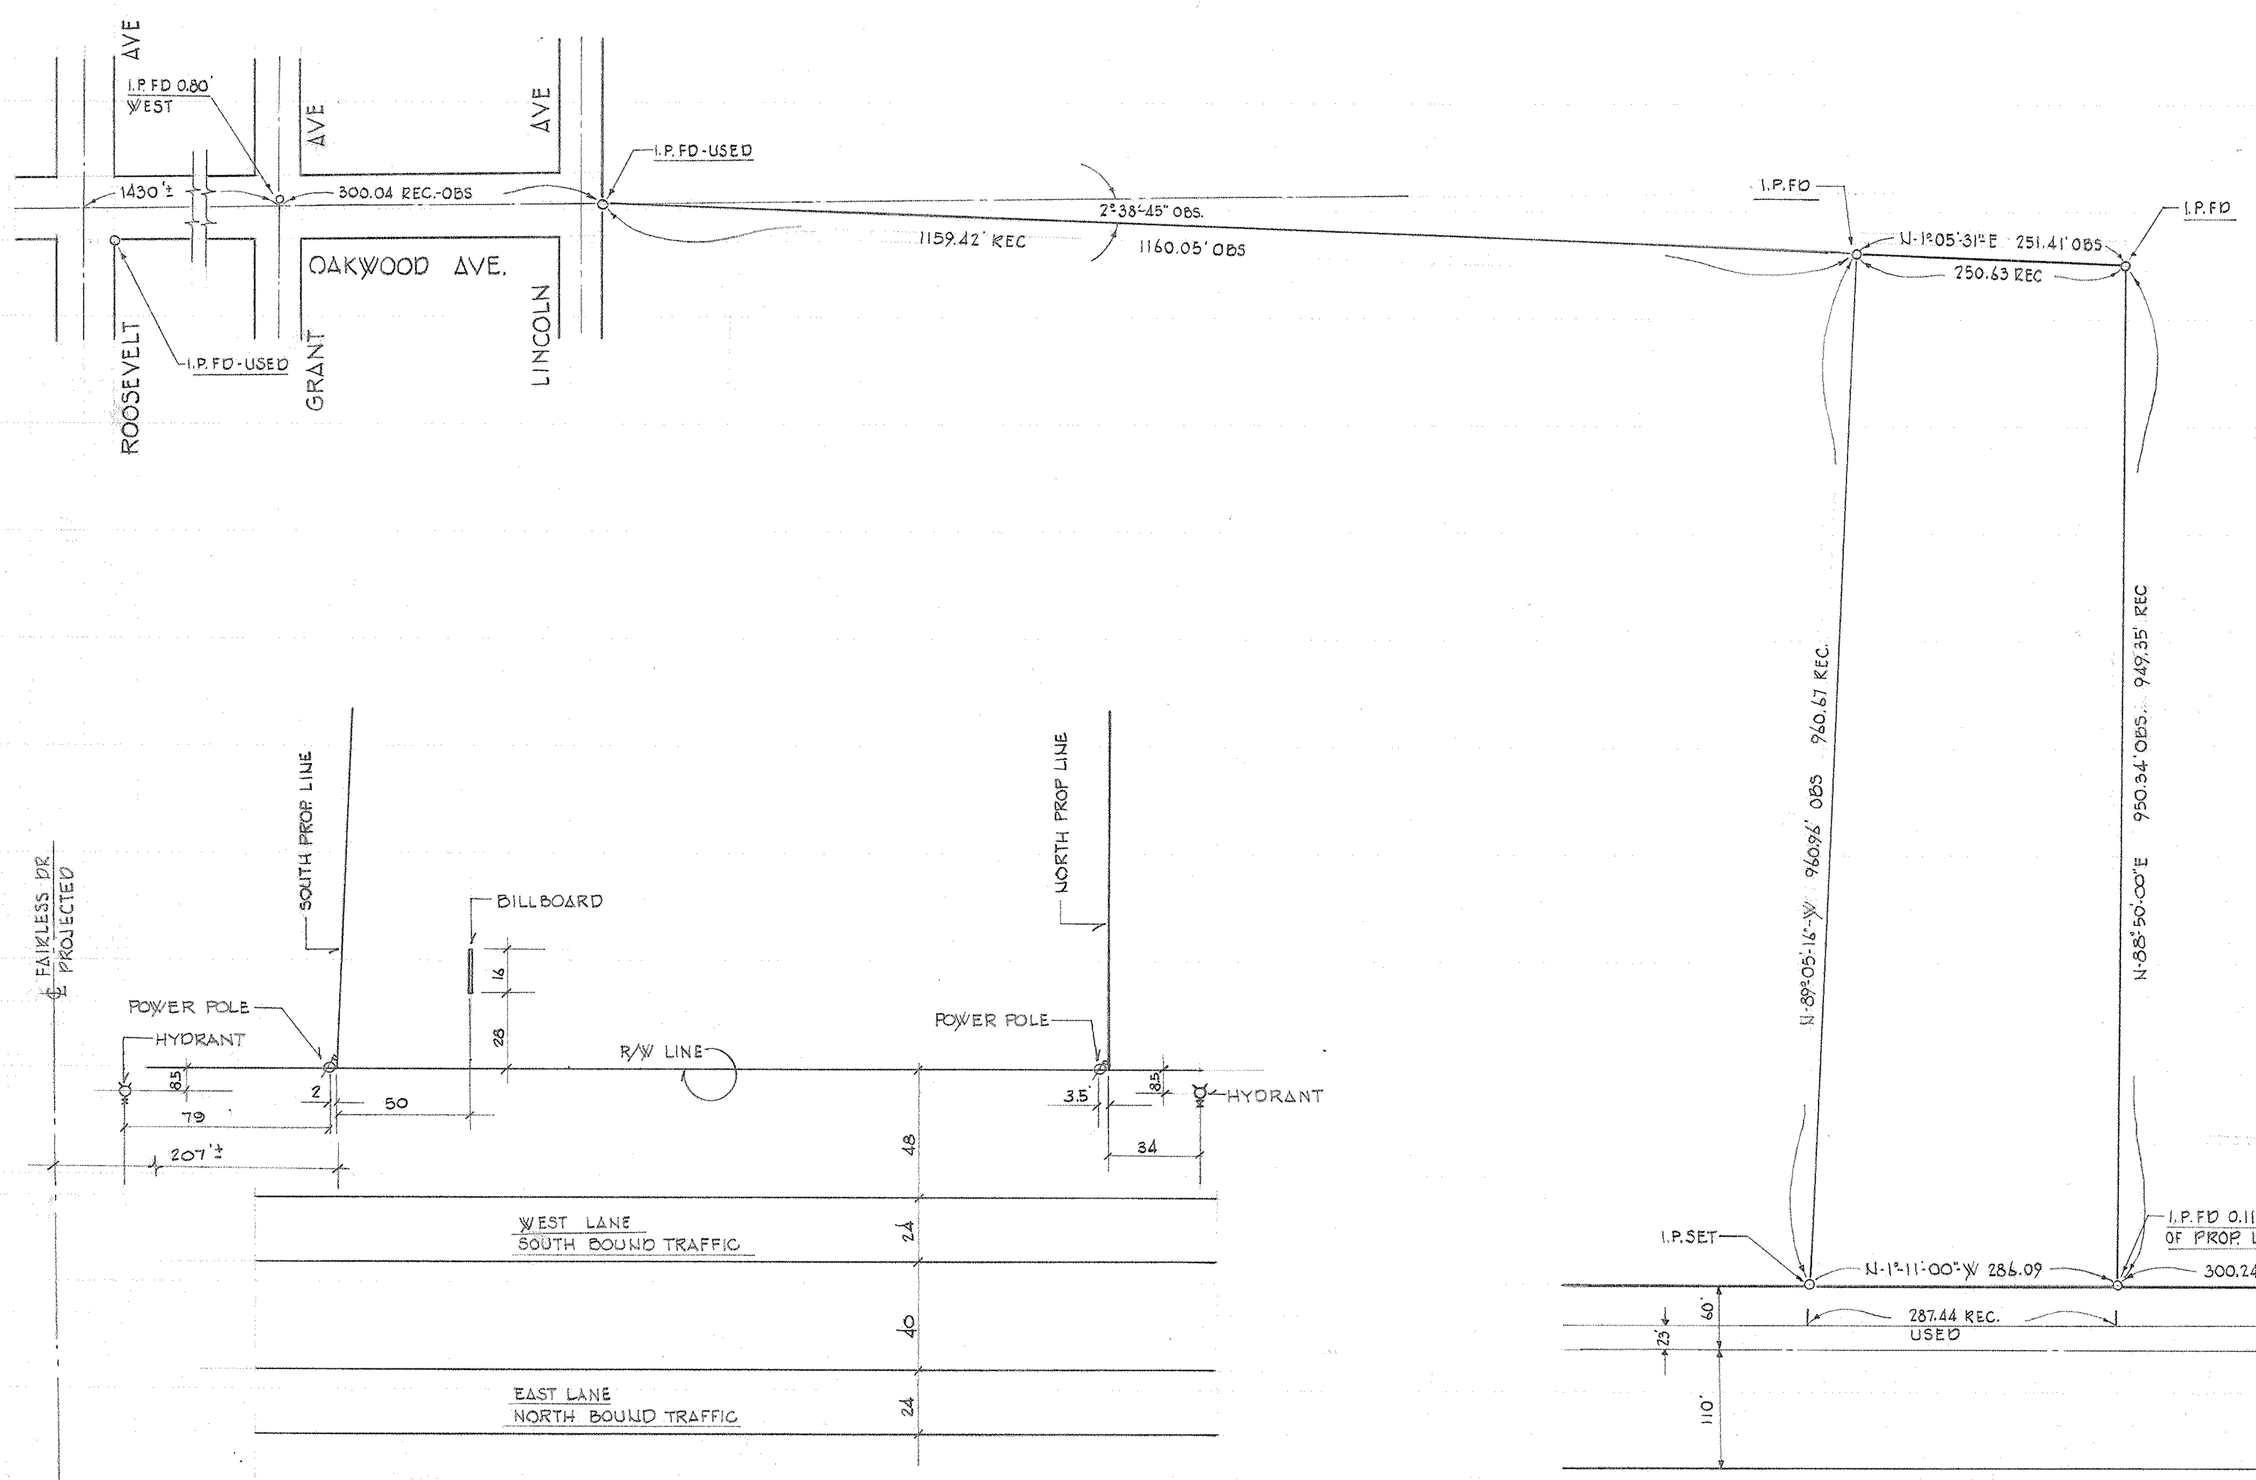

SUPPLEMENTAL PHYSICAL DATA FOR TOPO

1"=40'

PLAT OF SURVEY OF THE
PROPOSED POPLAR CHEVROLET

PREPARED BY

NORMAN R. HURA
REGISTERED SURVEYOR

03-00-104-10 1-
03-00-104-B SCAN # 47751

S-1001