03-00-067-000 -
03-00-066D Scan# 47752

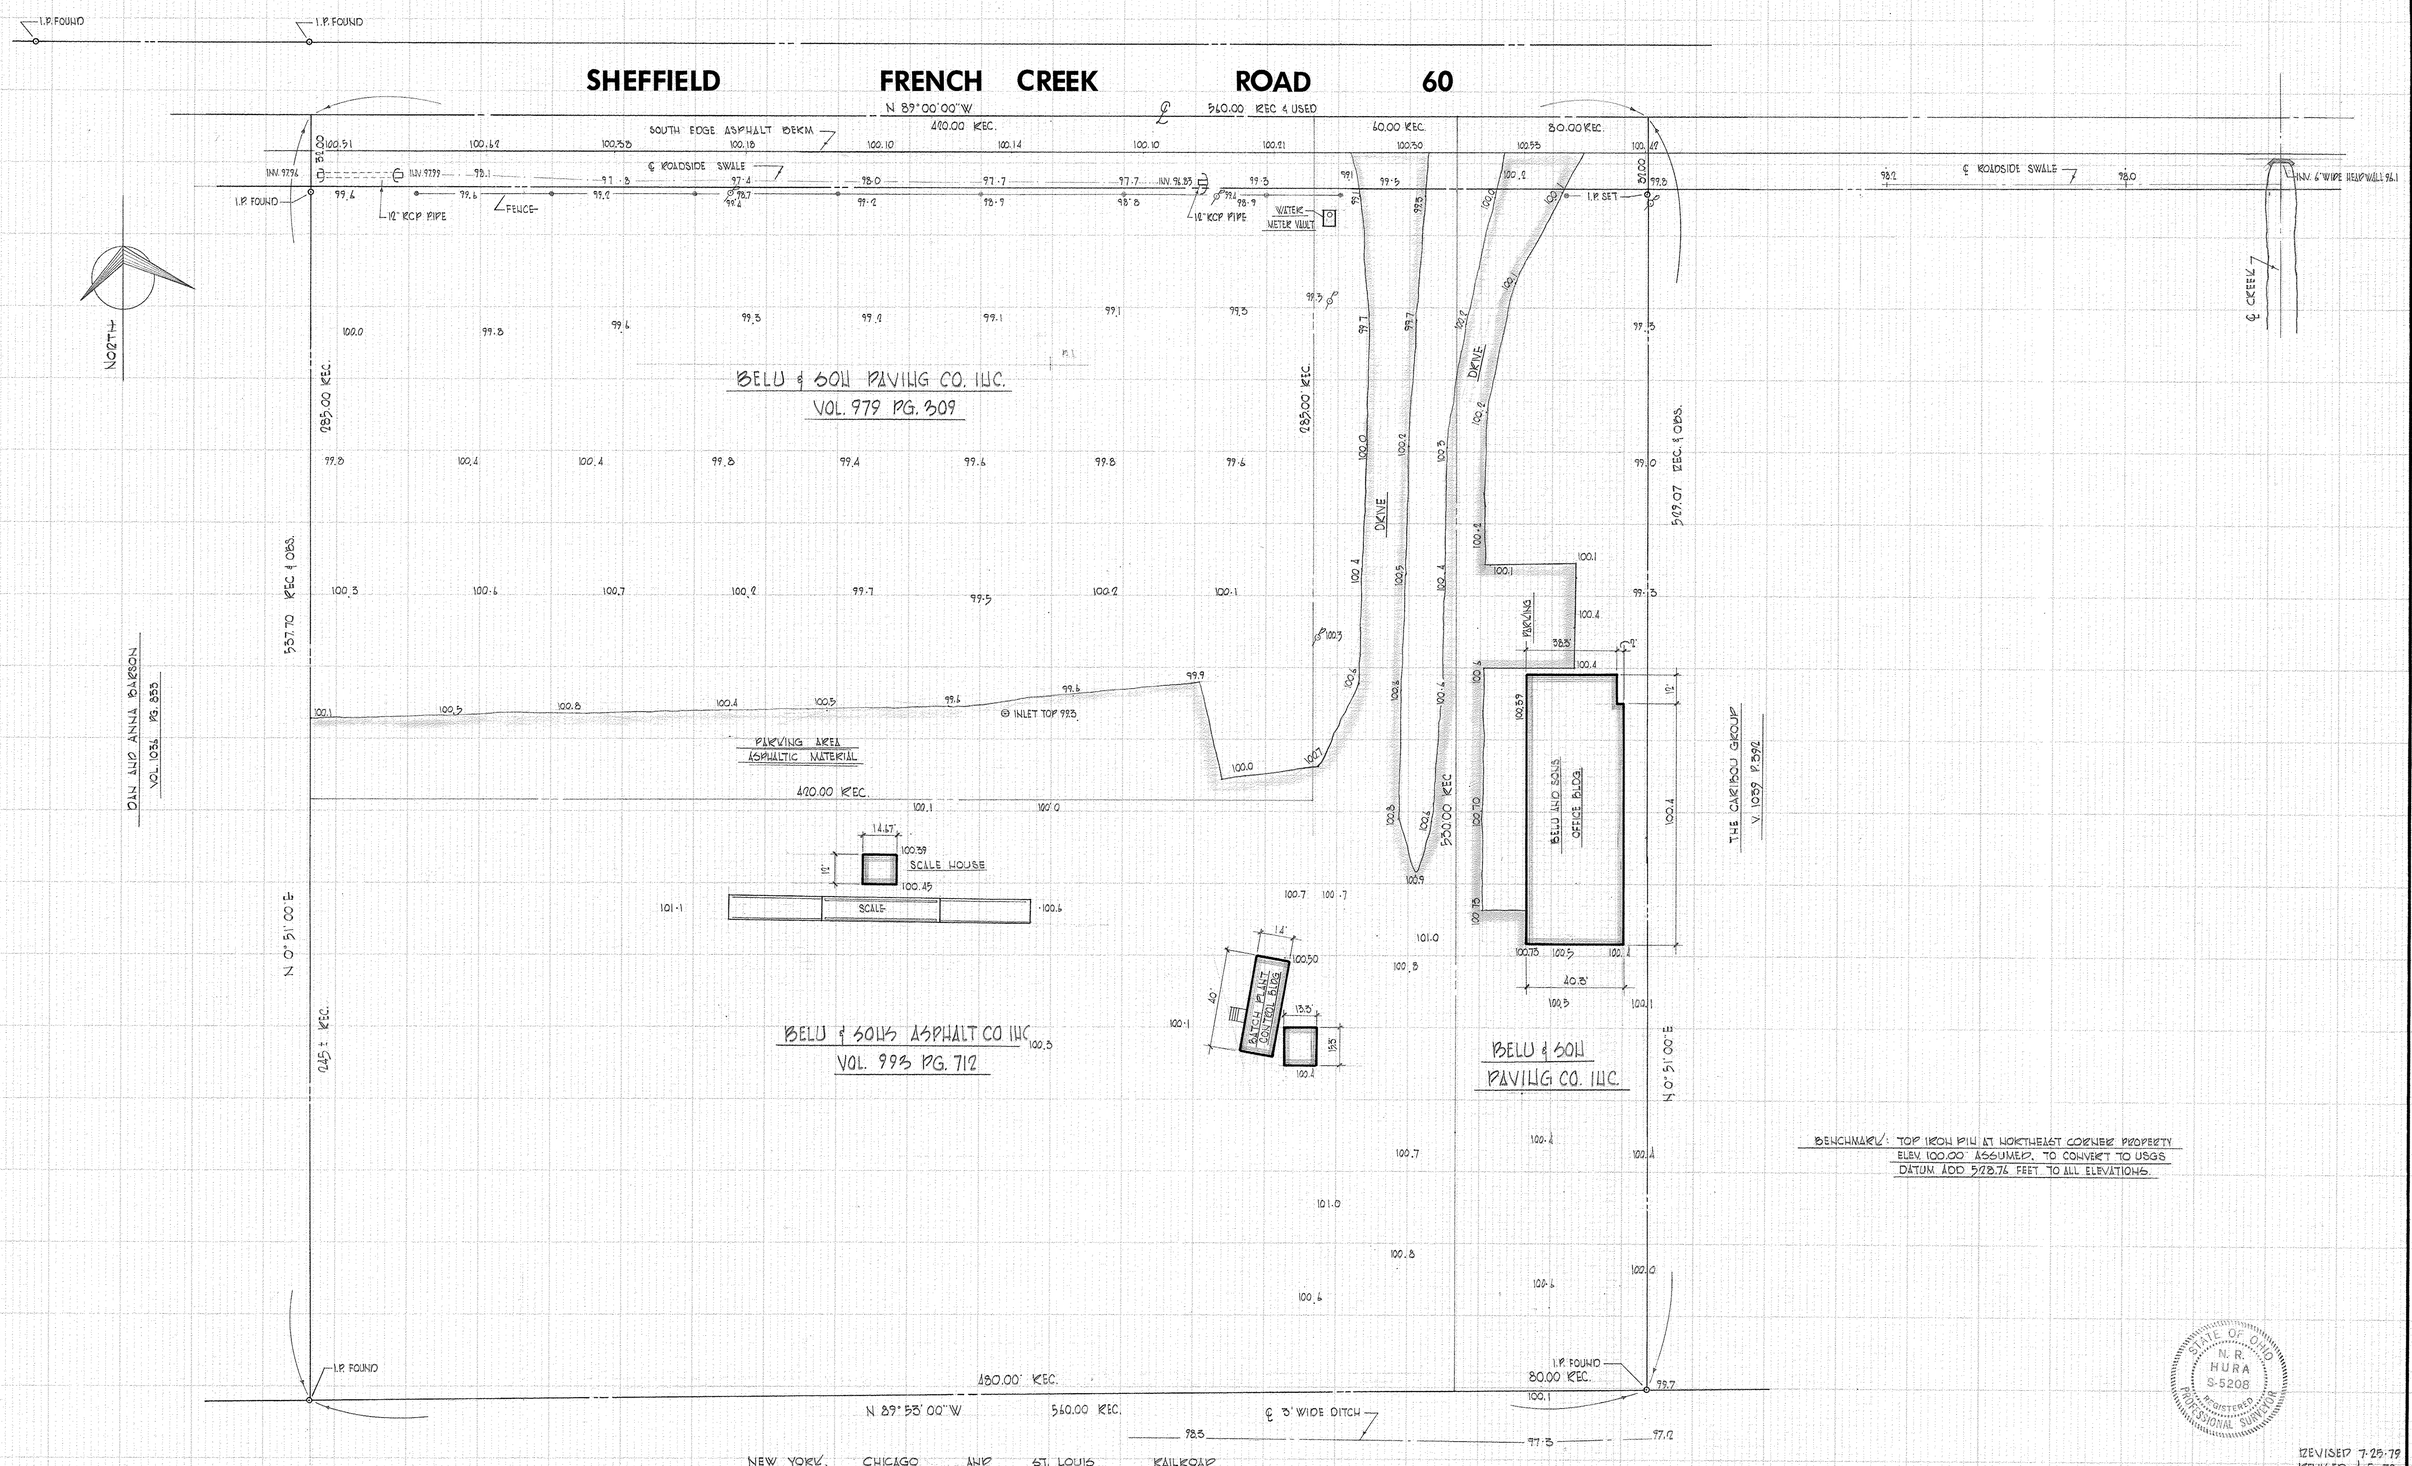


REVISED 7-25-79
REVISED 2-5-78

| | | | | |
|---|---|---|---|---|
| BELU AND SONS<br>FRENCH CREEK ROAD<br>SHEFFIELD, OHIO | SURVEY AND TOPOGRAPHY OF A PART<br>OF SHEFFIELD TOWNSHIP ORIGINAL LOT 67 | PREPARED BY: NORMAN R. HURA AND ASSOCIATES<br>2001 COOPER - FOSTER PARK ROAD<br>AMHERST, OHIO | SCALE: 1"=30'<br>DATE: MARCH 20, 1978 | FIELD BOOK: 13, PGS 5-12<br>DRAWN BY: JFB |

1/1

S 1018