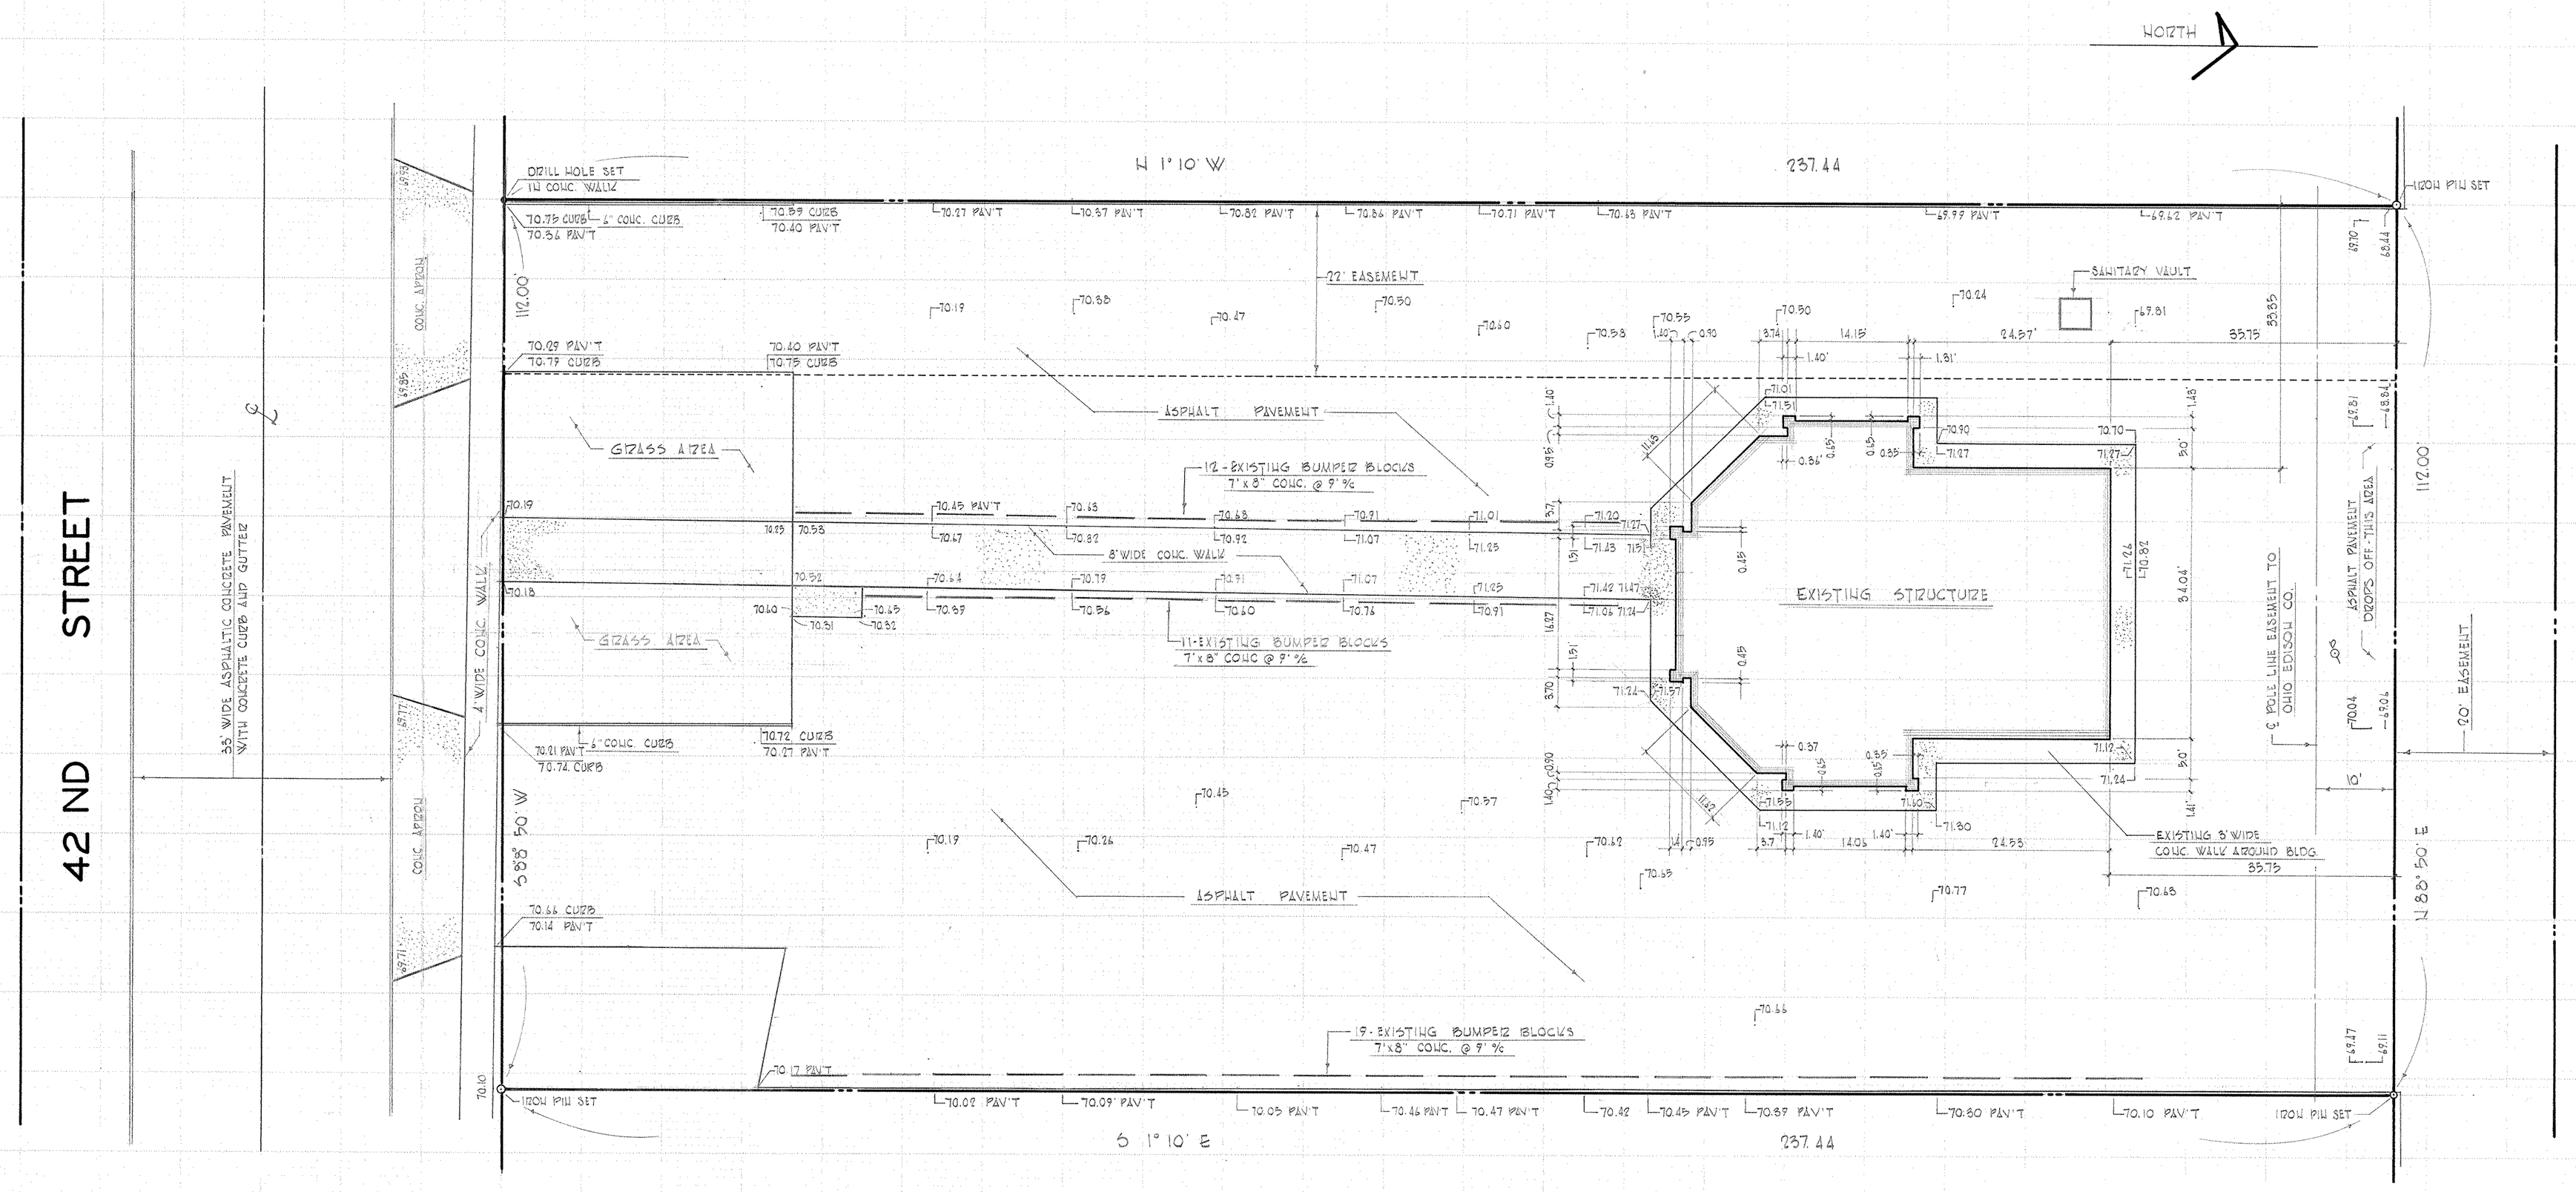

BENCHMARK: NORTHWEST CORNER OF CONCRETE PEDESTAL OF LIGHT STANDARD AT EASTERLY APPROACH TO EXXON GAS STATION CORNER EAST 42ND AND 1ST ST. ELEV. 71.28.

NORMAN R HUDA & ASSOC.
REGISTERED SURVEYOR
LORAIN, OHIO

03-00 099-114
03-00 099-18
SCan # 47193

FIRST FEDERAL SAVINGS AND LOAN LORAIN, OHIO	SURVEY AND TOPOGRAPHY OF A PART OF ORIGINAL SHEFFIELD TOWNSHIP LOT Nº 99 LORAIN, OHIO		DATE: JUNE 6, 1979 SCALE: 1" = 10'

S 1017