02-01-008-101-210
02-01-008-A Scan #47752

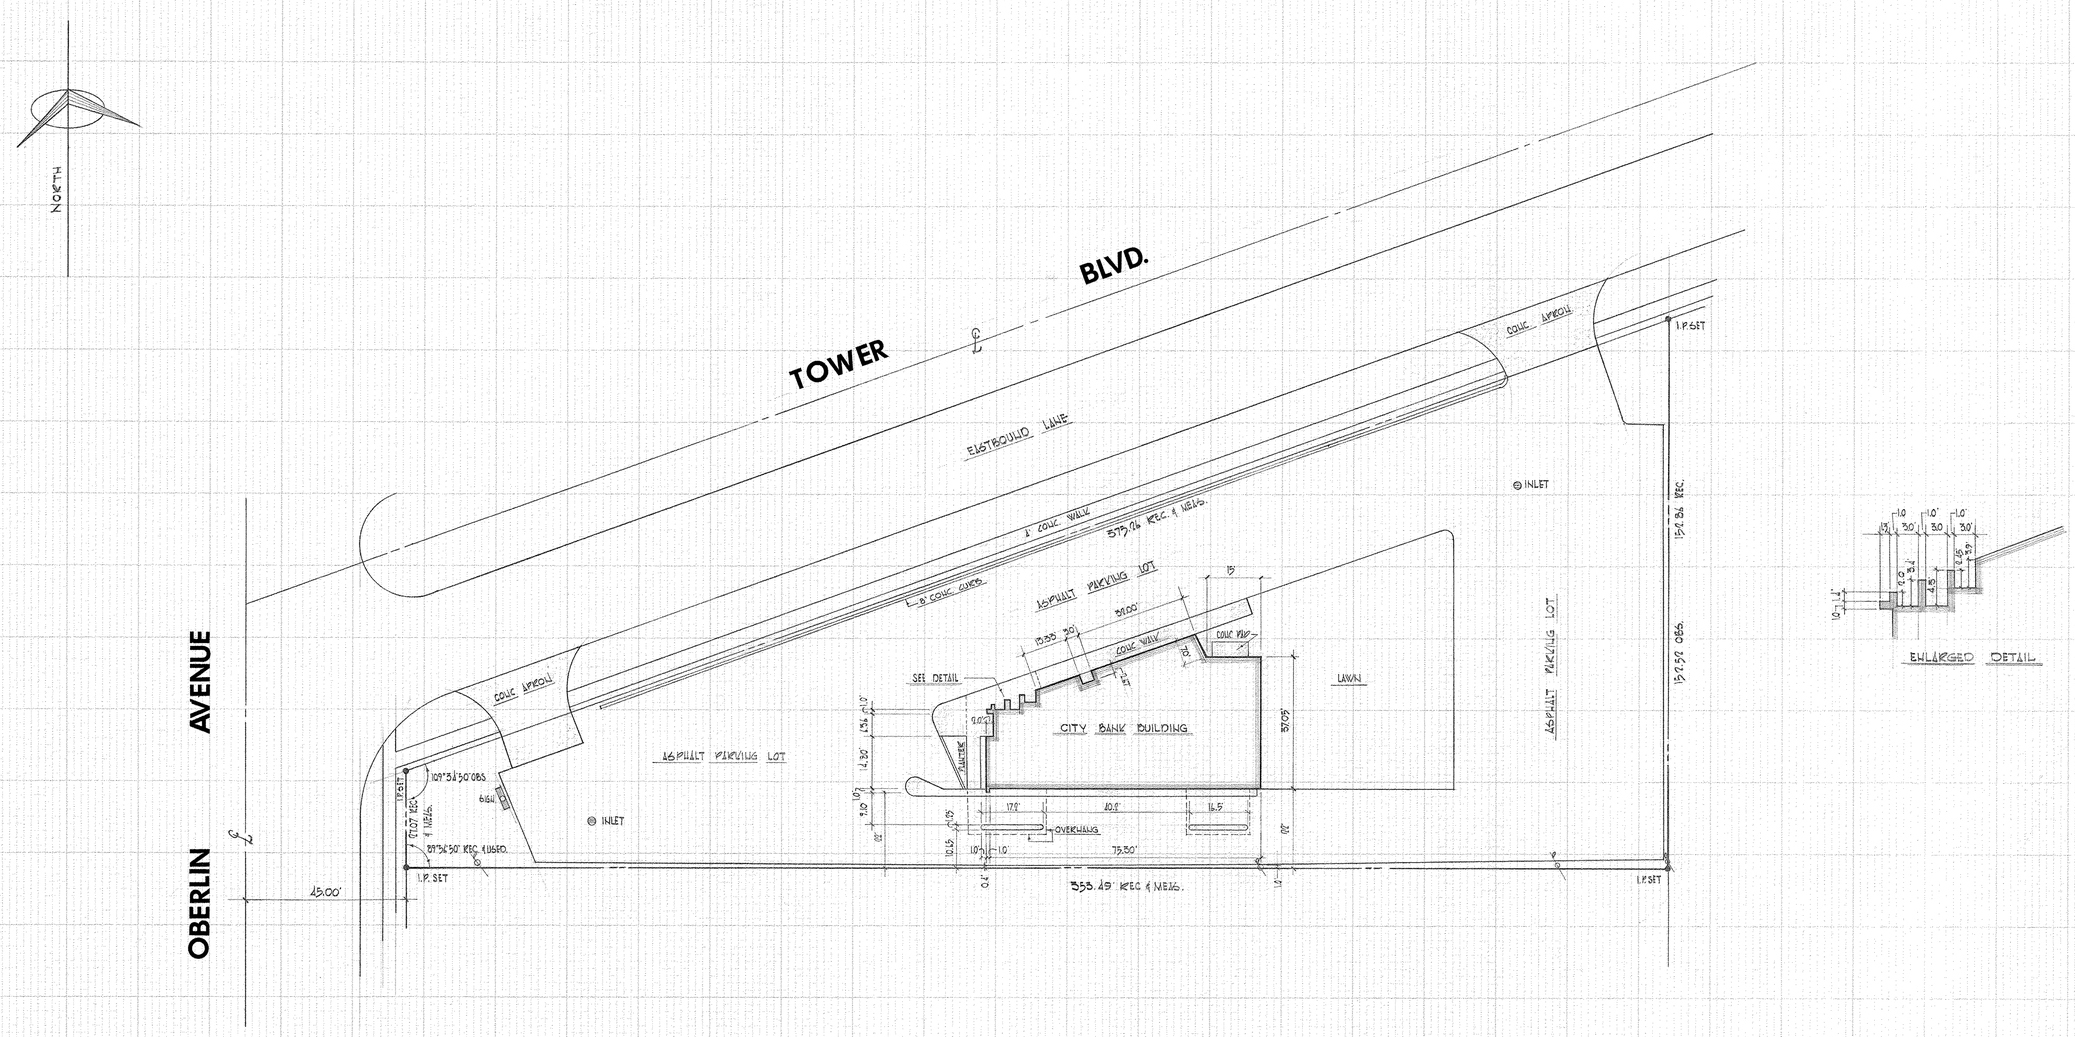

CITY BANK COMPANY TOWER BLVD & OBERLIN AVE LORAIN, OHIO	SURVEY & LOCATIONS PART OF BLACK RIVER TOWNSHIP LOT No 8 TRACT No 1	NORMAN R HURD & ASSOCIATES 2001 COOPER-FOSTER PARK ROAD AMHERST, OHIO	SCALE: 1"=20' DATE: MARCH 27, 1978	DR: JFK DWG 1 OF 1

S 1003