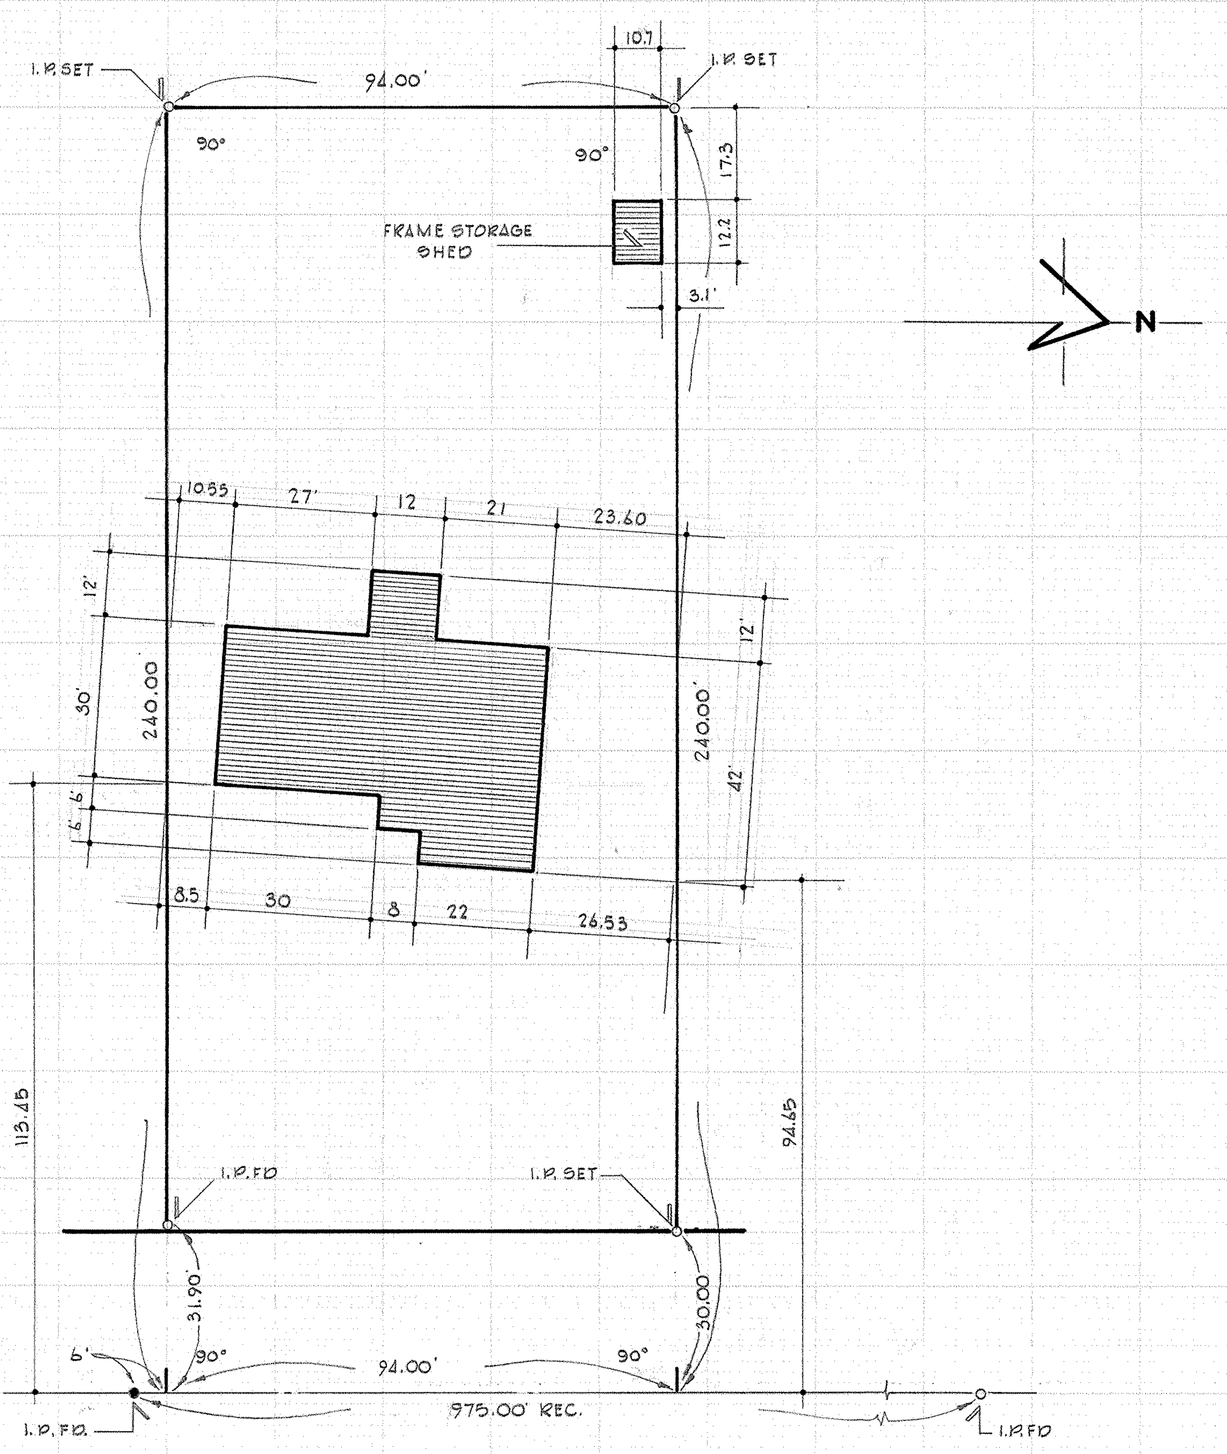

OAK POINT ROAD

OUTLINE AND LOCATION SURVEY – PART OF
ORIGINAL LOT NO. 1 OF AMHERST TOWNSHIP
LORAIN COUNTY OHIO FEB 1980
SCALE 1" = 20'

MICHAEL M. & BELINDA I. DRAGE 5950 OAK POINT

NORMAN R HURA AND ASSOCIATES
REGISTERED SURVEYOR

6901 S

05-00-001-000-053
05-00-001-6
Scan # 17787