03-00-113-104-115, -116
03-00-113-A Scan# 47791

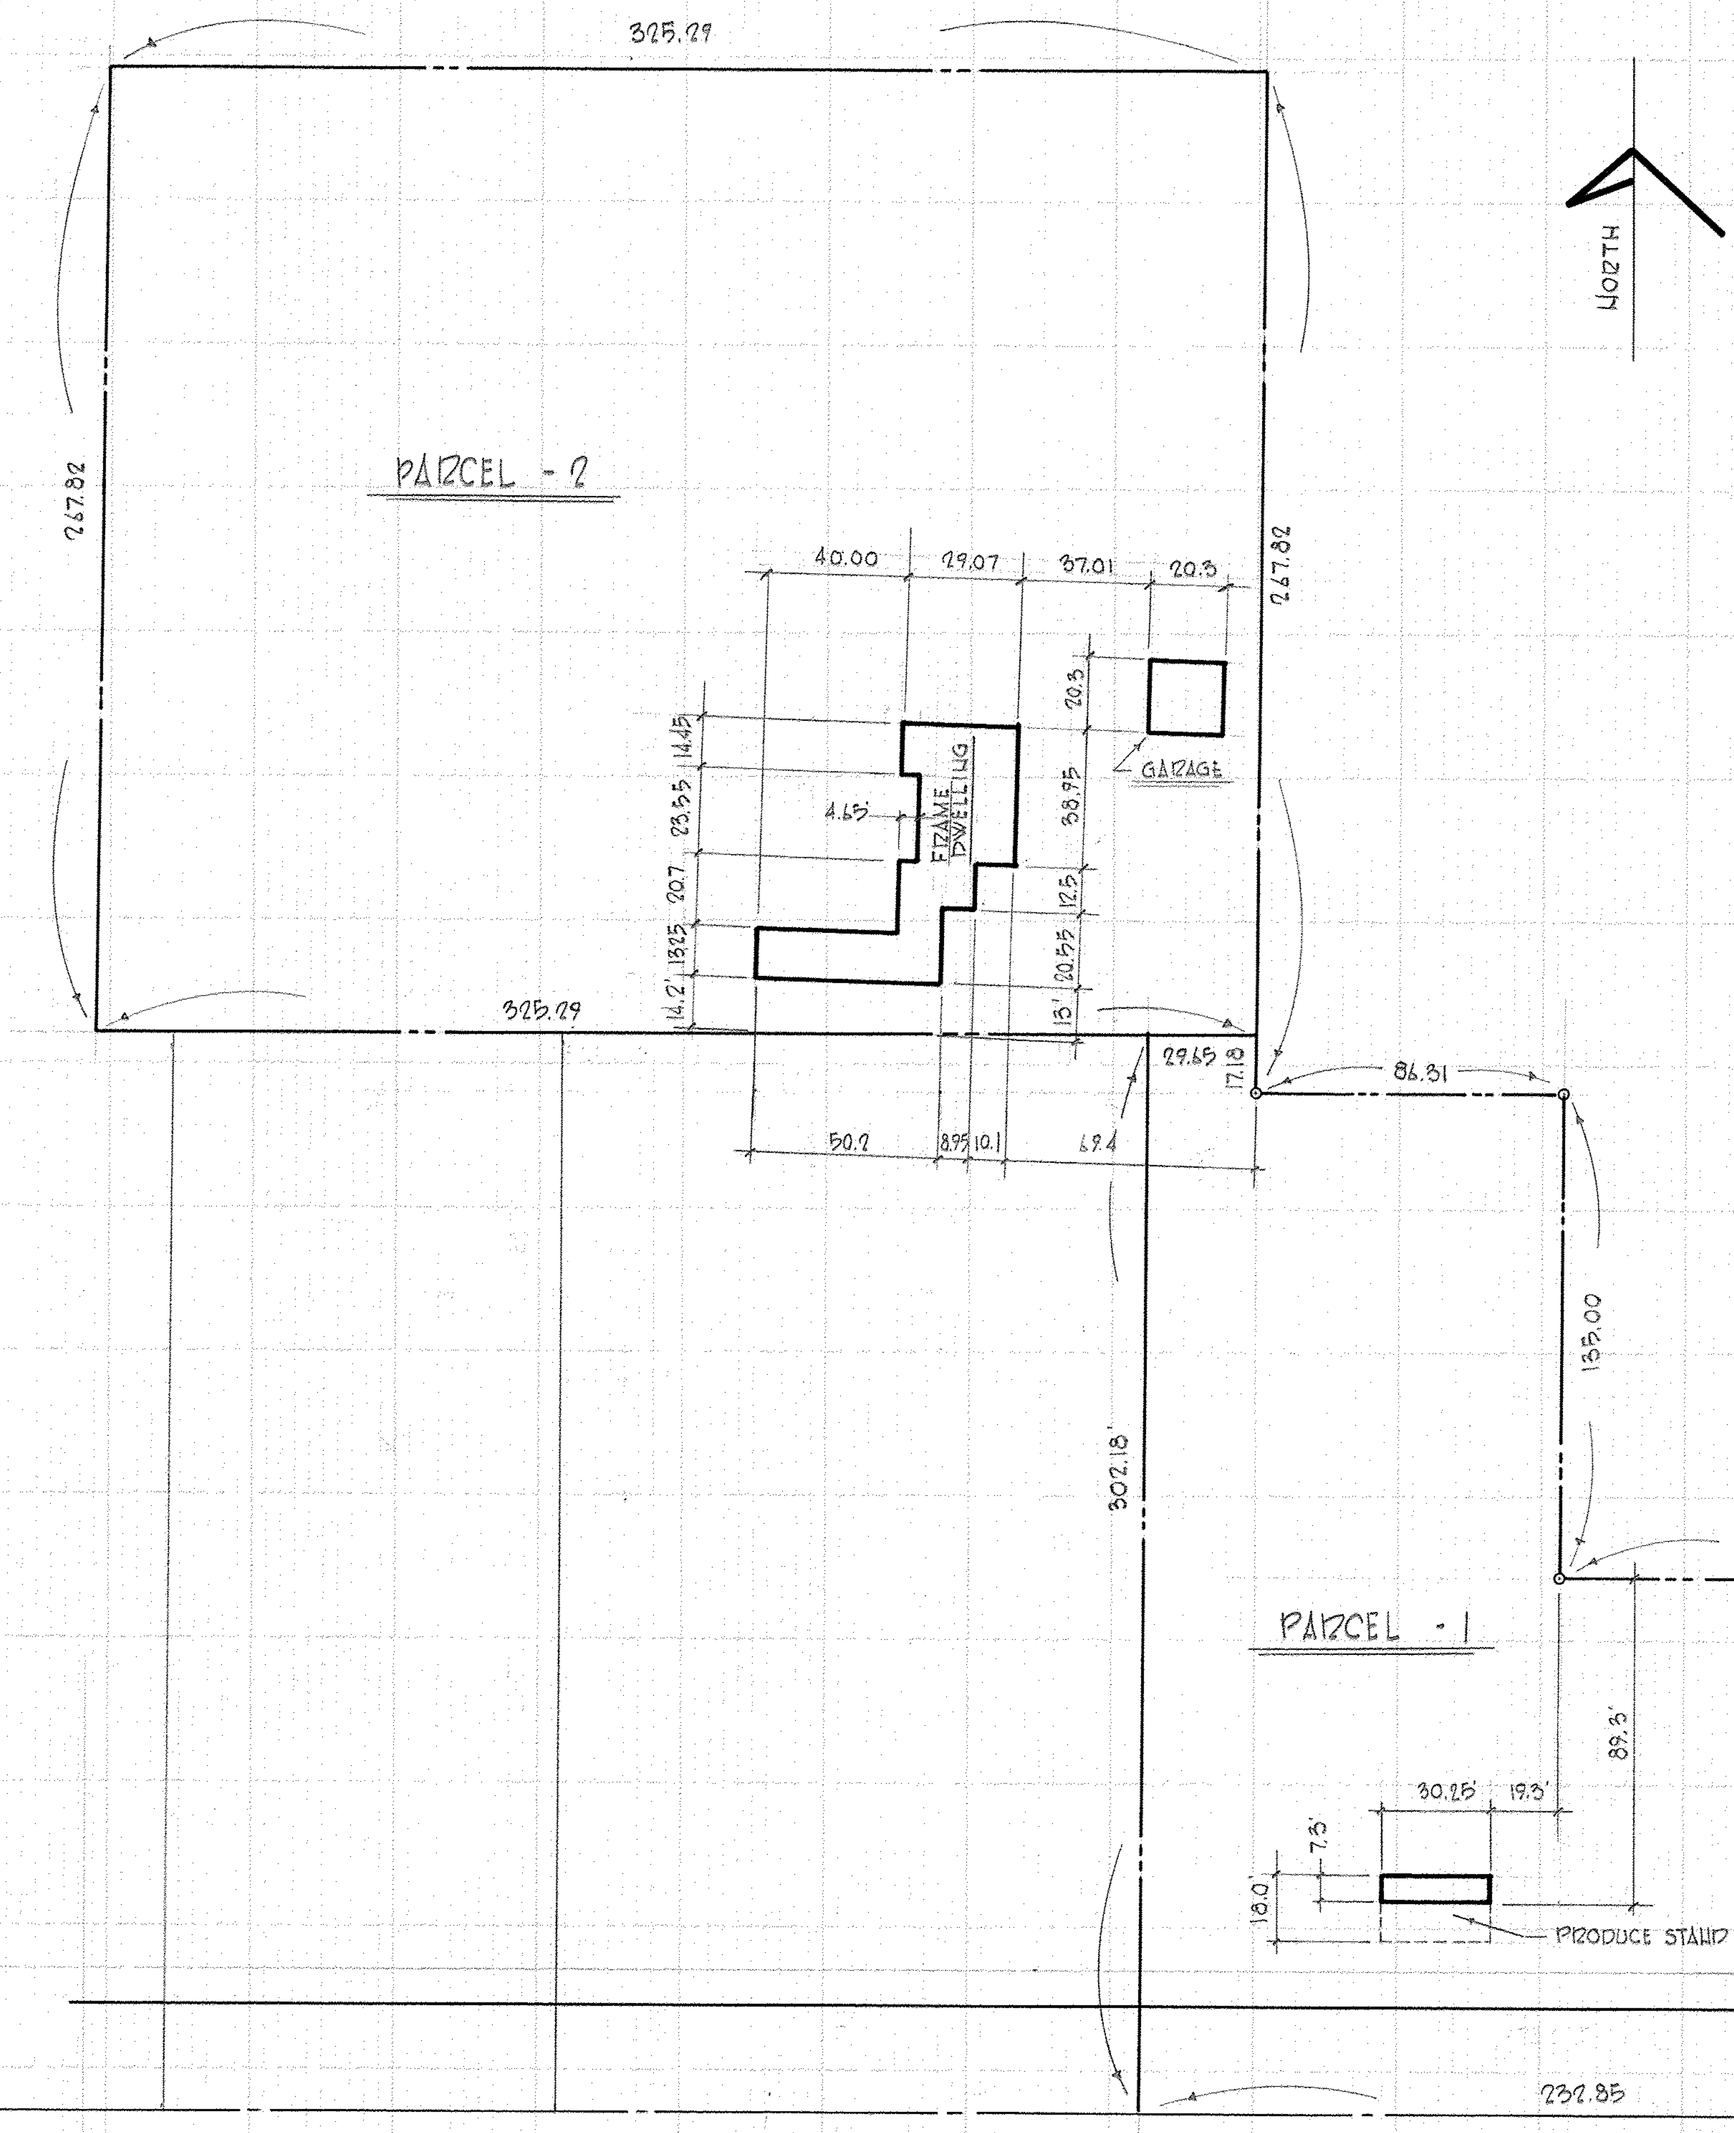

NOT A PLAT OF SURVEY, FOR MORTGAGE PURPOSES ONLY

NORMAN R. HUZA & ASSOC
REGISTERED SURVEYOR

PLOT PLAN OF A PART OF ORIGINAL SHEFFIELD TOWNSHIP LOT 113

PREPARED FOR
OHIO BAR TITLE

SCALE: 1" = 40'
JUNE 27, 1979

S 1075