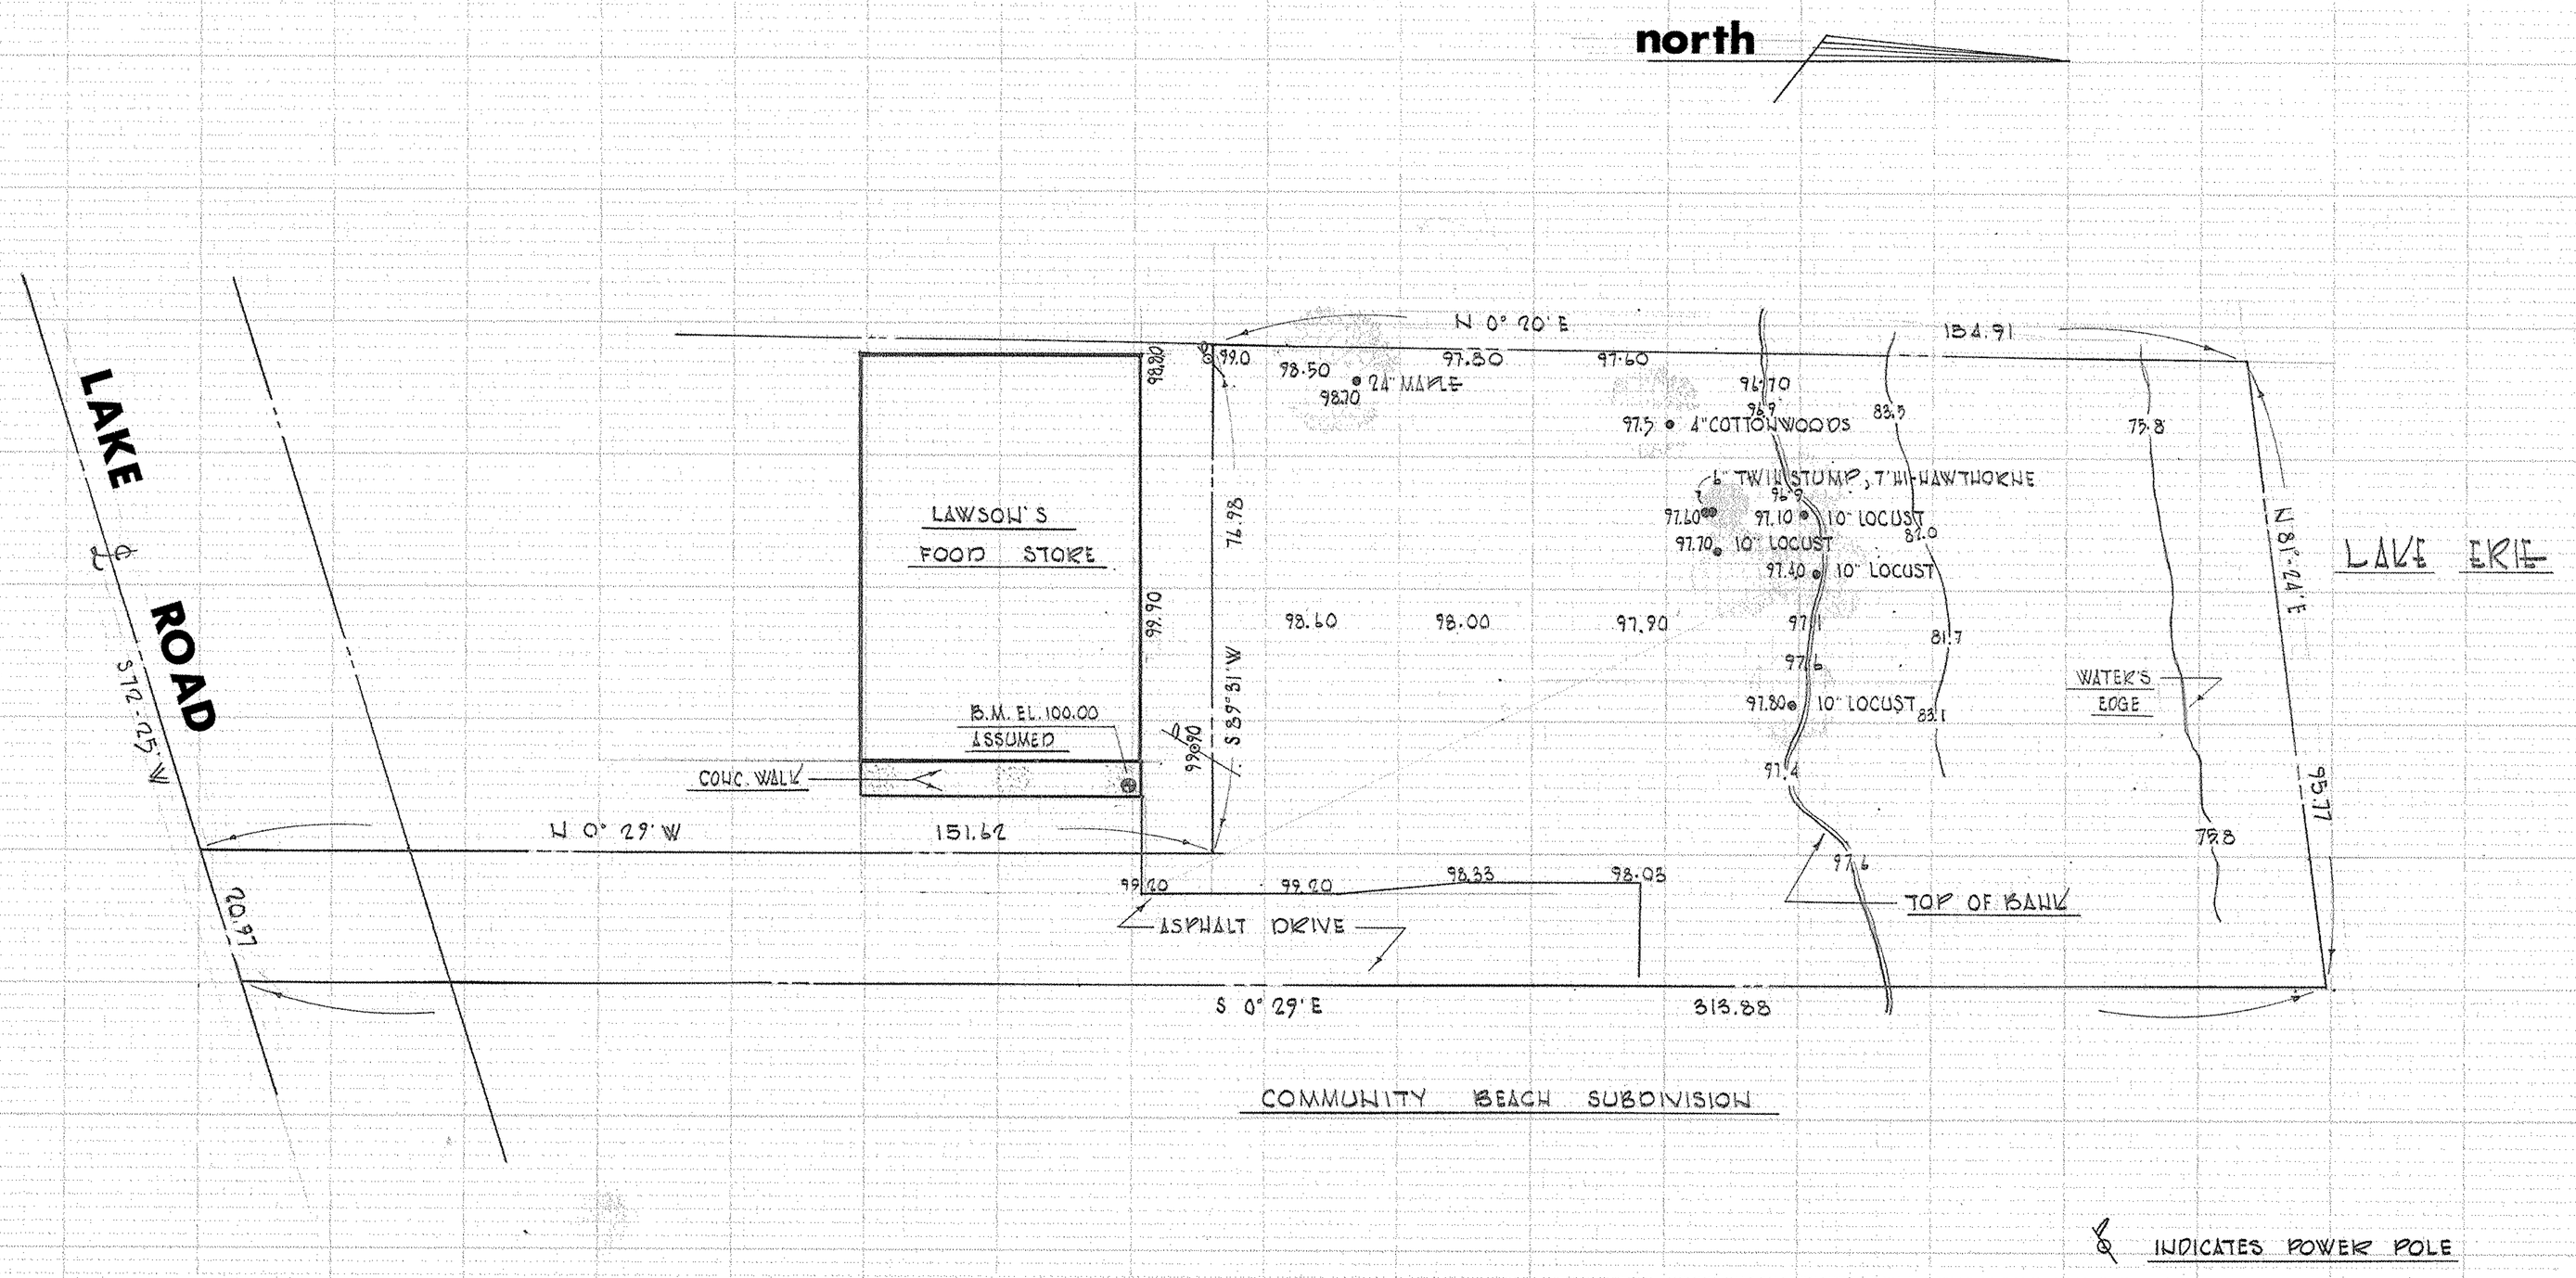

NOT A PLAT OF BOUNDARY SURVEY, PROPERTY LINE DATA TAKEN FROM RECORDS.

REVISED NOV. 8, 1978
REVISED NOV. 6, 1978

ATTORNEY DONALD CAREK LAKE ROAD SHEFFIELD LAKE, OHIO	TOPOGRAPHICAL SURVEY OF A PART OF ORIGINAL SHEFFIELD TOWNSHIP LOT NO. 41, SHEFFIELD LAKE, OHIO	PREPARED BY: NORMAN R. HURA & ASSOC. 2001 COOPER FOSTER PARK RD AMHERST, OHIO	SCALE: 1" = 20' DATE: AUGUST 1978

03-00-041-101-020, -021
03-00-041 Scan # 47793

S1076