


ASHWOOD ACRES
SUBDIVISION NO. 1

ASHWOOD ACRES SUBDIVISION NO. 2

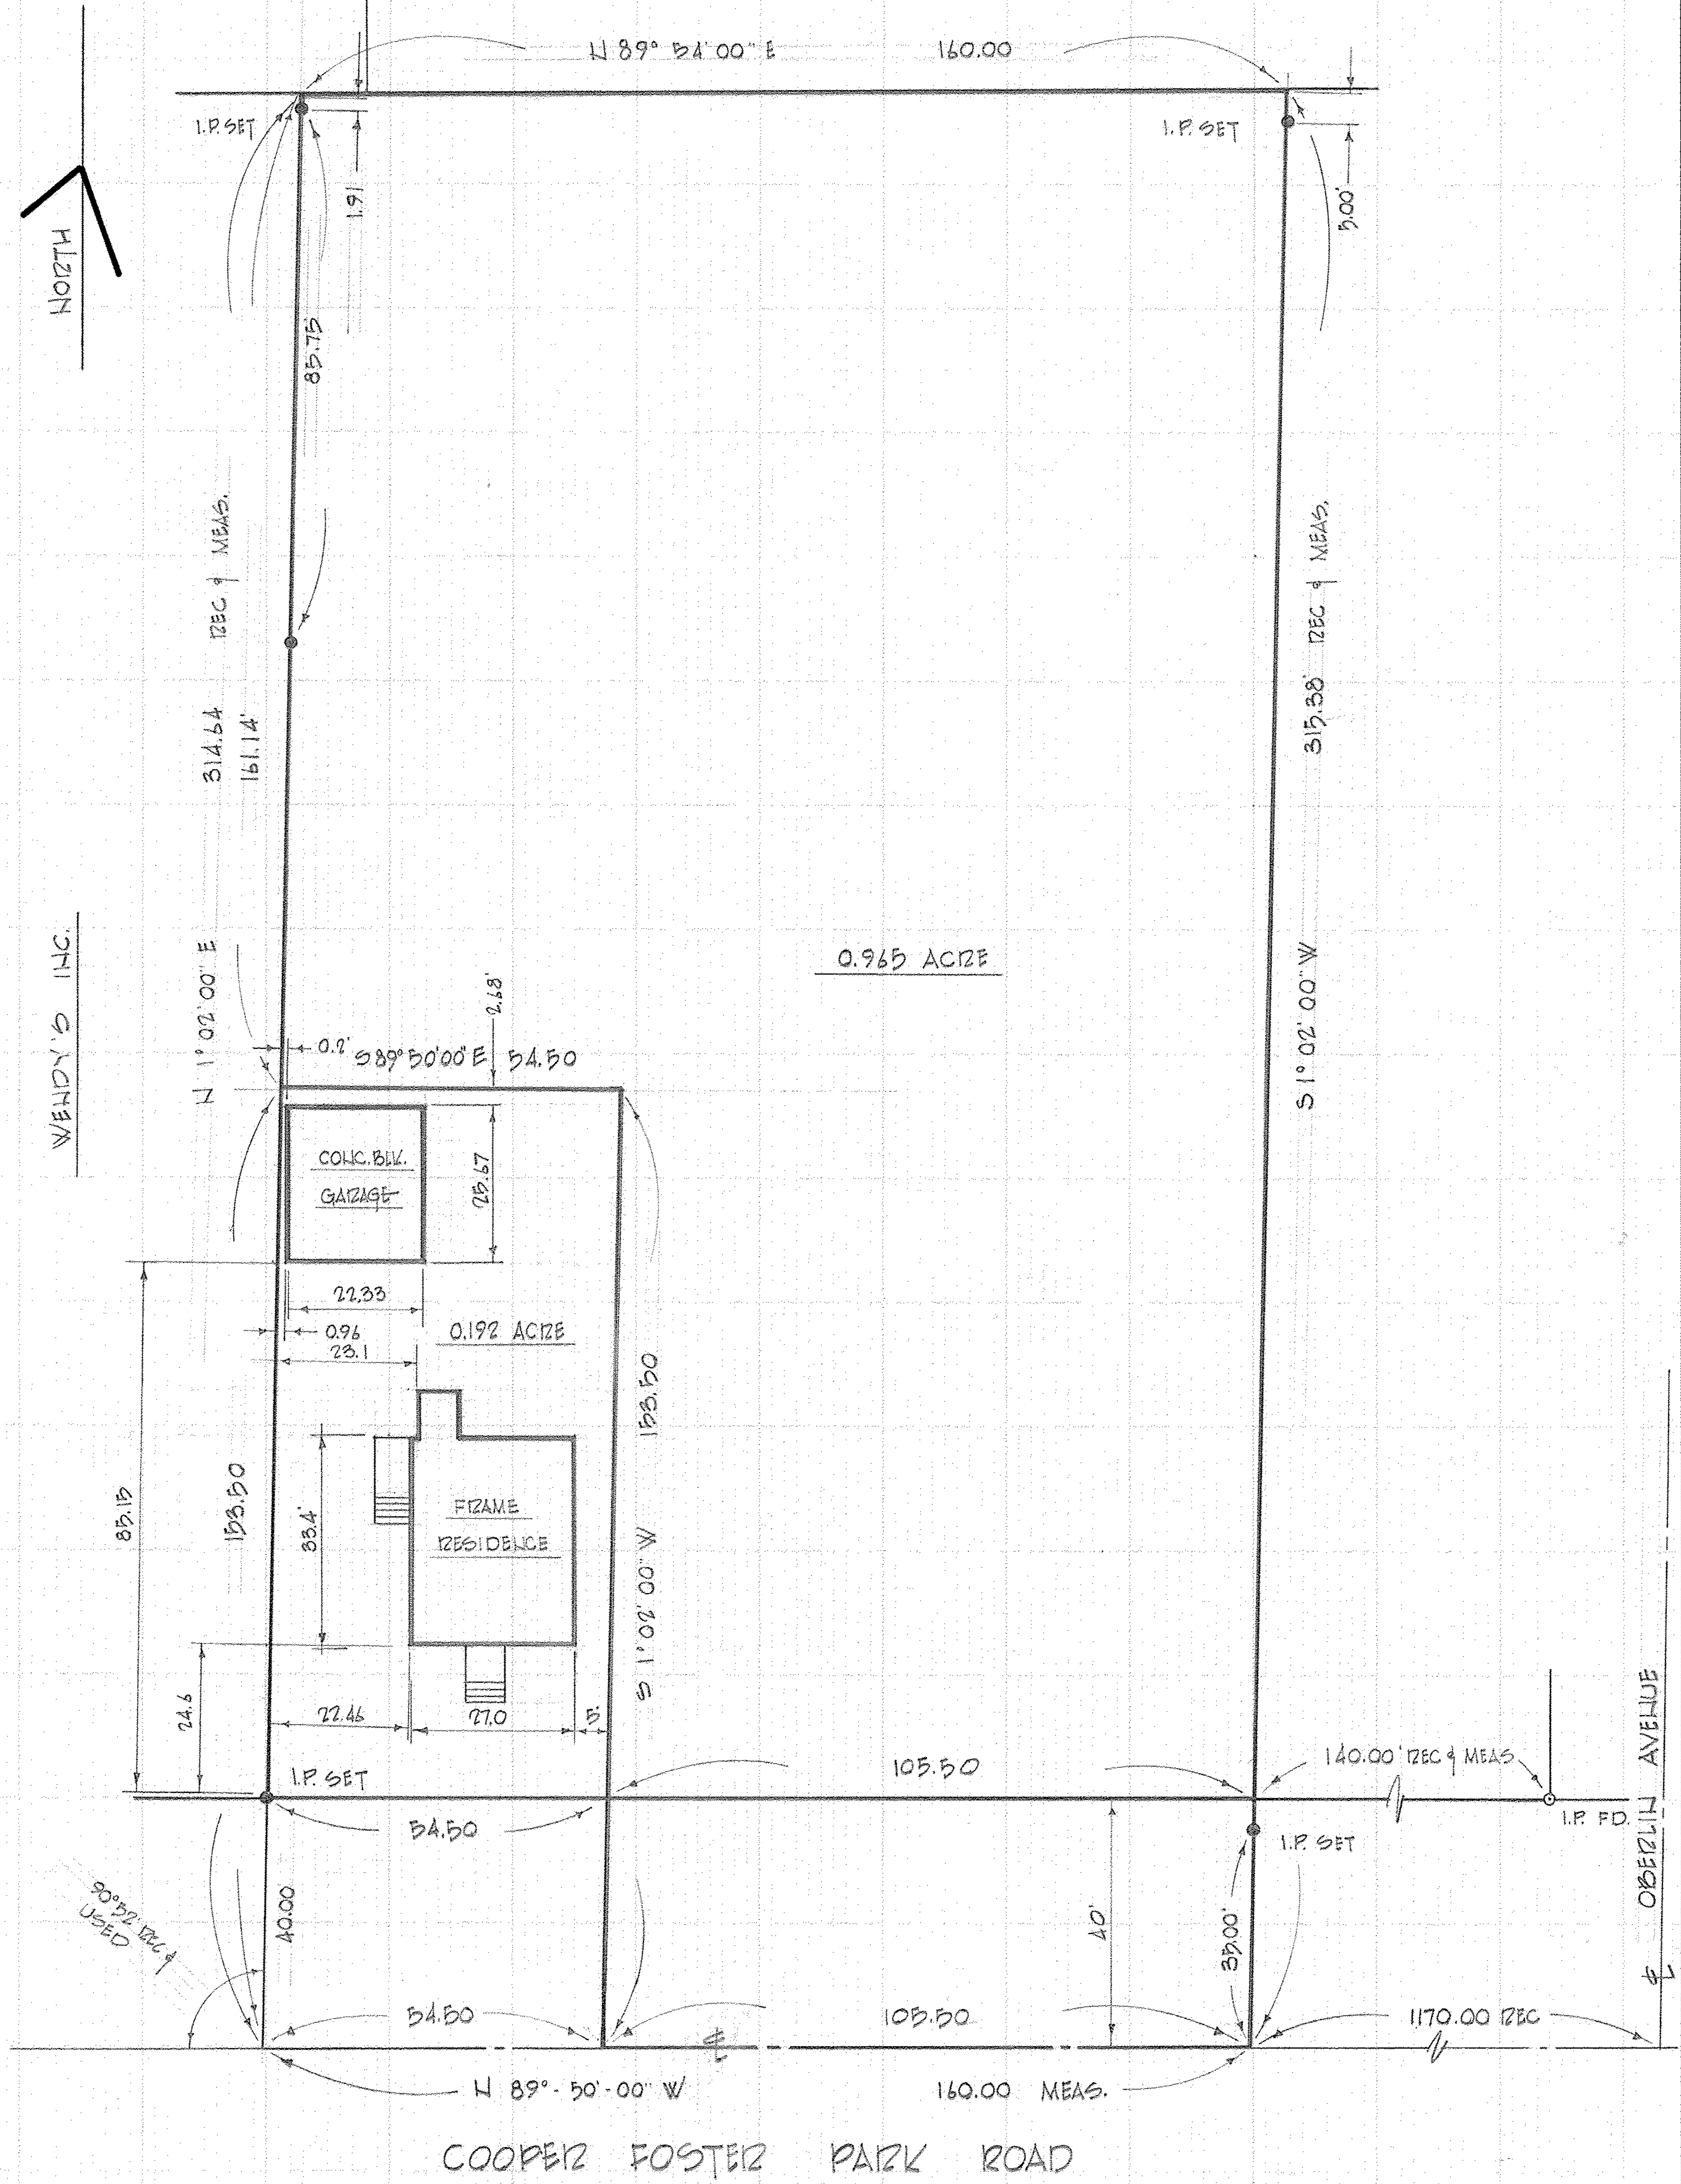

SEPT. 26, 1980
SCALE: 1"=20'

SURVEY OF A PART OF ORIGINAL BLACK
RIVER TOWNSHIP LOT NO. D TRACT NO. 2

TERRY MILLER CARPET
AMHERST, OHIO