


SPLIT PARCEL NO.1 1.519 ACRES
 SPLIT PARCEL NO.2 1.135 ACRES
 RESIDUAL 0.511 ACRES
BD. OF COMMISSIONERS 0.458 ACRES
 TOTAL 1981 SURVEY 3.623 ACRES

REVISED 10-26-84
 ADDED SPLIT PARCEL 1
 REVISED 10-25-87
 ADDED SPLIT PARCEL 2

5-1103

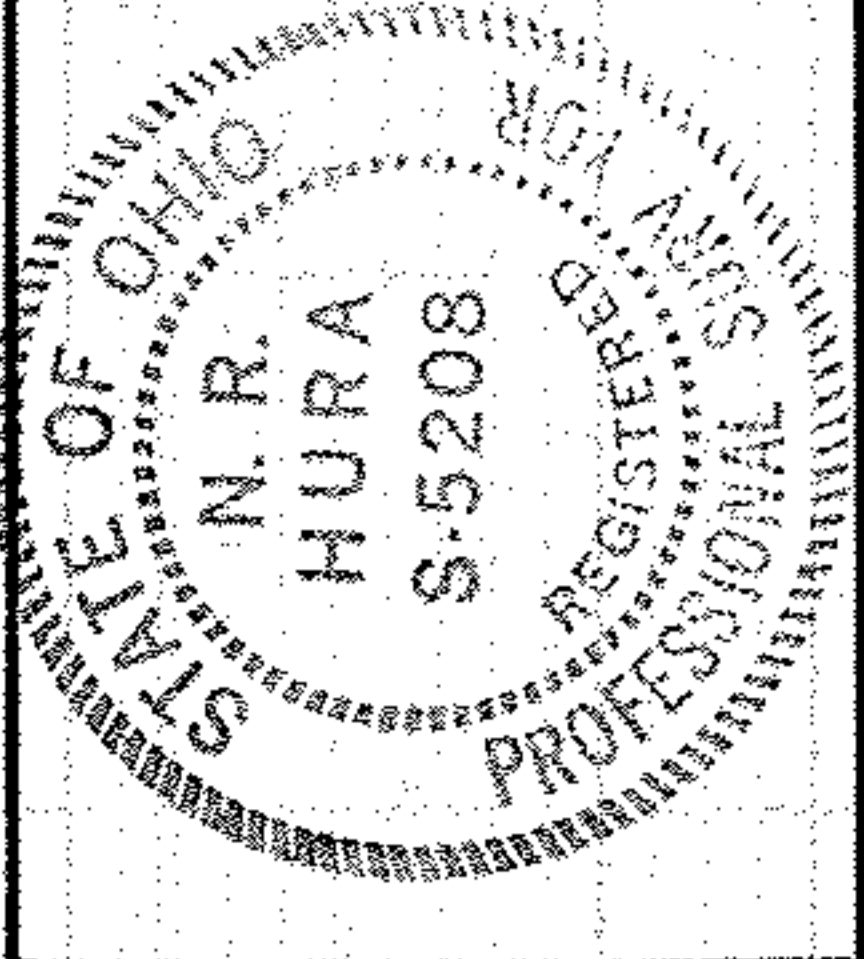

NORM HURA & ASSOC.
 SURVEYOR

MC PHAIL PROPERTY

PART OF ORIGINAL LOT NO. 113 OF
 SHEFFIELD TOWNSHIP LORAIN CO.
 FEB. 1981
 SCALE 1" = 50'

PLAT OF SURVEY