05-00-023-116 -
05-00-023-A Scan # 47805

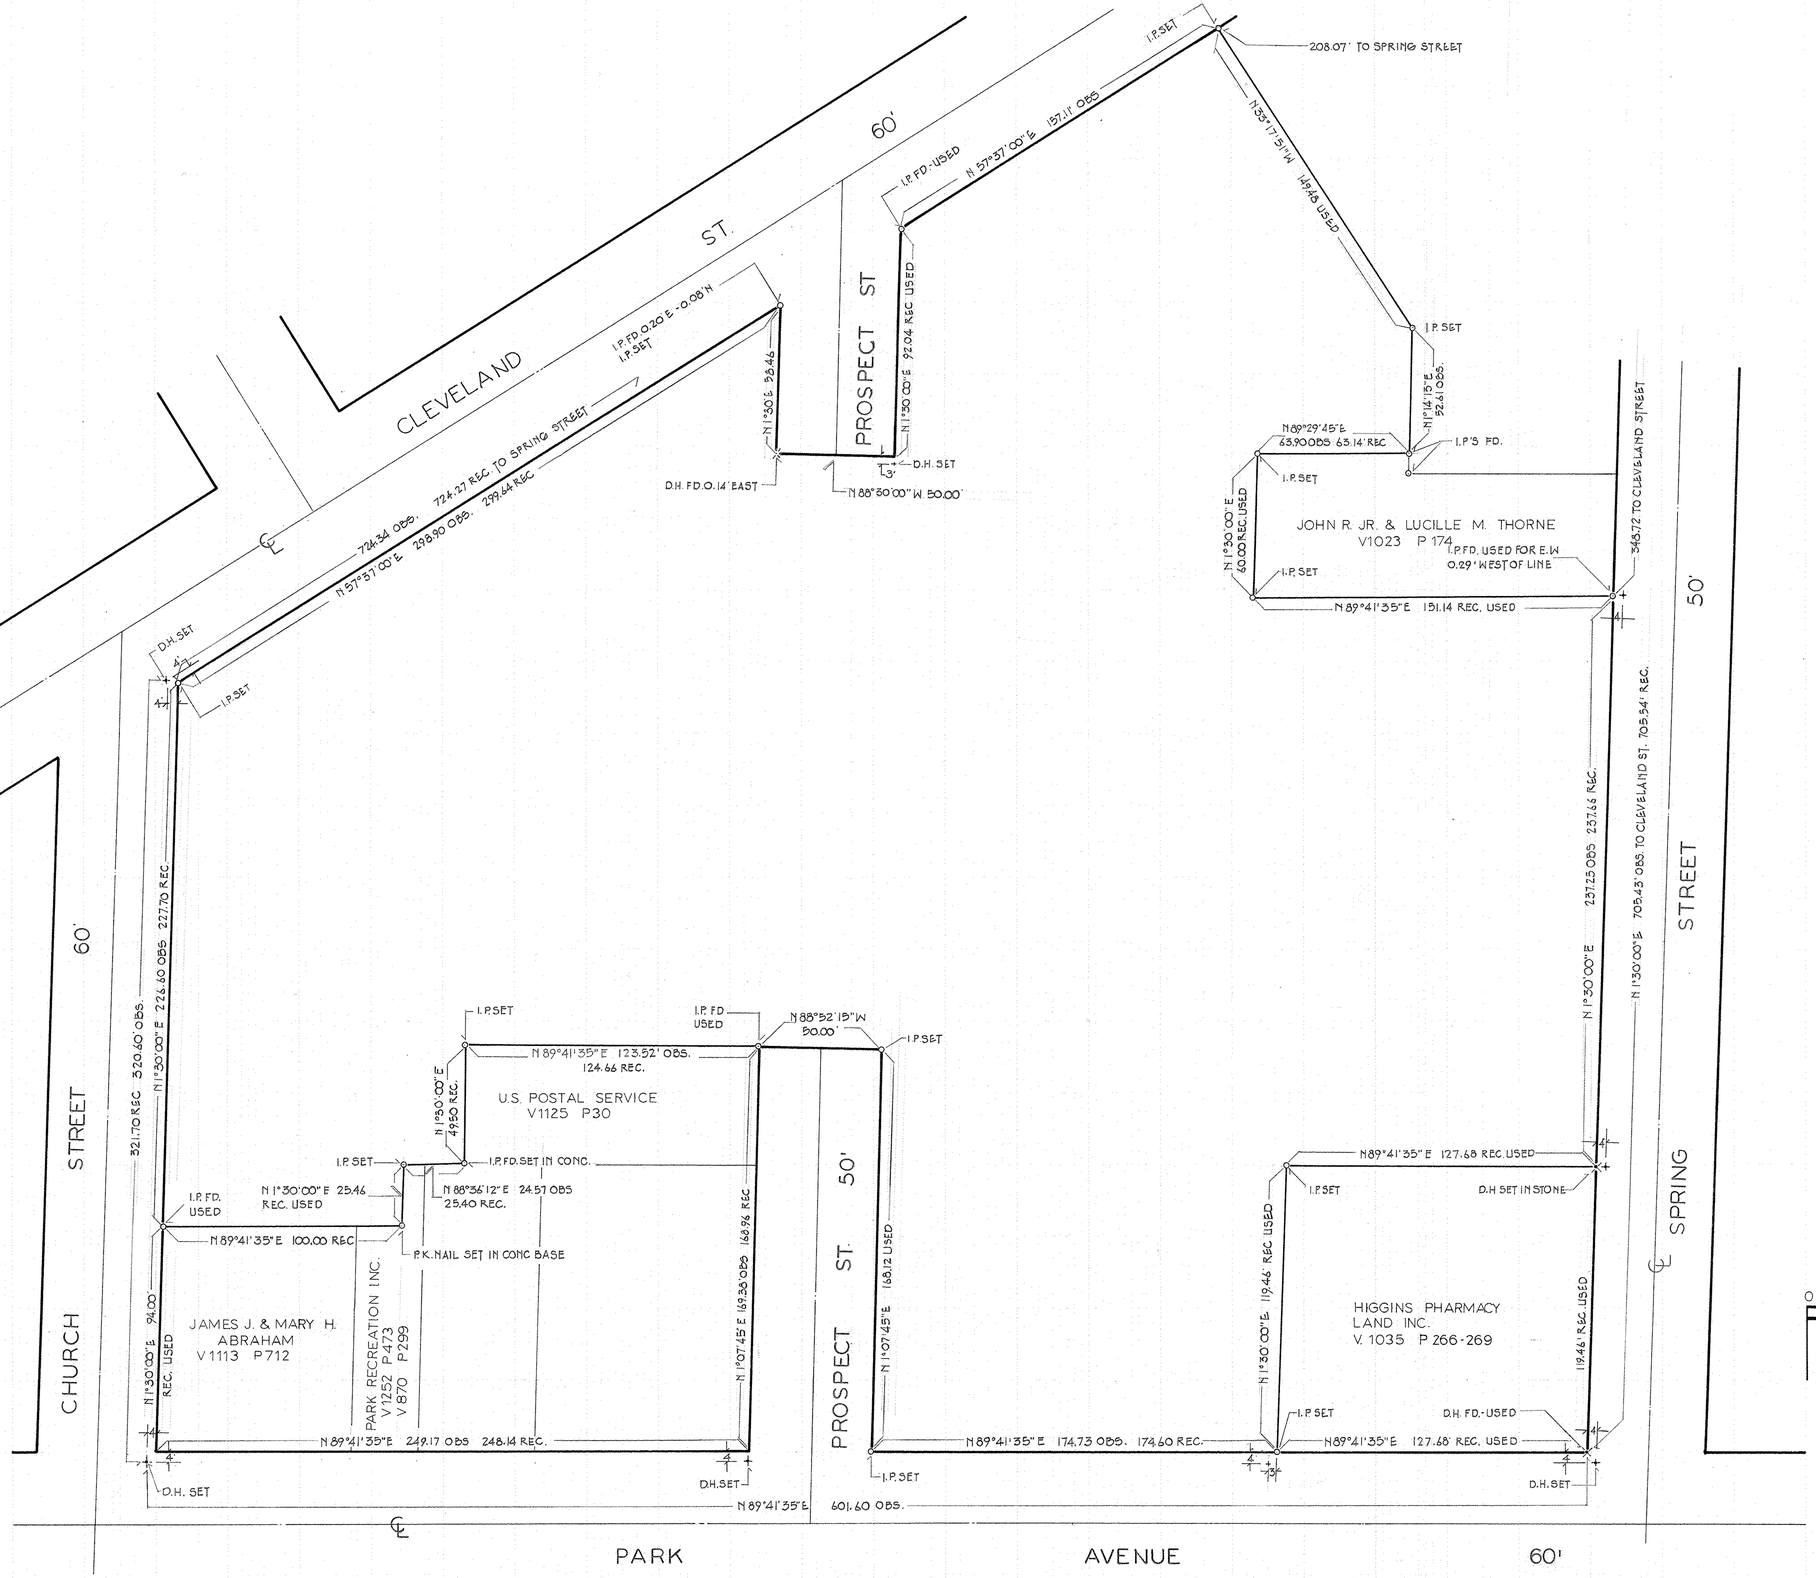

STATE OF OHIO
N.R. HURA
S-5208
REGISTERED
PROFESSIONAL SURVEYOR

JUNE 1984
SCALE 1" =30'

OUTLINE SURVEY

AMHERST HOSPITAL

3025