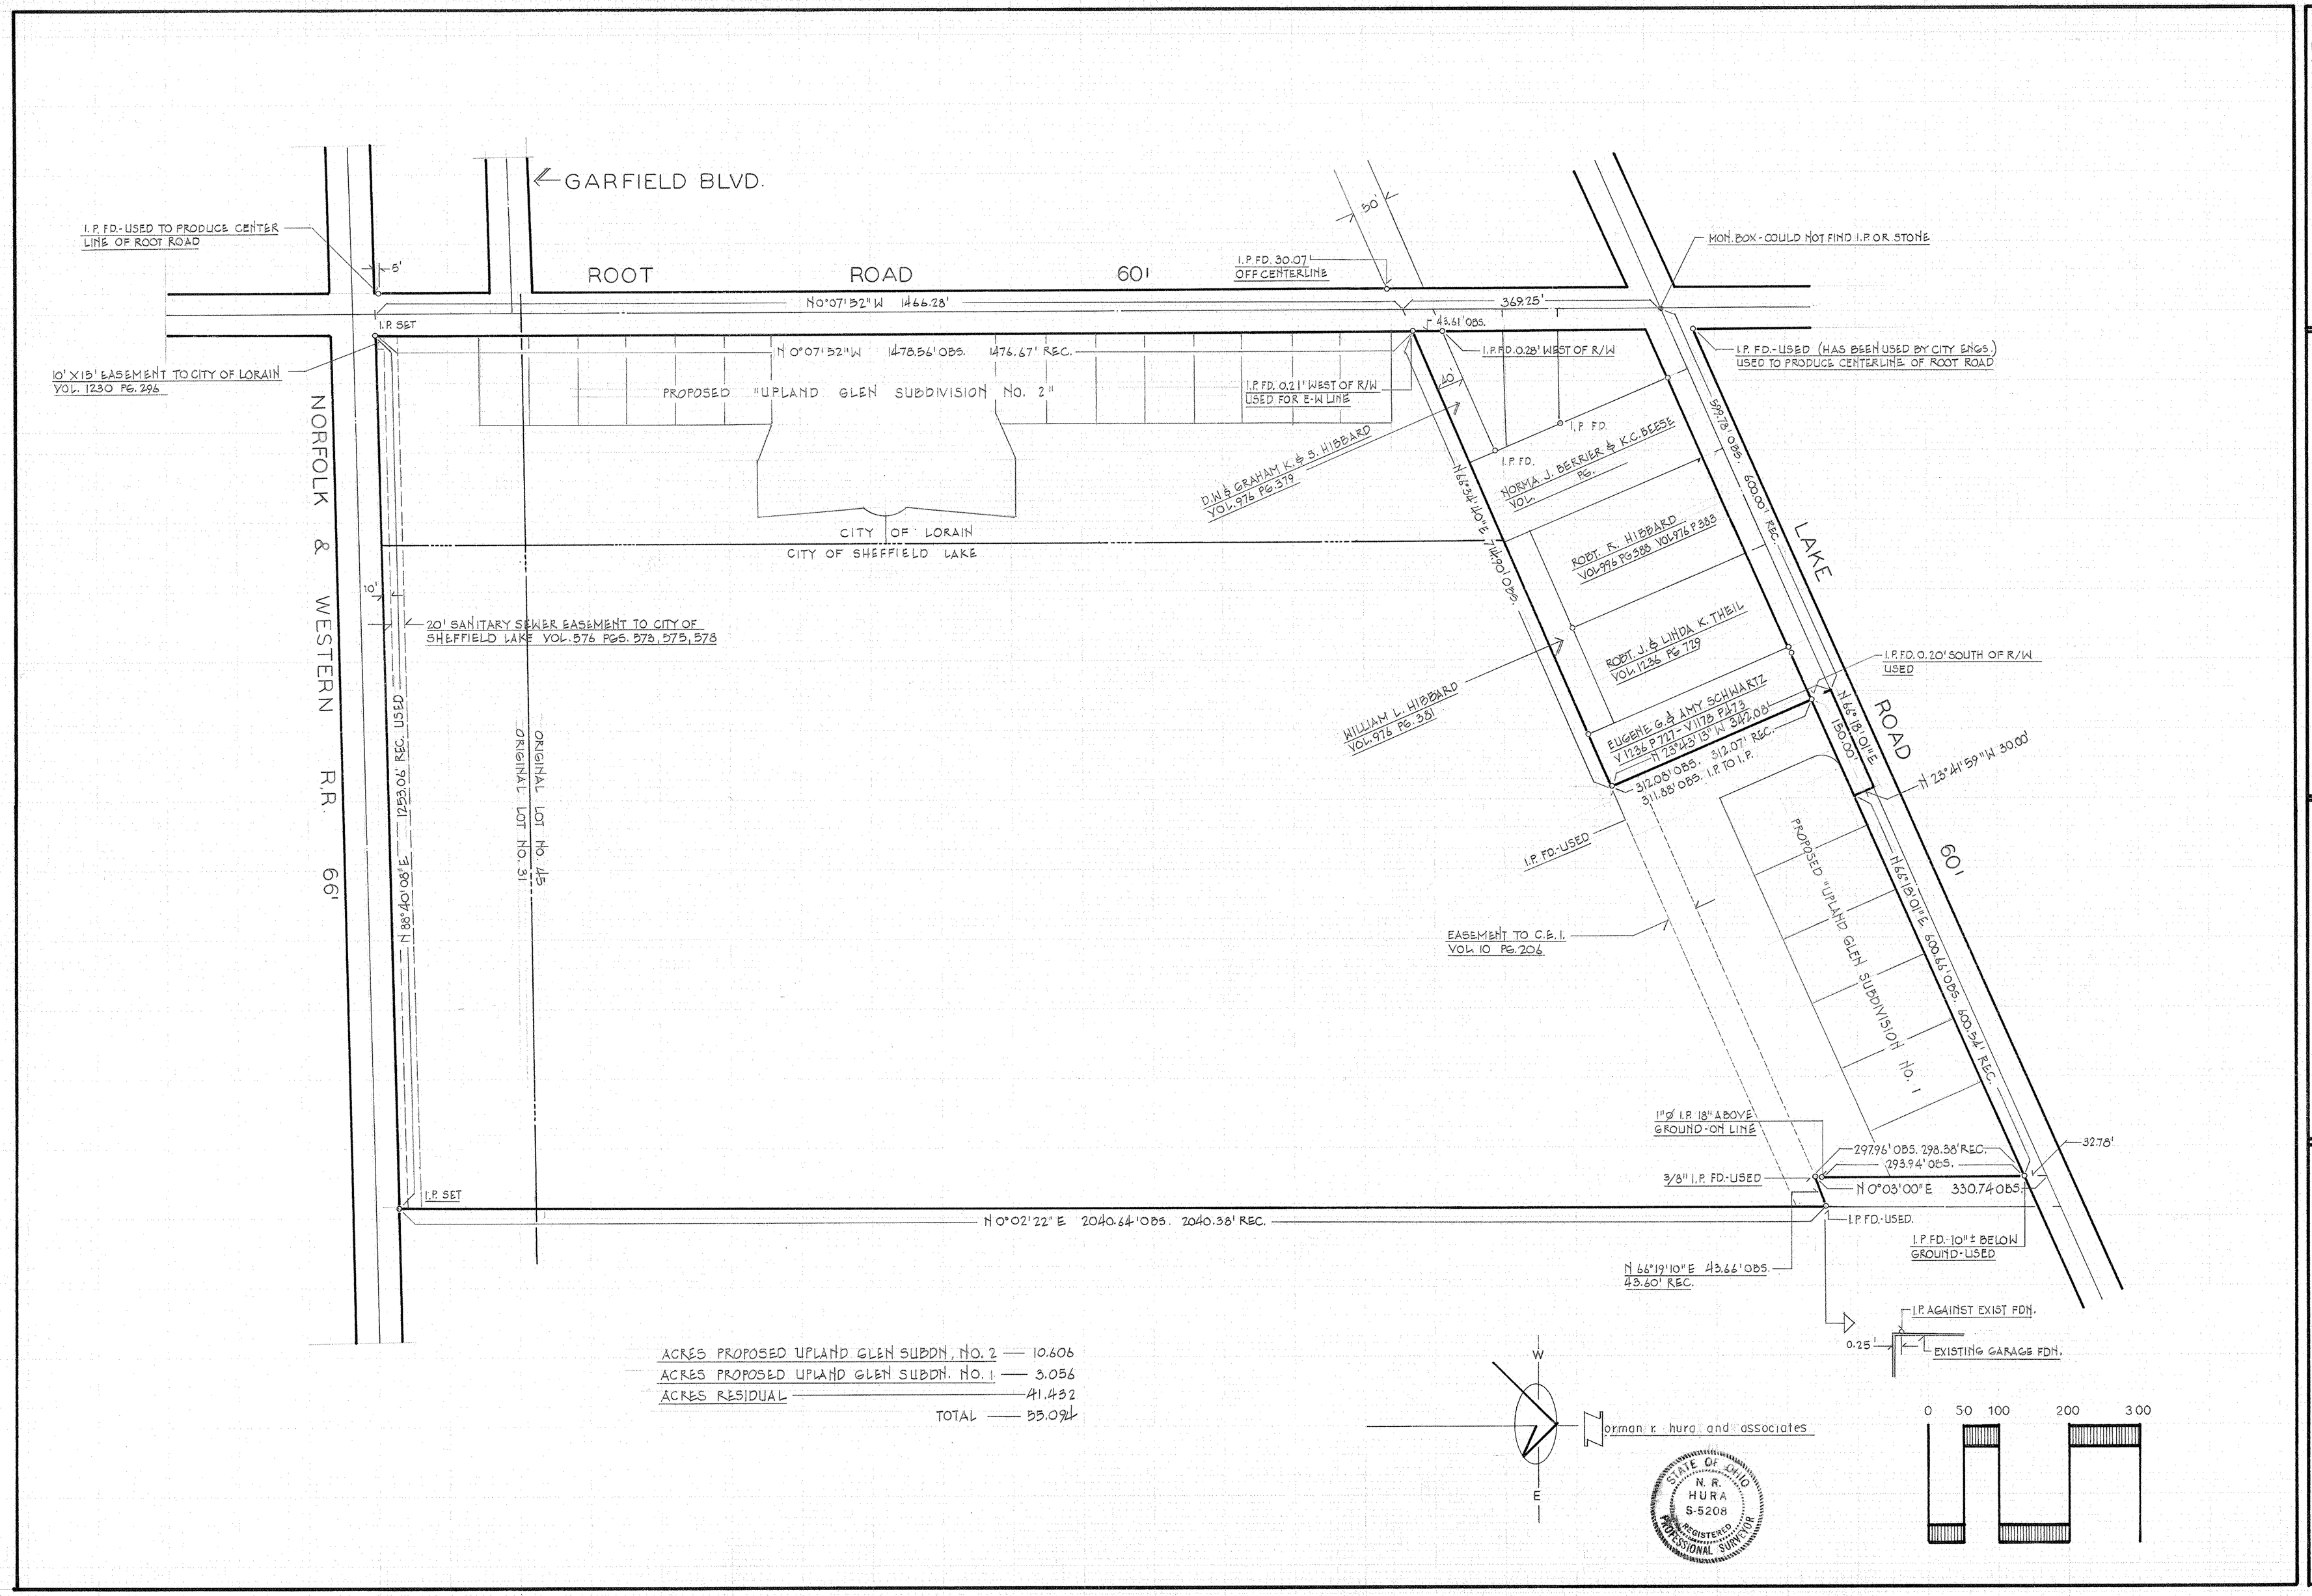


ACRES PROPOSED UPLAND GLEN SUBDN. NO. 2 — 10.606
ACRES PROPOSED UPLAND GLEN SUBDN. NO. 1 — 3.056
ACRES RESIDUAL — 41.432
TOTAL — 55.094

norman r. hura and associates

SEPTEMBER 1987

PART OF O.L. NO'S 31 AND 45
SHEFFIELD TOWNSHIP
LORAIN COUNTY-OHIO

OUTLINE SURVEY

SUNRISE LAND COMPANY

03-00-045 102
03-00-045 Scan# 476671

3062F