04-00-030-141 -
04-00-030-E Scan# 47809

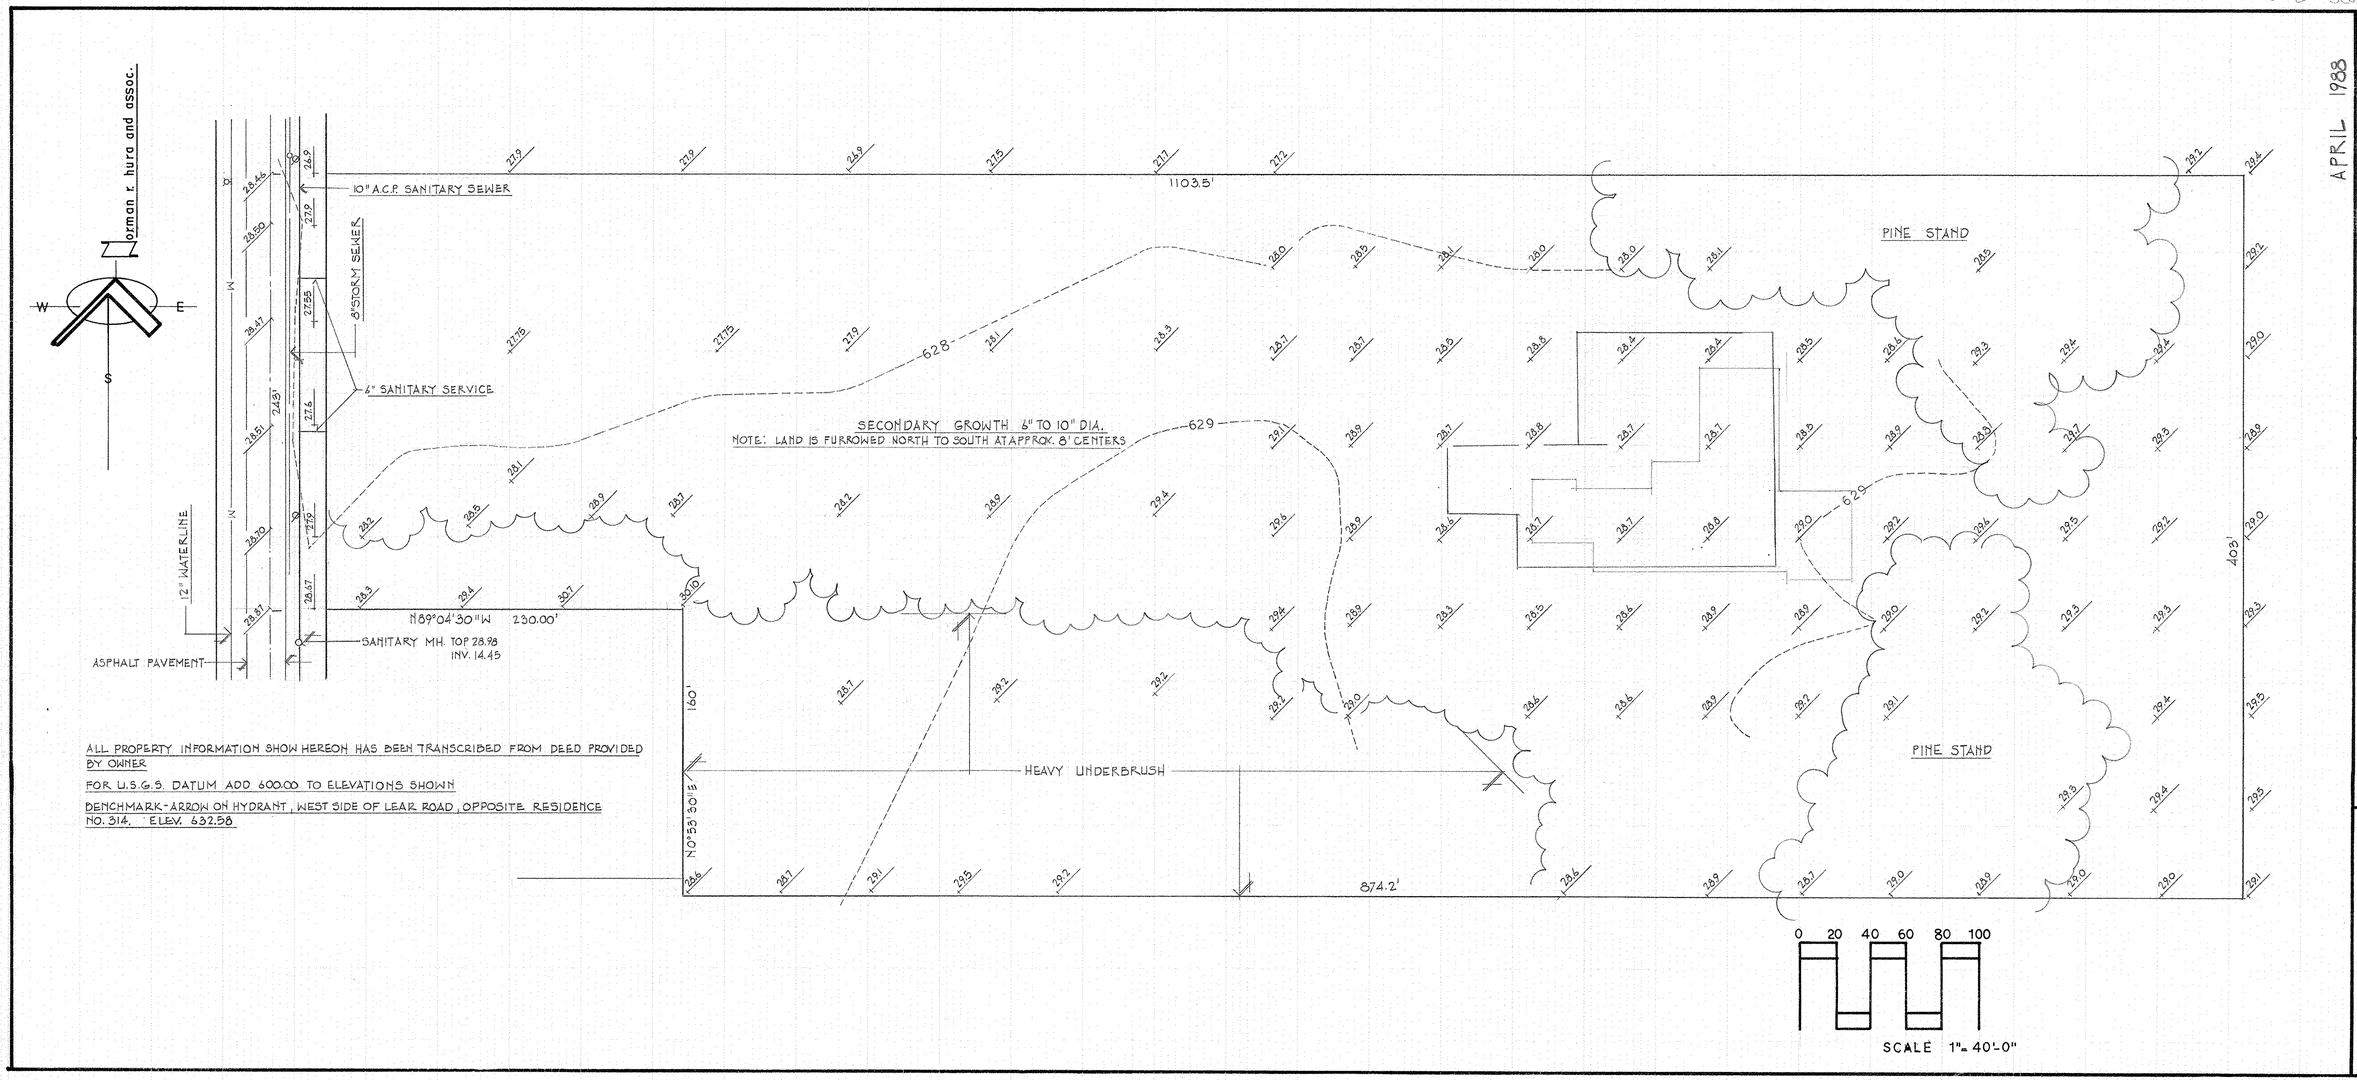

ALL PROPERTY INFORMATION SHOW HEREON HAS BEEN TRANSCRIBED FROM DEED PROVIDED BY OWNER

FOR U.S.G.S. DATUM ADD 600.00 TO ELEVATIONS SHOWN

BENCHMARK-ARROW ON HYDRANT, WEST SIDE OF LEAR ROAD, OPPOSITE RESIDENCE NO. 314. ELEV. 632.58

APRIL 1988

P.P.N. 04-00-030-141-052
AVON LAKE, OHIO

TOPOGRAPHICAL SURVEY

LEE S. KOLCZUN

3079