


Norman r. hura & associates
SCALE 1"=40'-0"


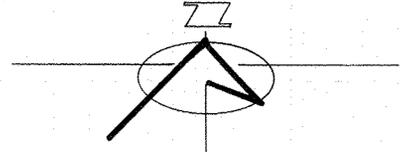


NORTH LINE EAST 30TH ST

I.P. FD.-USED

OAKWOOD AVENUE

EAST 28TH STREET

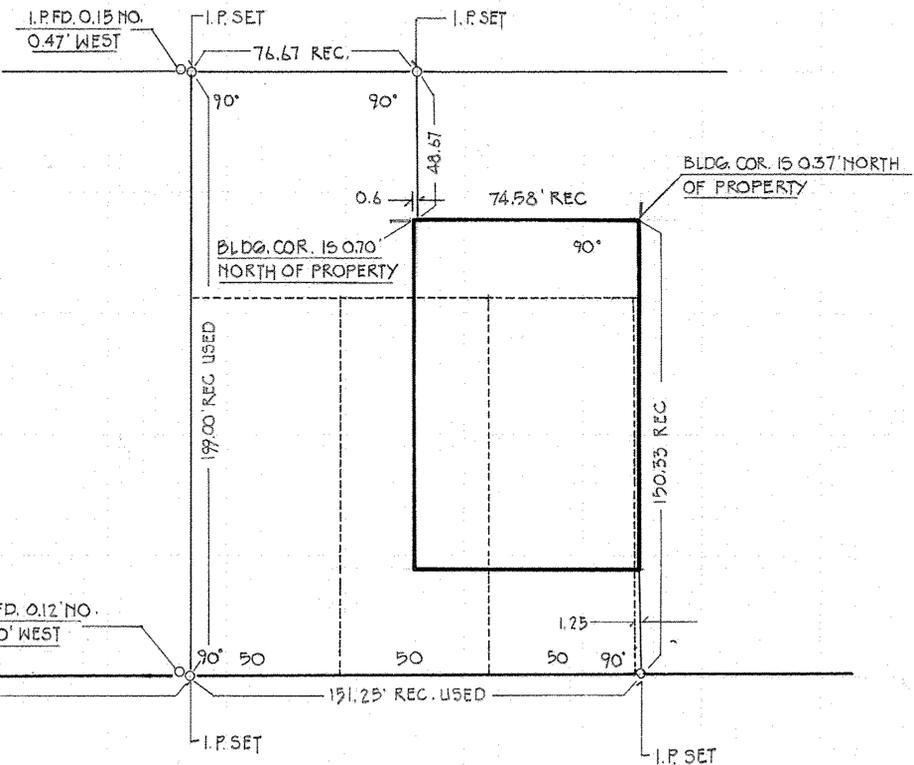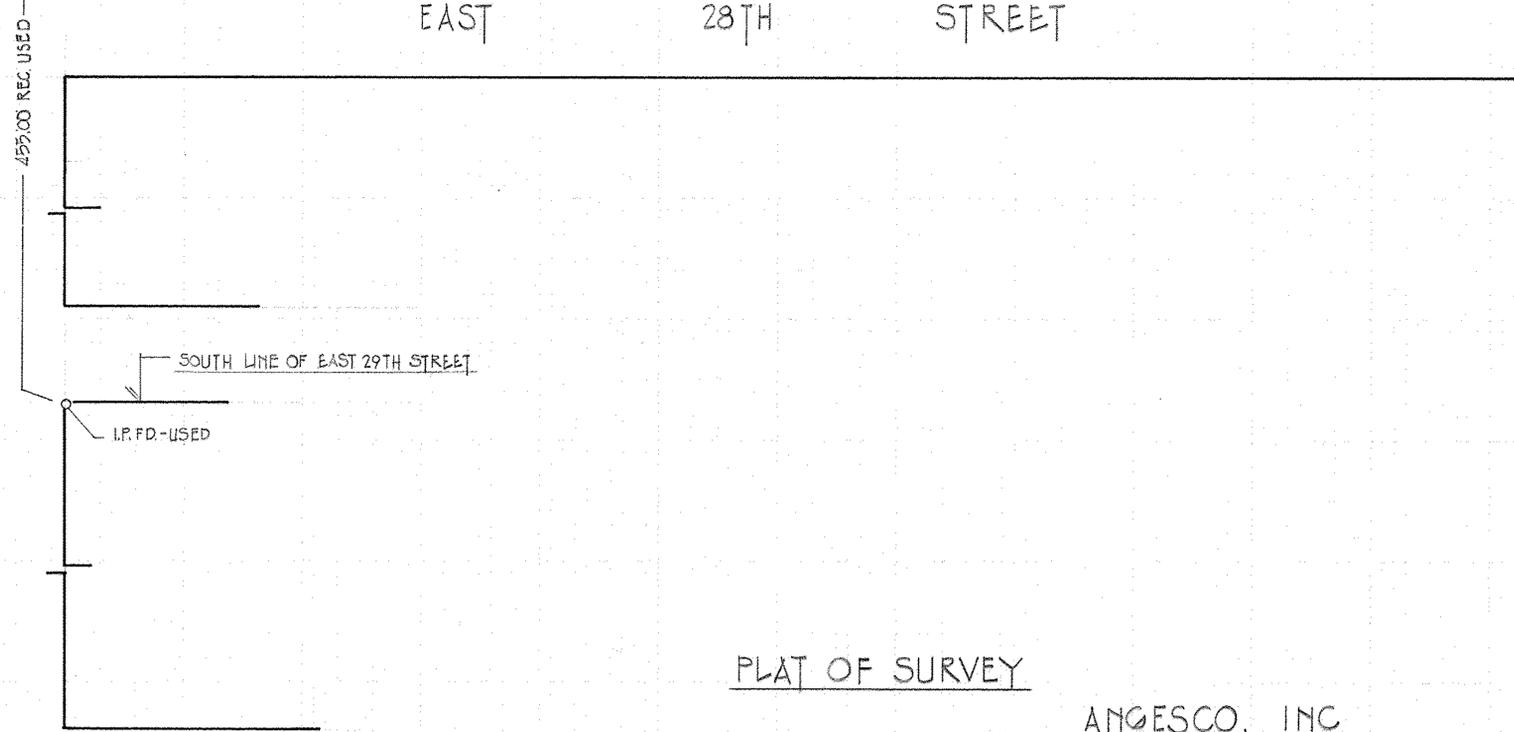

PLAT OF SURVEY

ANGESCO, INC

MAY 1986