02-01-004-102-014
02-01-004-107-008, 009, 010, 011
02-01-004-0 Scan #47820

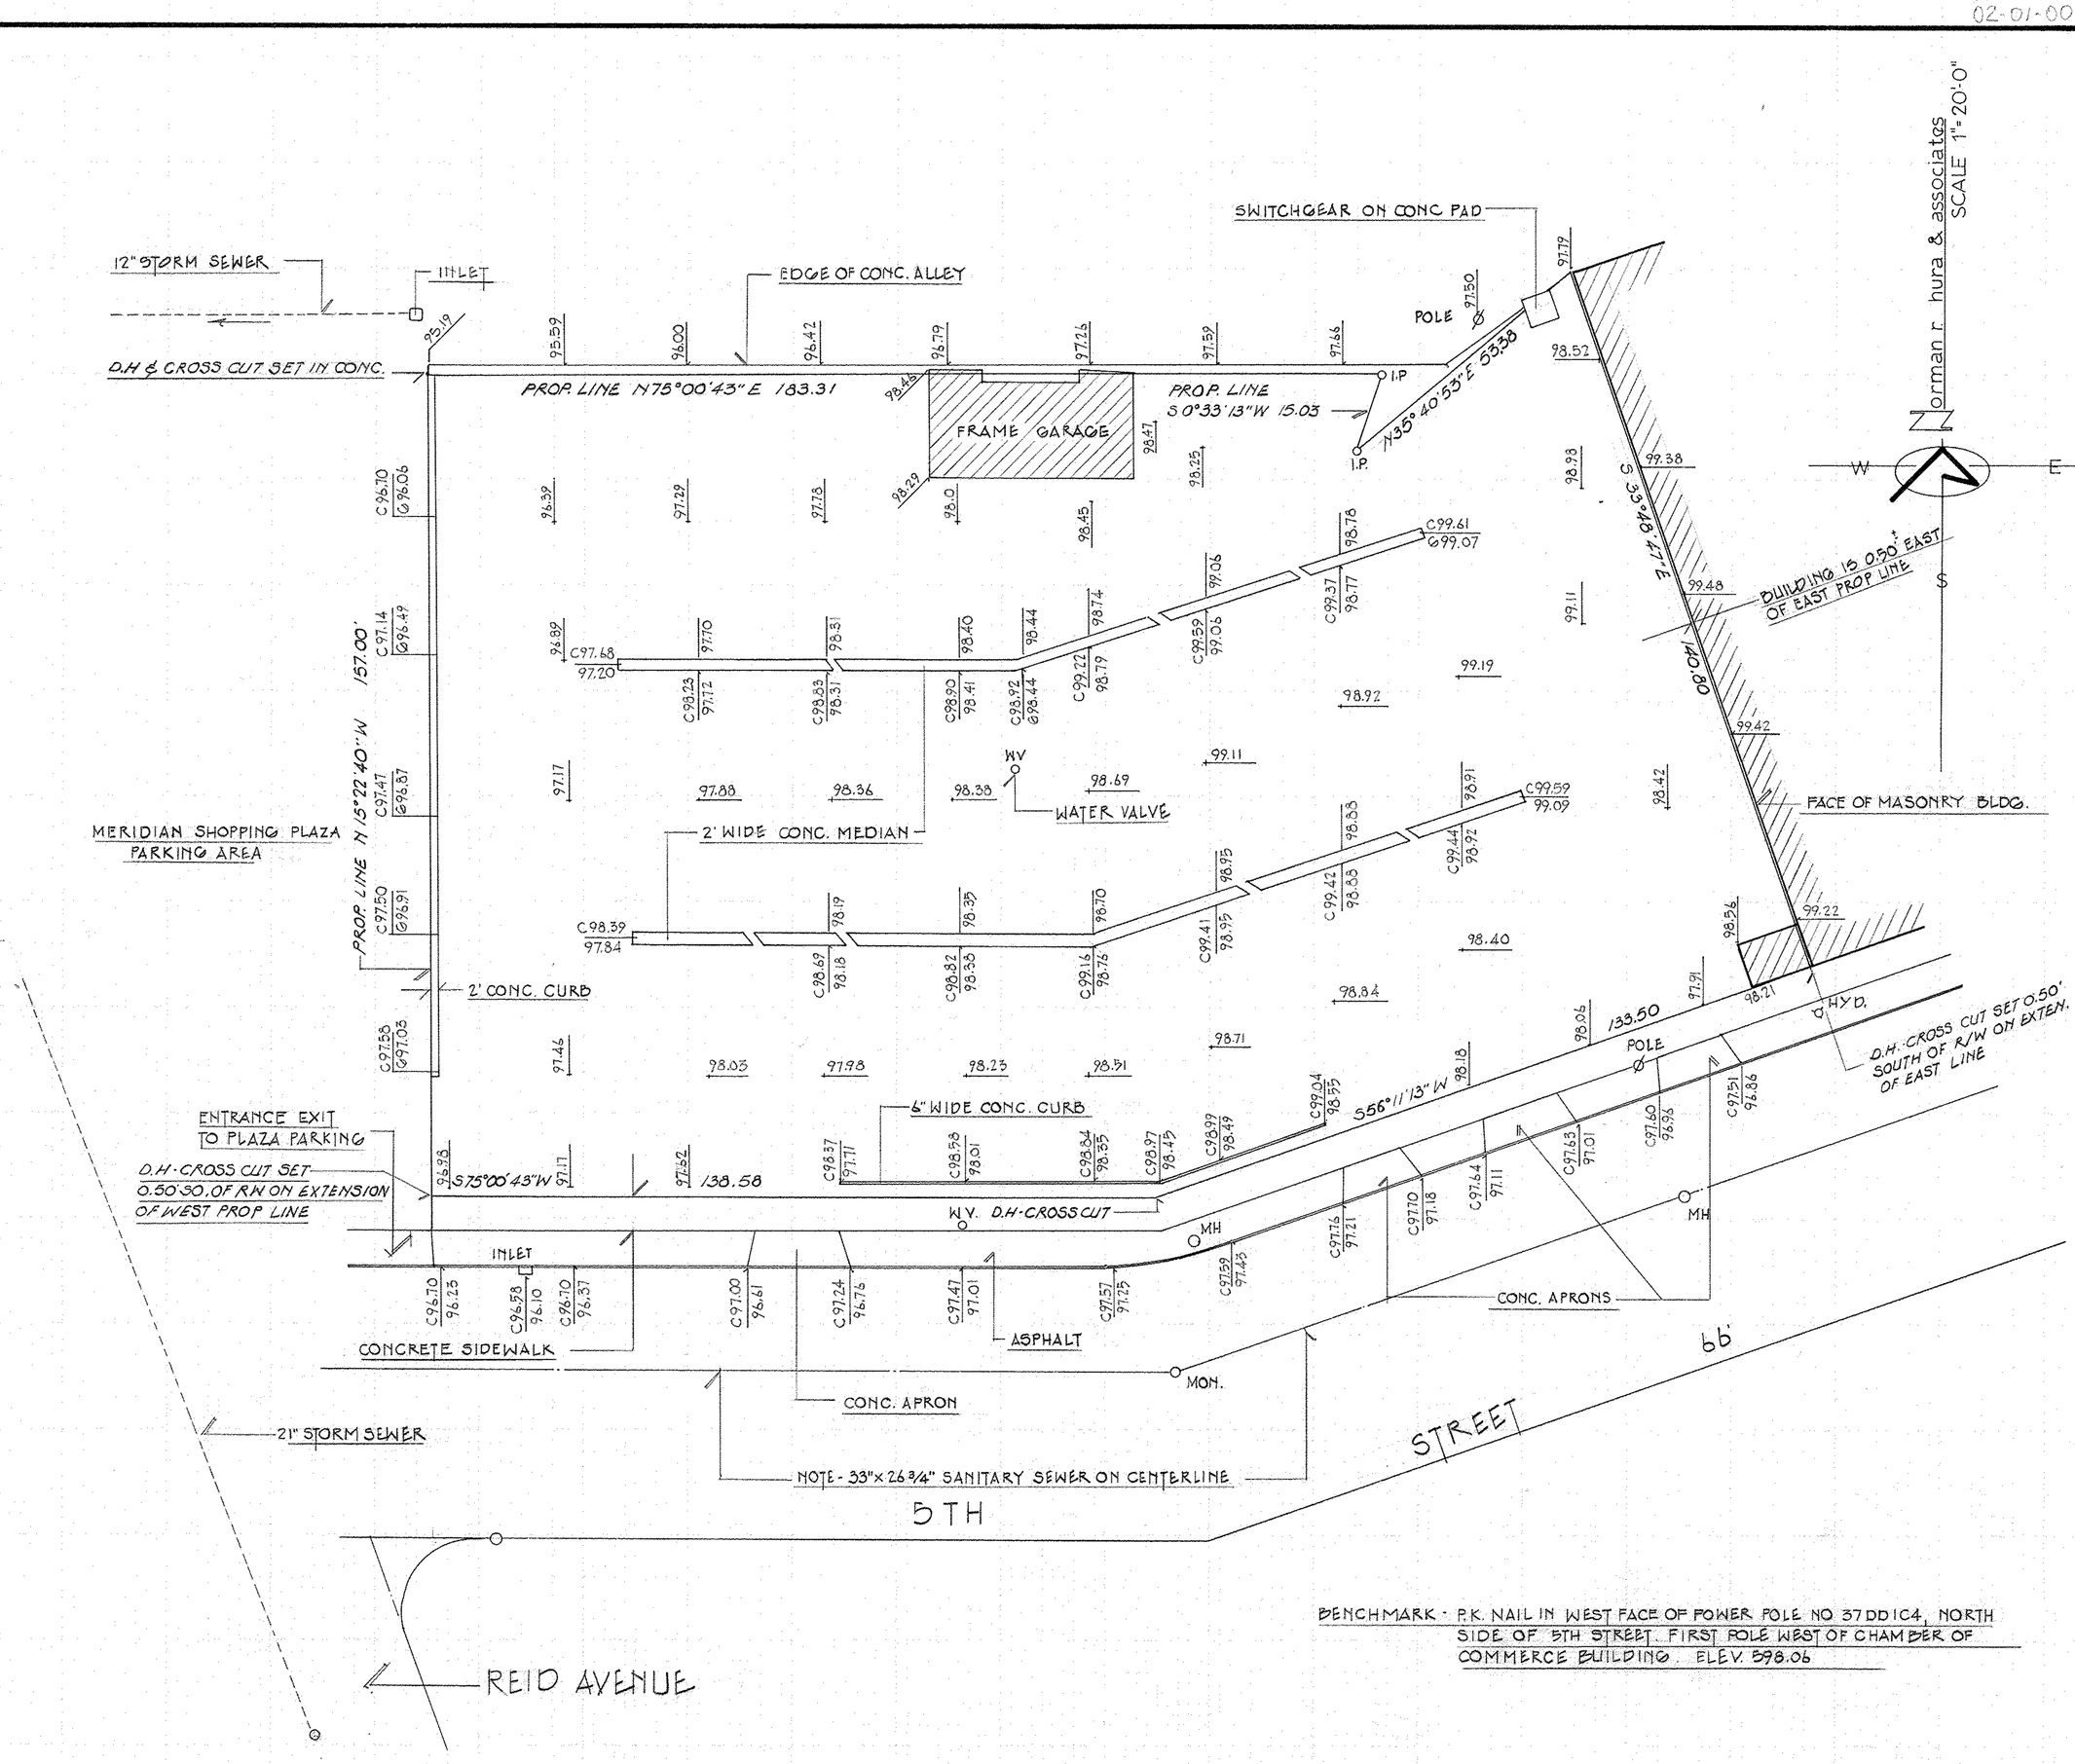

BENCHMARK : P.K. NAIL IN WEST FACE OF POWER POLE NO 37DD1C4, NORTH SIDE OF 5TH STREET. FIRST POLE WEST OF CHAMBER OF COMMERCE BUILDING. ELEV. 598.06

STATE OF OHIO
N. R. HURA
S-5208
REGISTERED PROFESSIONAL SURVEYOR

MAY 1986

FB 42 P25 THRU 32

OUTLINE & TOPOGRAPHICAL SURVEY
P.P.NO.S 2-01-004-102-014
2-01-004-107-008 THRU 011

LORAIN NATIONAL BANK

3018