05-00-023-117-008, 009, 010
011, 019, 020

05-00-023-B
Scan # 47821

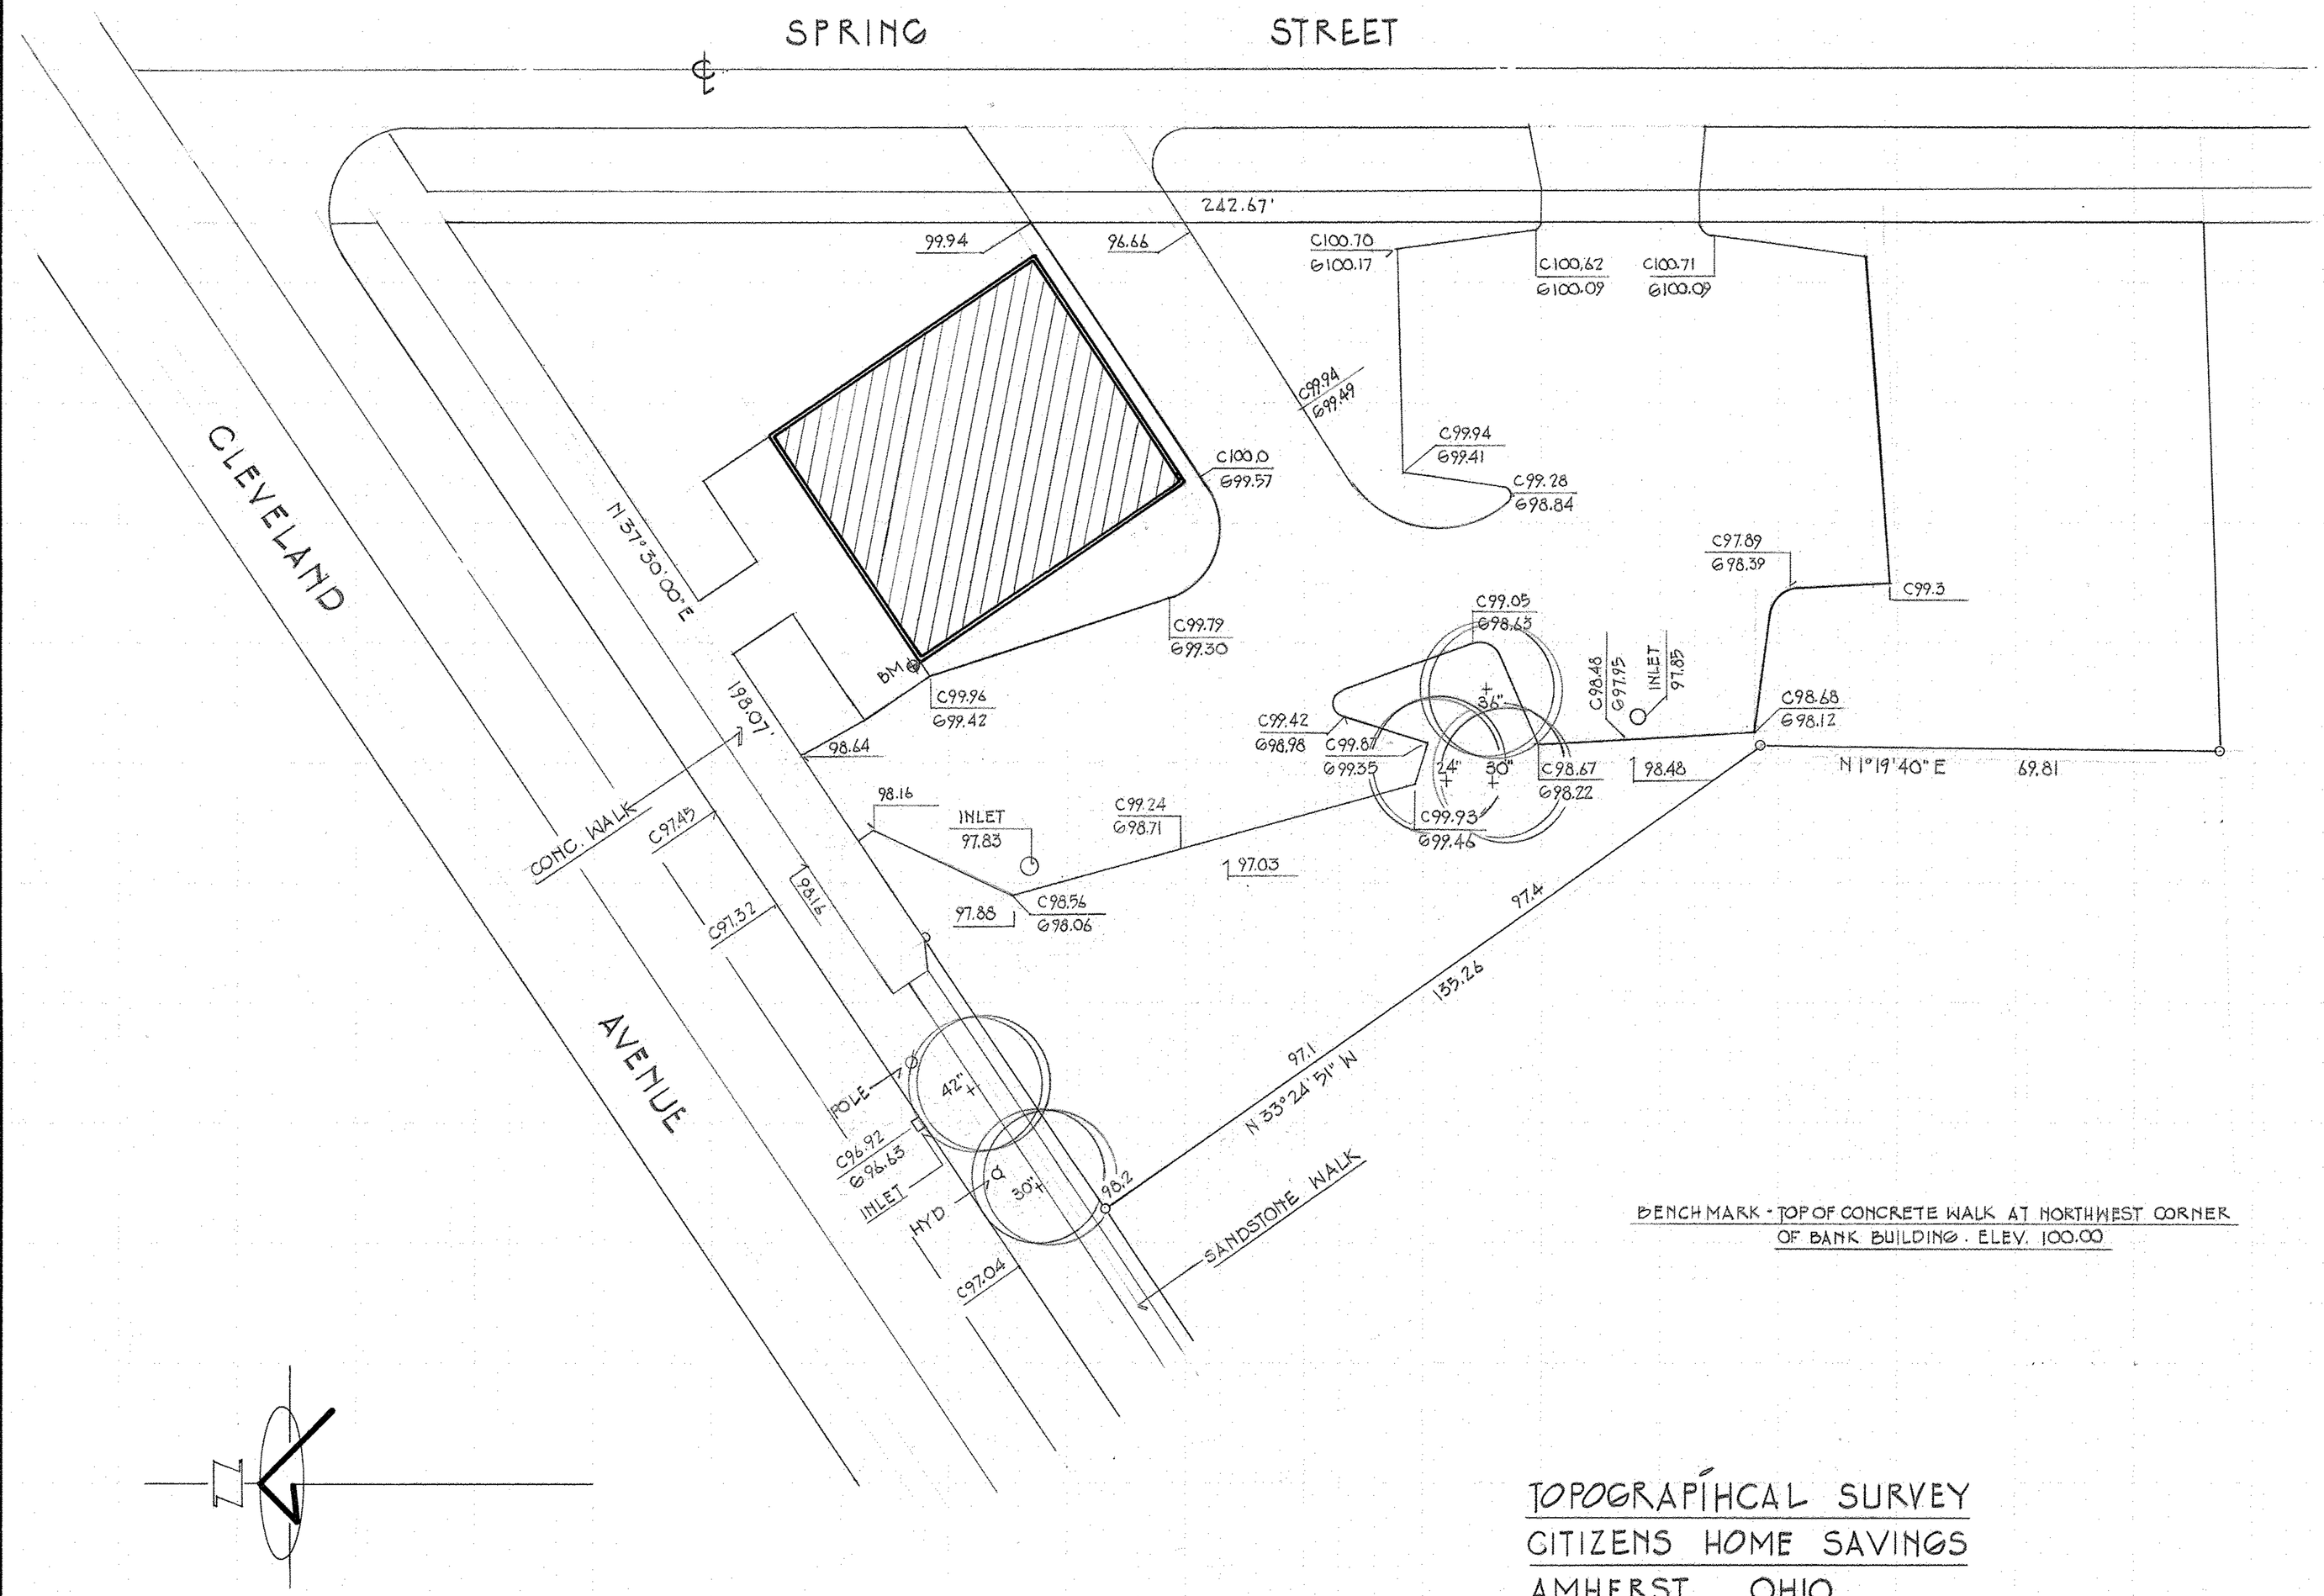

BENCH MARK - TOP OF CONCRETE WALK AT NORTHWEST CORNER OF BANK BUILDING. ELEV. 100.00

TOPOGRAPHICAL SURVEY
CITIZENS HOME SAVINGS
AMHERST, OHIO
MAY 1986 SCALE 1"=20'

3017