


06-25-007-000-47854
6-12-90 SCAN # 47854

CENTERLINE CURVE DATA	
RECORD	OBSERVED

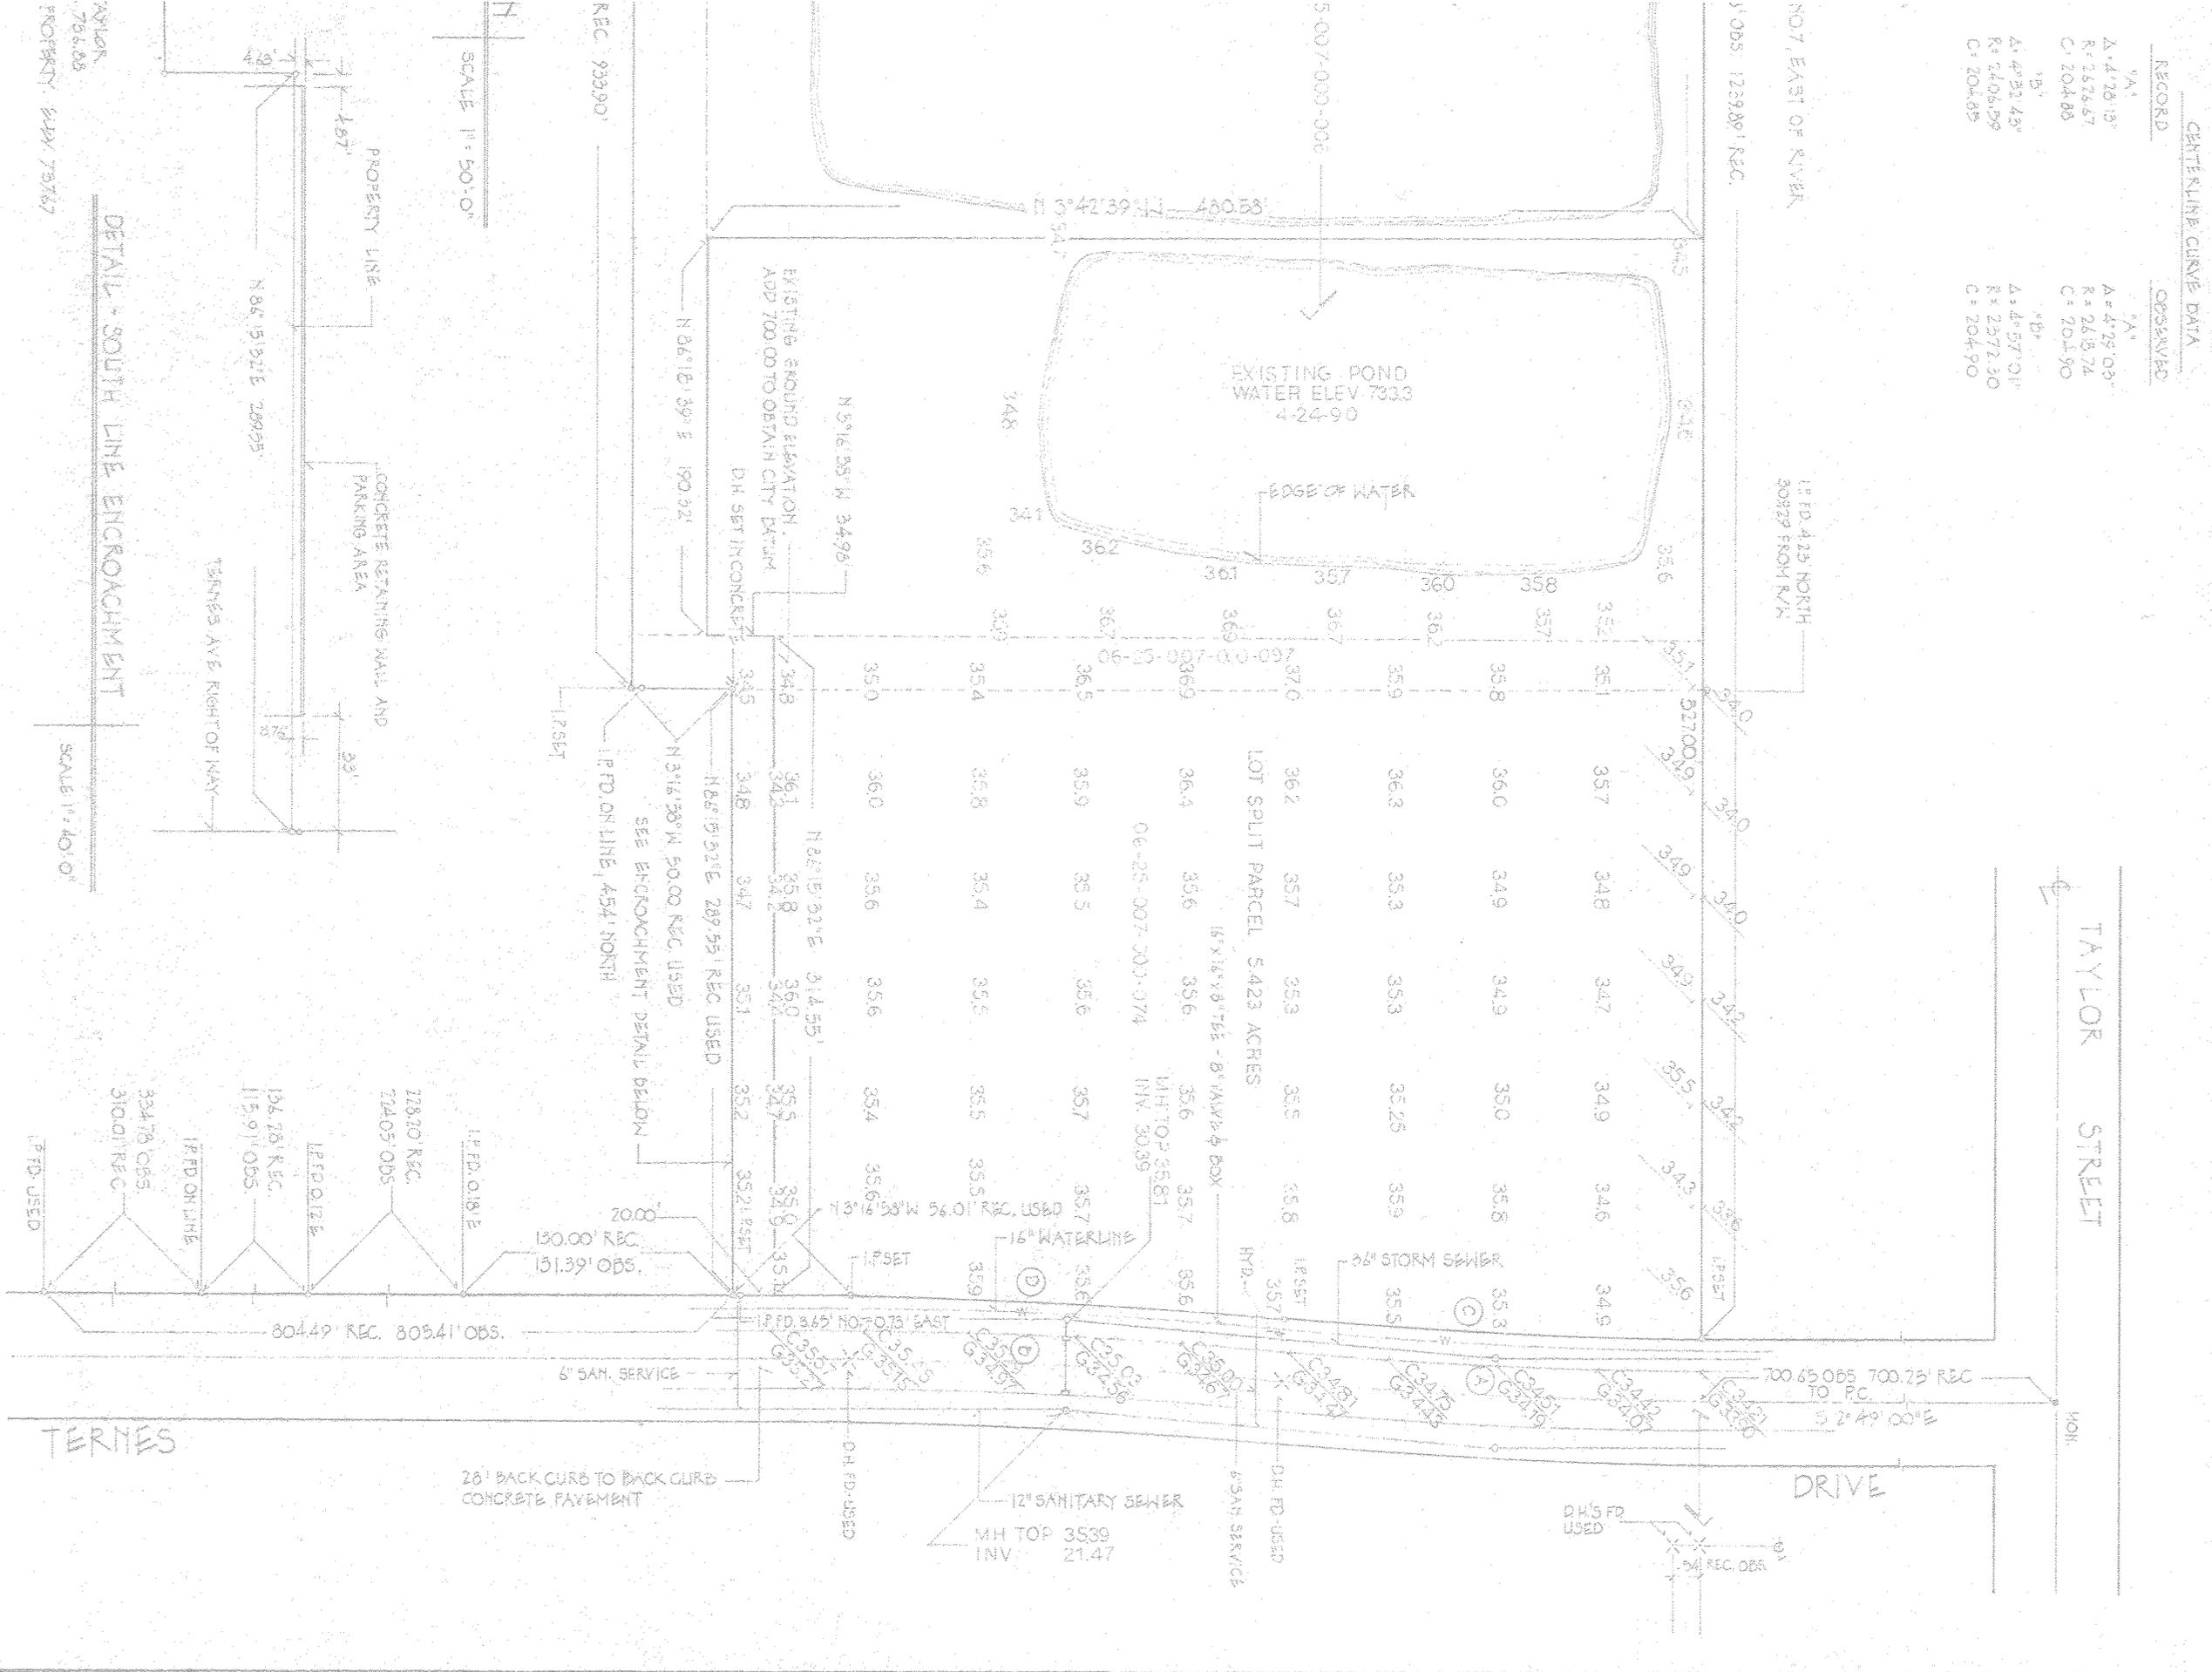

APRIL 1990



FB 83 PG 30-36

REVISED 6-8-90 -ADDED LOT SPLIT

OUTLINE TOPOGRAPHICAL SURVEY - LOT SPLIT

PPNO.'S 06-25-007-000-006, 06-25-007-000-074
 06-25-007-000-095, 06-25-007-000-097

CASCADE PATTERN
 TERNES AVENUE
 ELYRIA, OHIO

4037A