Scan # 47902 18-00-024000-151,078.074

MAP OF PART OF SECTION NO. 24

CARLISLE TWP. — LORAIN COUNTY — OHIO

SCALE: 1" = 40' OCT. 22-1963 2:30 P.M.
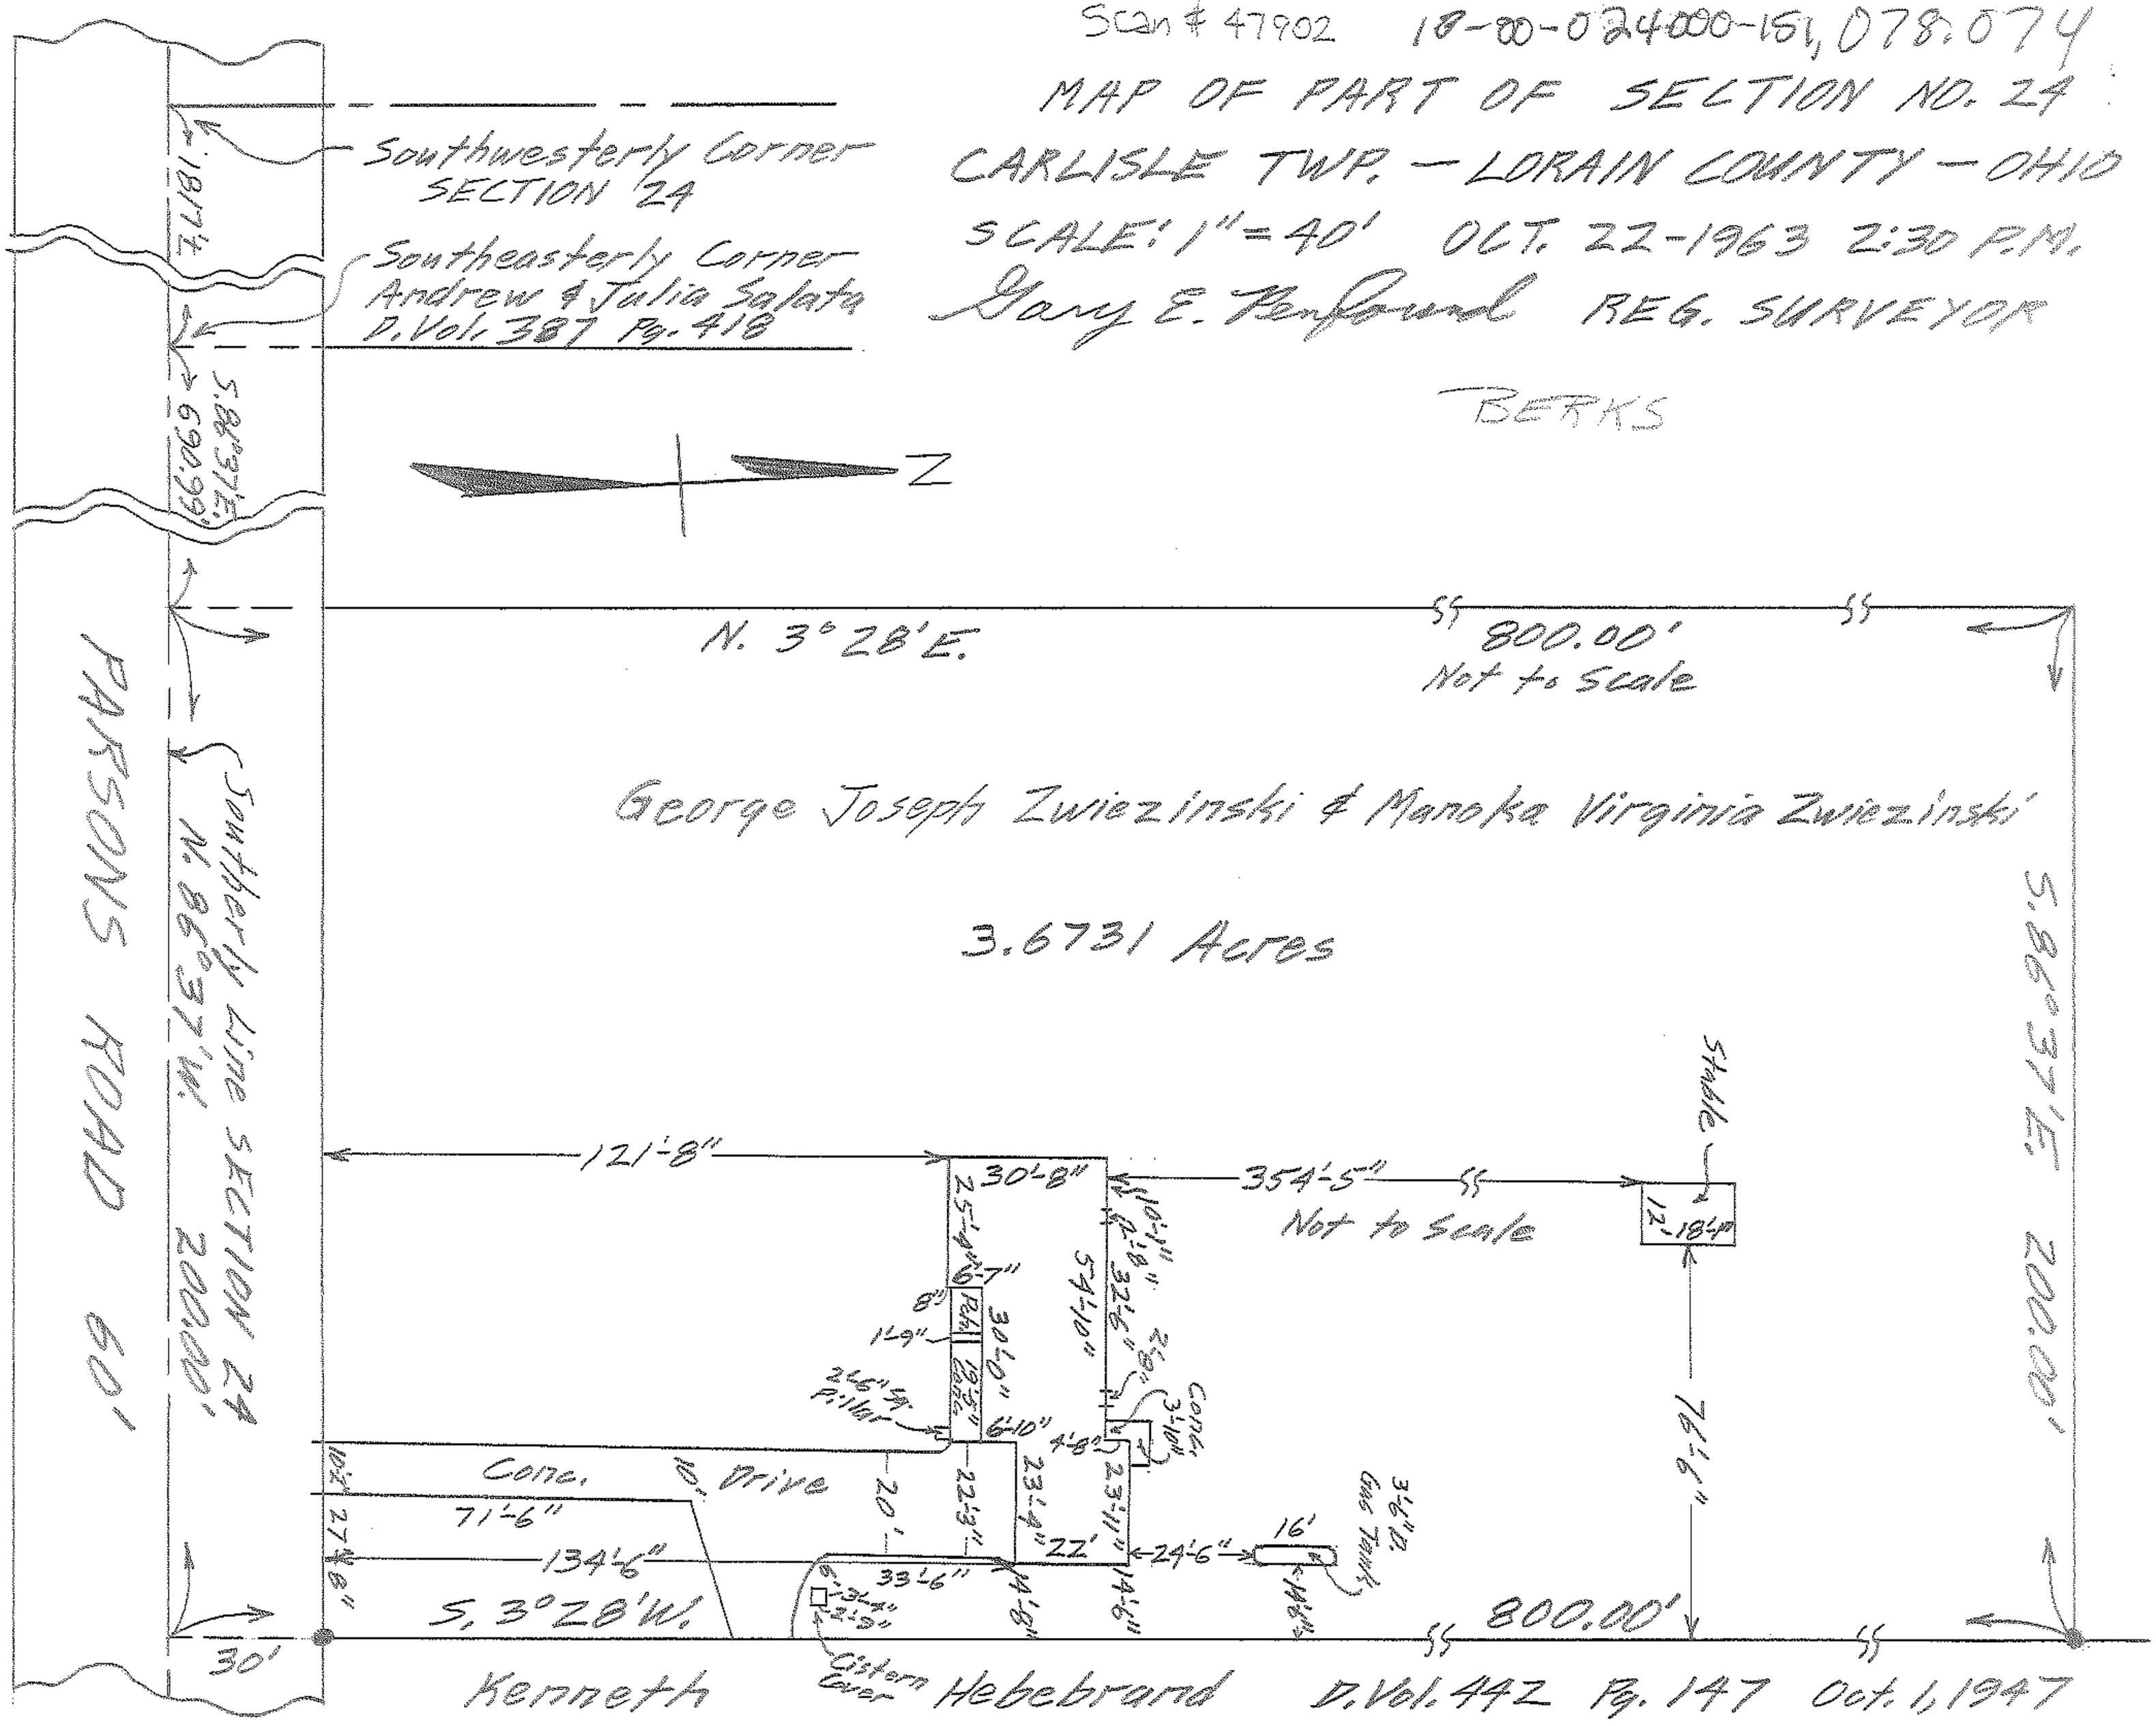
Gary E. Penfound REG. SURVEYOR