11-00-028-000-016 11-00-028-A Scan # 47926

DETAIL SHEET OF SUB-LOT NO. 2
ISLAND ACRES VOL. 16 PG. 17
ORIGINAL LOT 28 EATON TOWNSHIP
LORAIN COUNTY OHIO
DETAIL SCALE: 1" = 30' JUNE 4-1970 3:30 P.M.
Gary E. Penfound REG. SURVEYOR NO. 4457
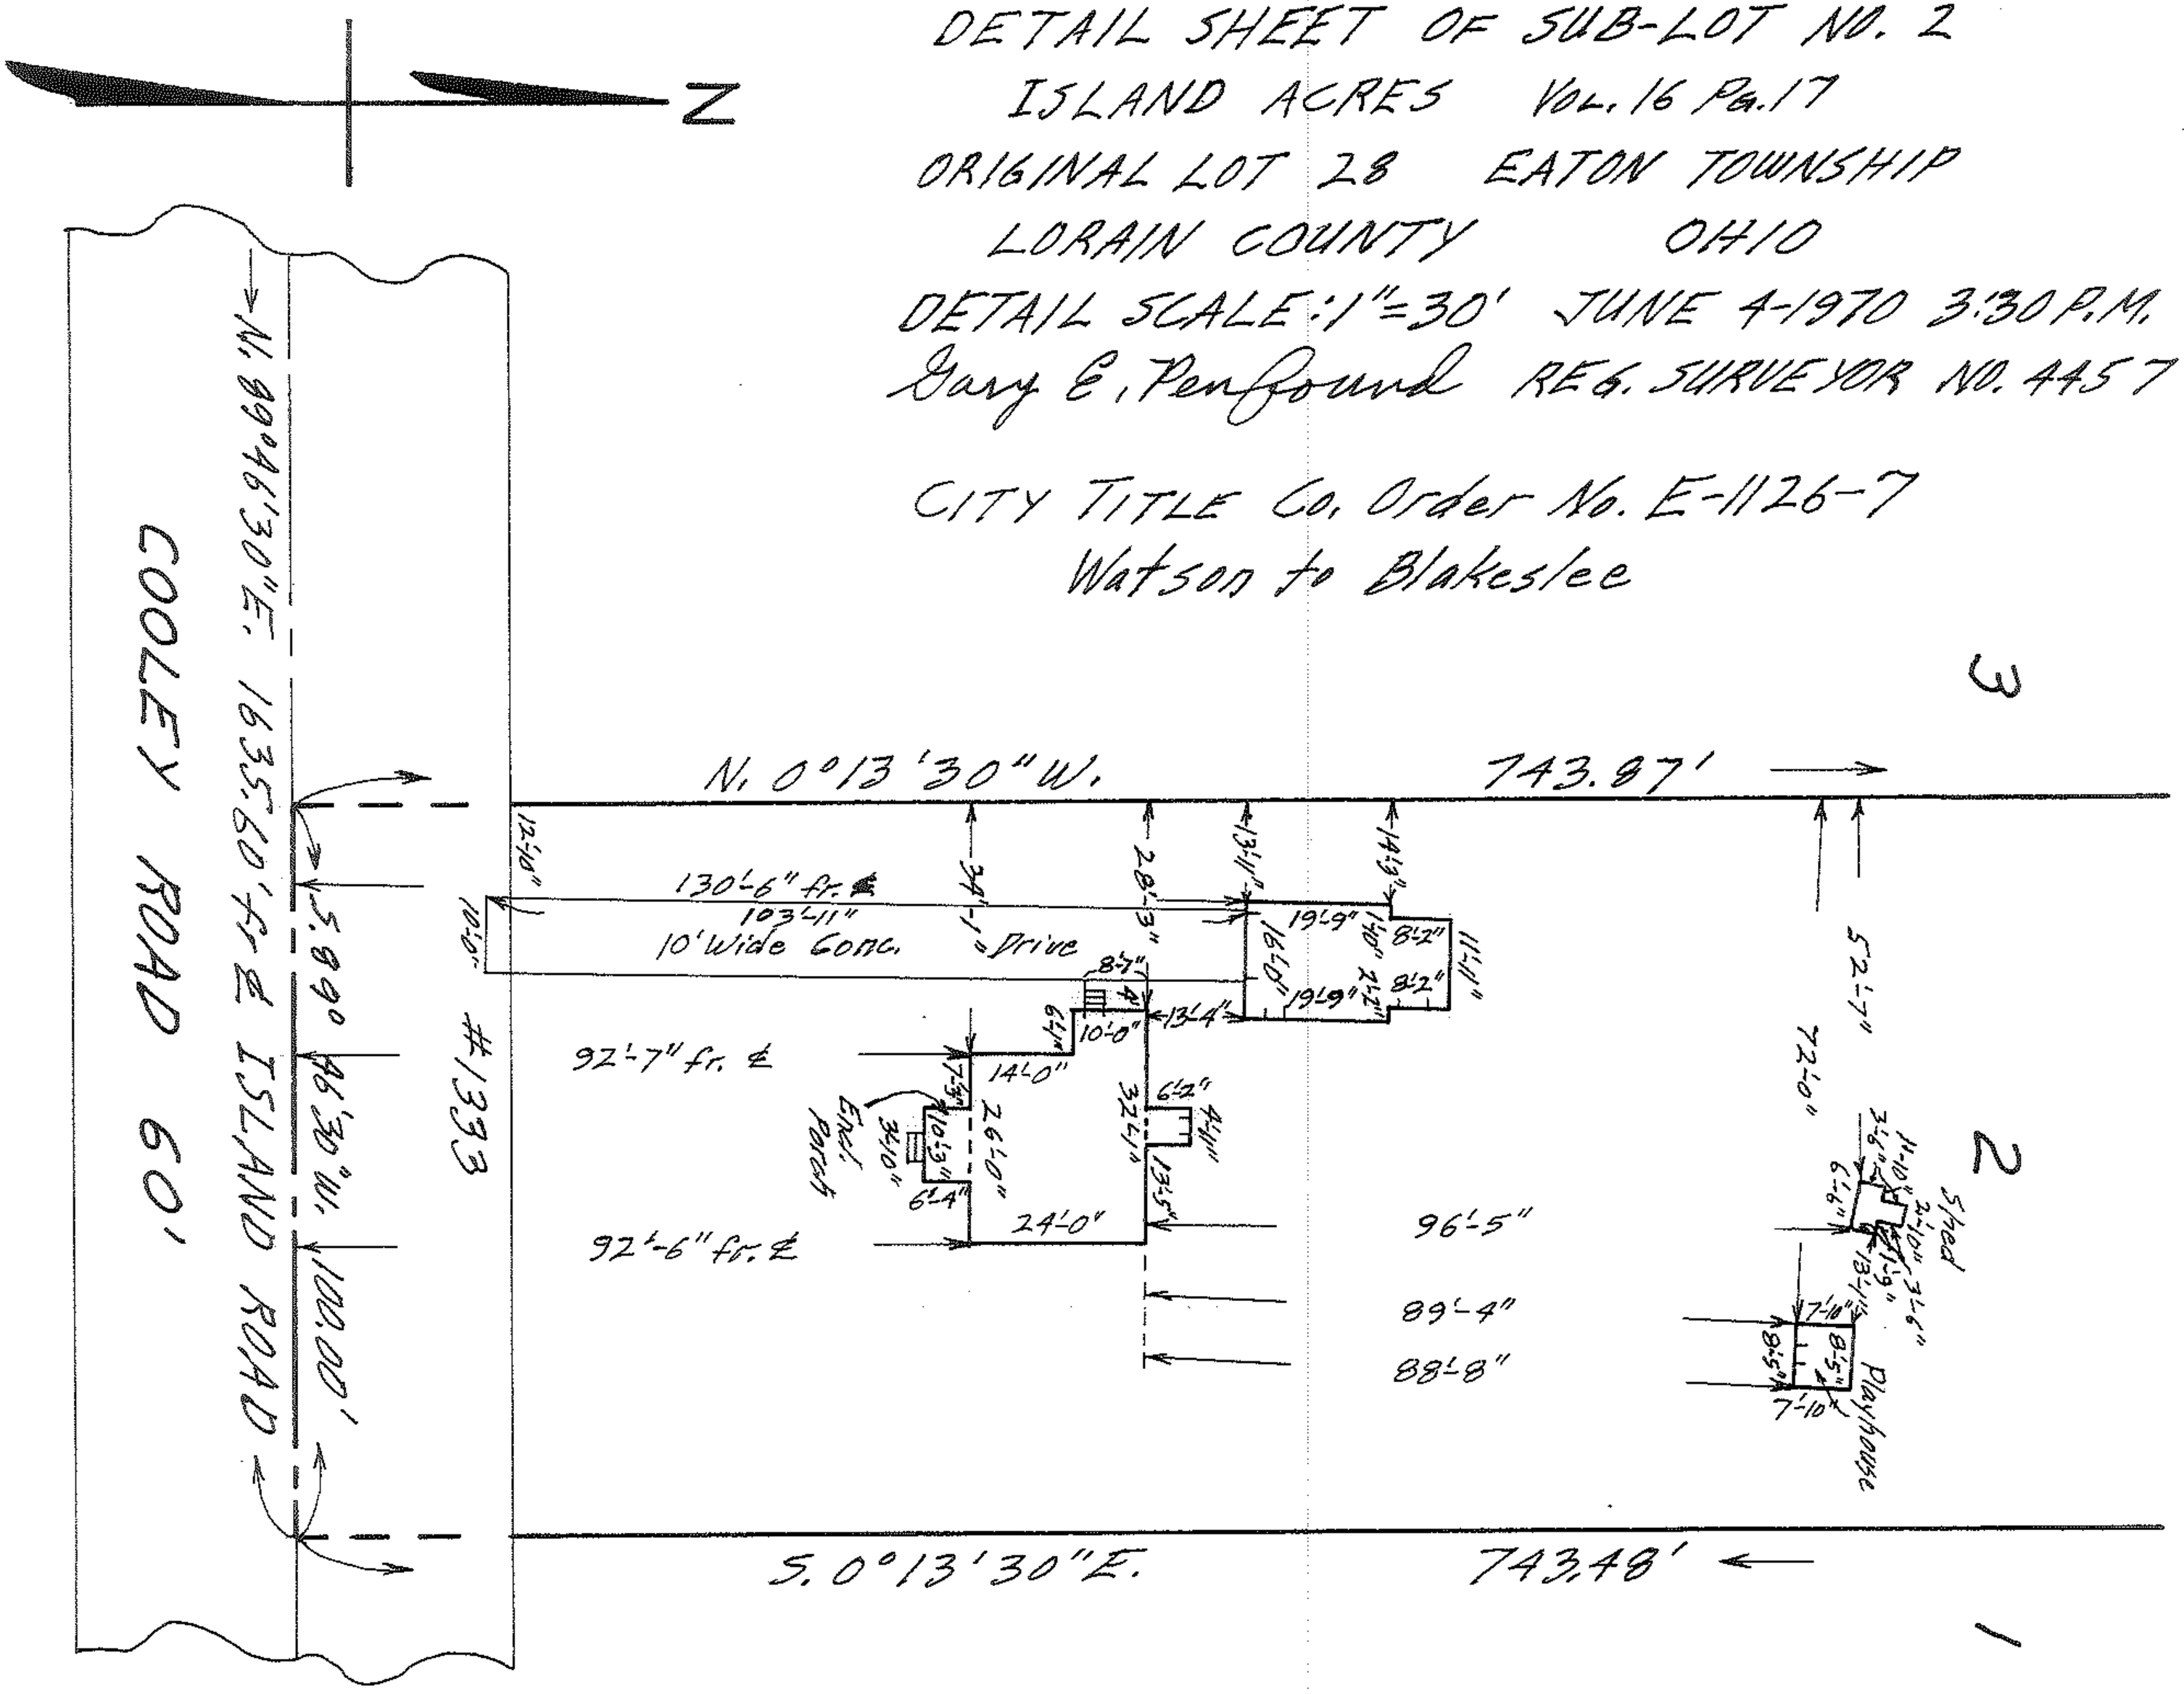
CITY TITLE Co. Order No. E-1126-7
Watson to Blakeslee