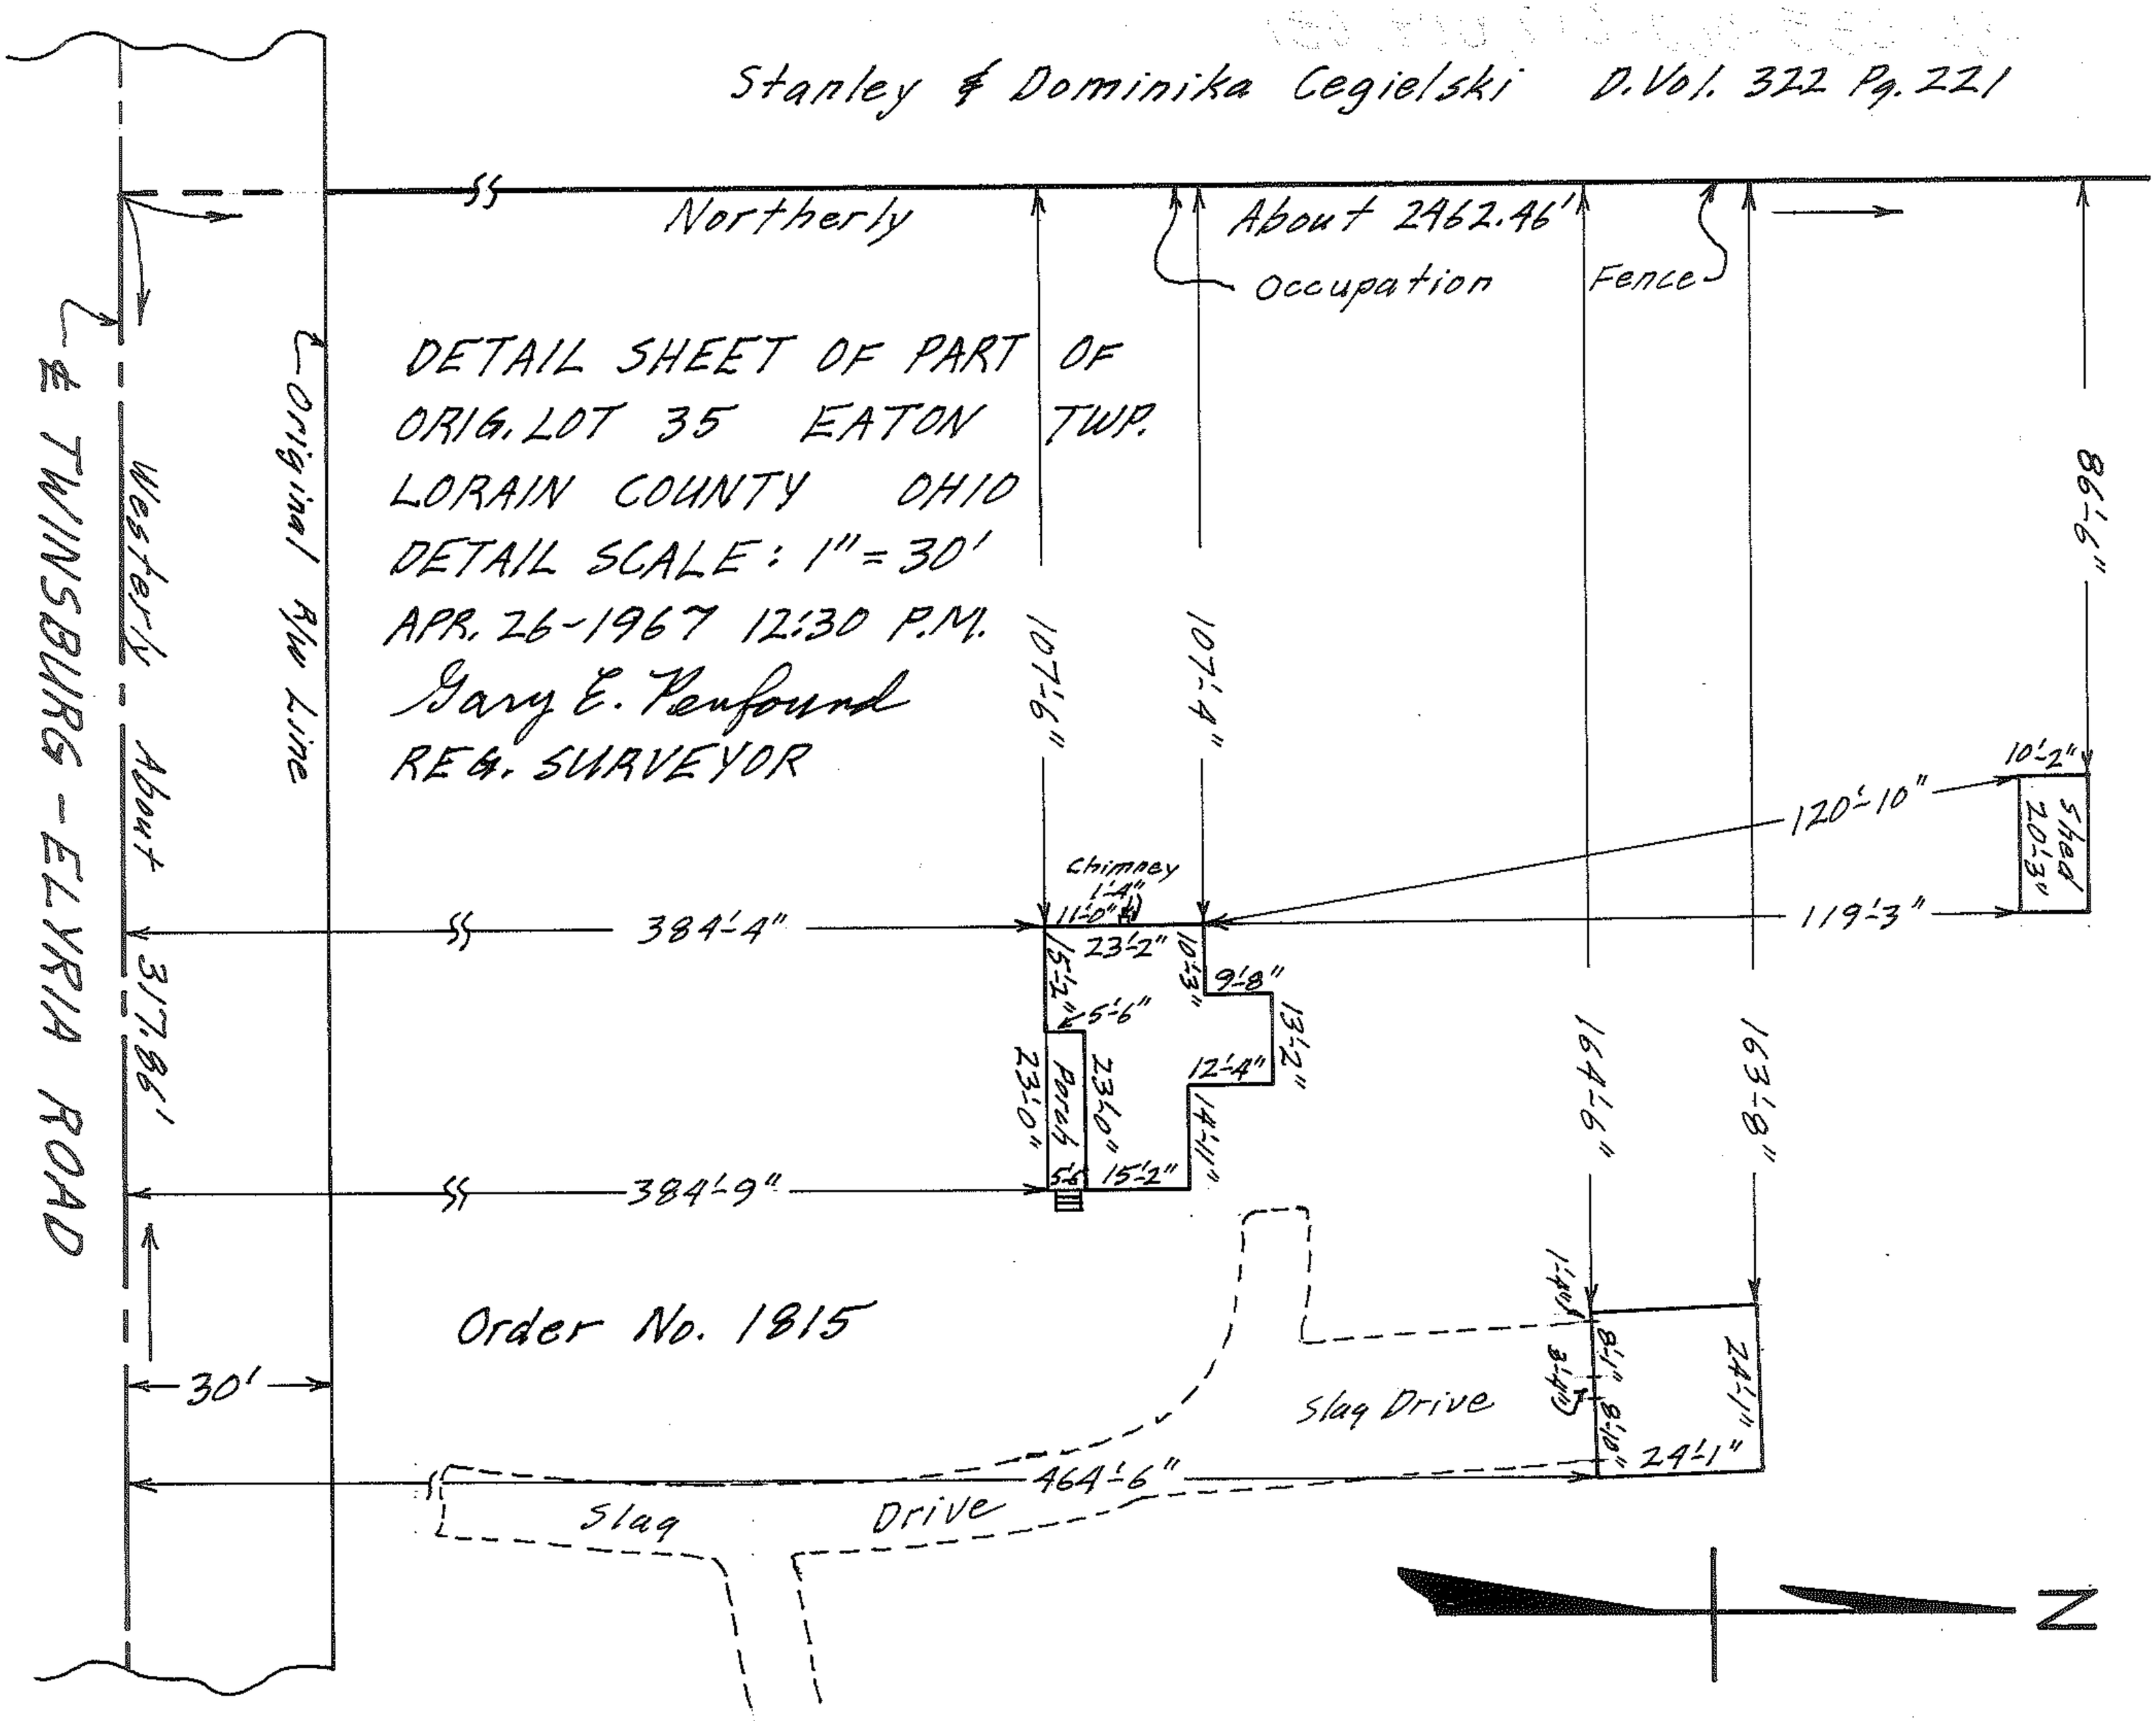
Stanley & Dominika Cegielski D.Vol. 322 Pg. 221
Northerly
About 2462.46'
Occupation
Fence
DETAIL SHEET OF PART OF
ORIG. LOT 35 EATON TWP.
LORAIN COUNTY OHIO
DETAIL SCALE: 1" = 30'
APR. 26-1967 12:30 P.M.
Gary E. Penfound
REG. SURVEYOR
Original R/W Line
Westerly About 317.86'
℄ TWINSBURG - ELYRIA ROAD
107'-6"
107'-4"
86'-6"
120'-10"
119'-3"
10'-2"
Shed 20'-3"
Chimney 1'-4"
11'-0"
384'-4"
23'-2"
15'-2"
5'-6"
10'-3"
9'-8"
13'-2"
12'-4"
14'-11"
23'-0"
Porch
23'-0"
5'-6"
15'-2"
384'-9"
164'-6"
163'-8"
Order No. 1815
30'
Slag Drive
1'-4"
3'-4"
8'-1"
8'-10"
24'-1"
24'-1"
464'-6"
Slag Drive
N