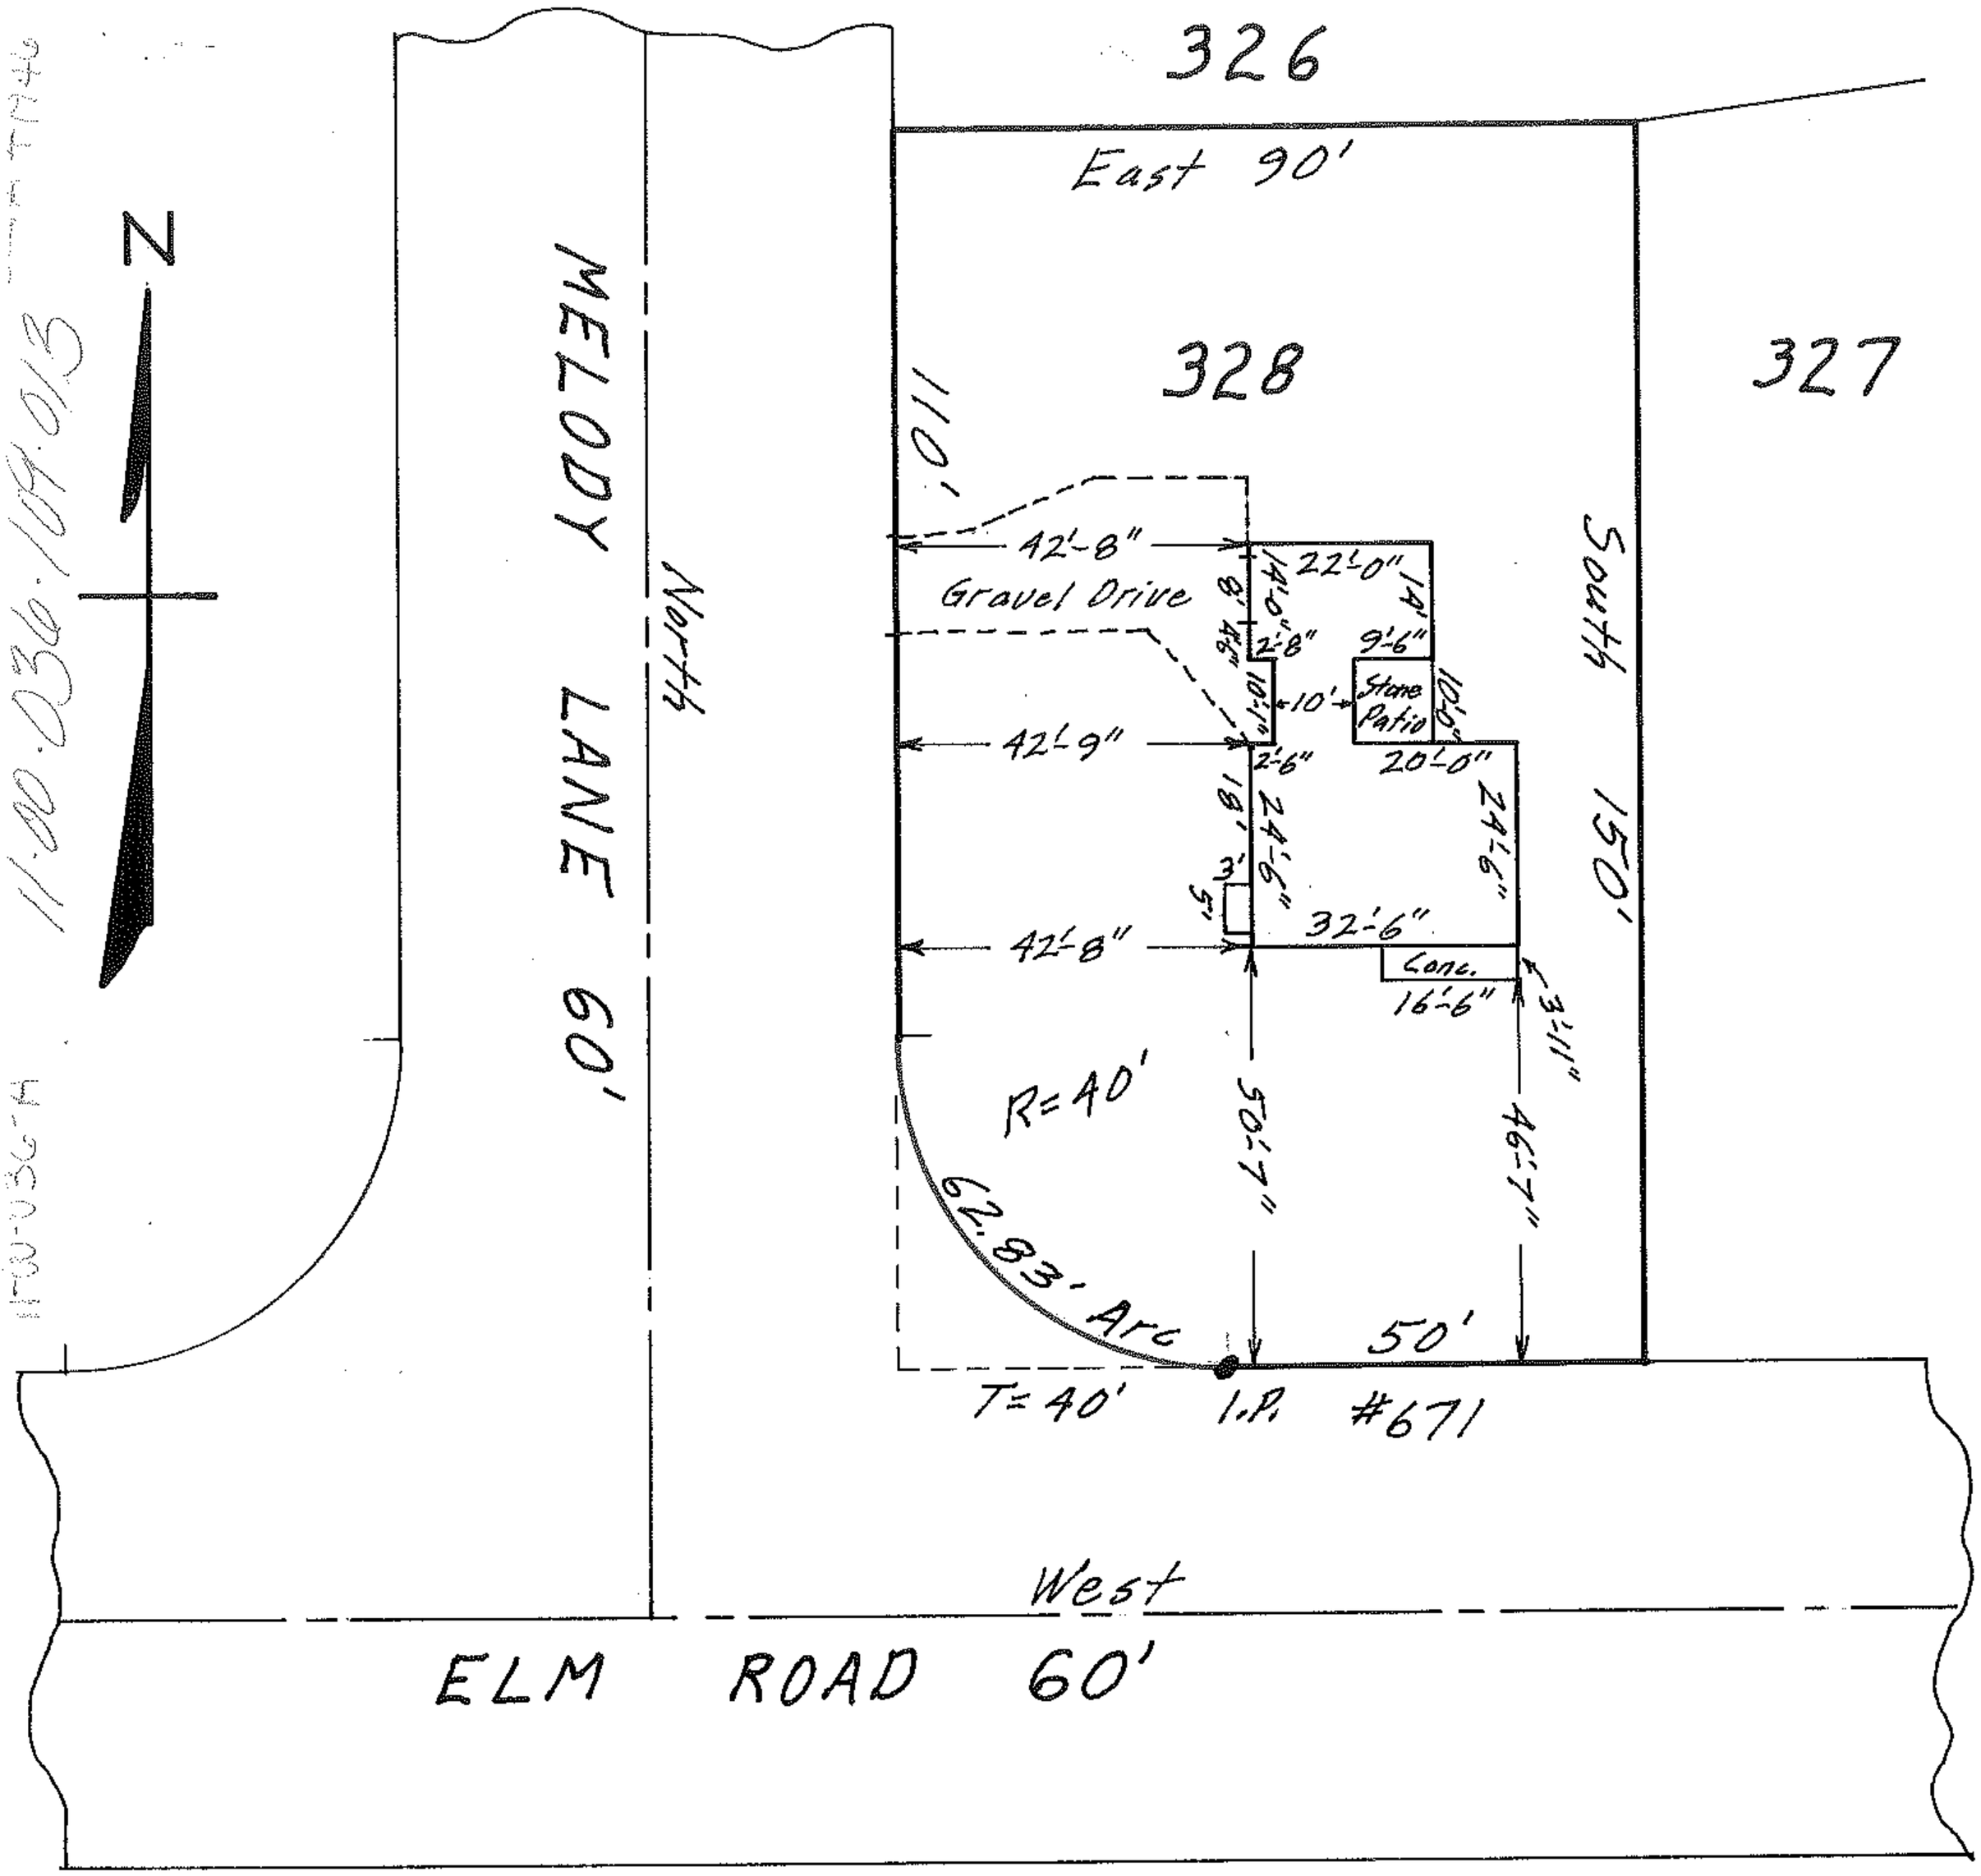

MAP OF SUB-LOT NO. 328

EATON HOMES SUB'N. Vol. 17 Pg. 38

ORIG. LOT NO. 36 EATON TOWNSHIP

LORAIN COUNTY OHIO

SCALE: 1"=30' MAY 20-1966 8:00 P.M.

Gary E. Penfound
for C. E. Penfound REG. SURVEYORS

E-14510 Bazil & Valerie Wallace