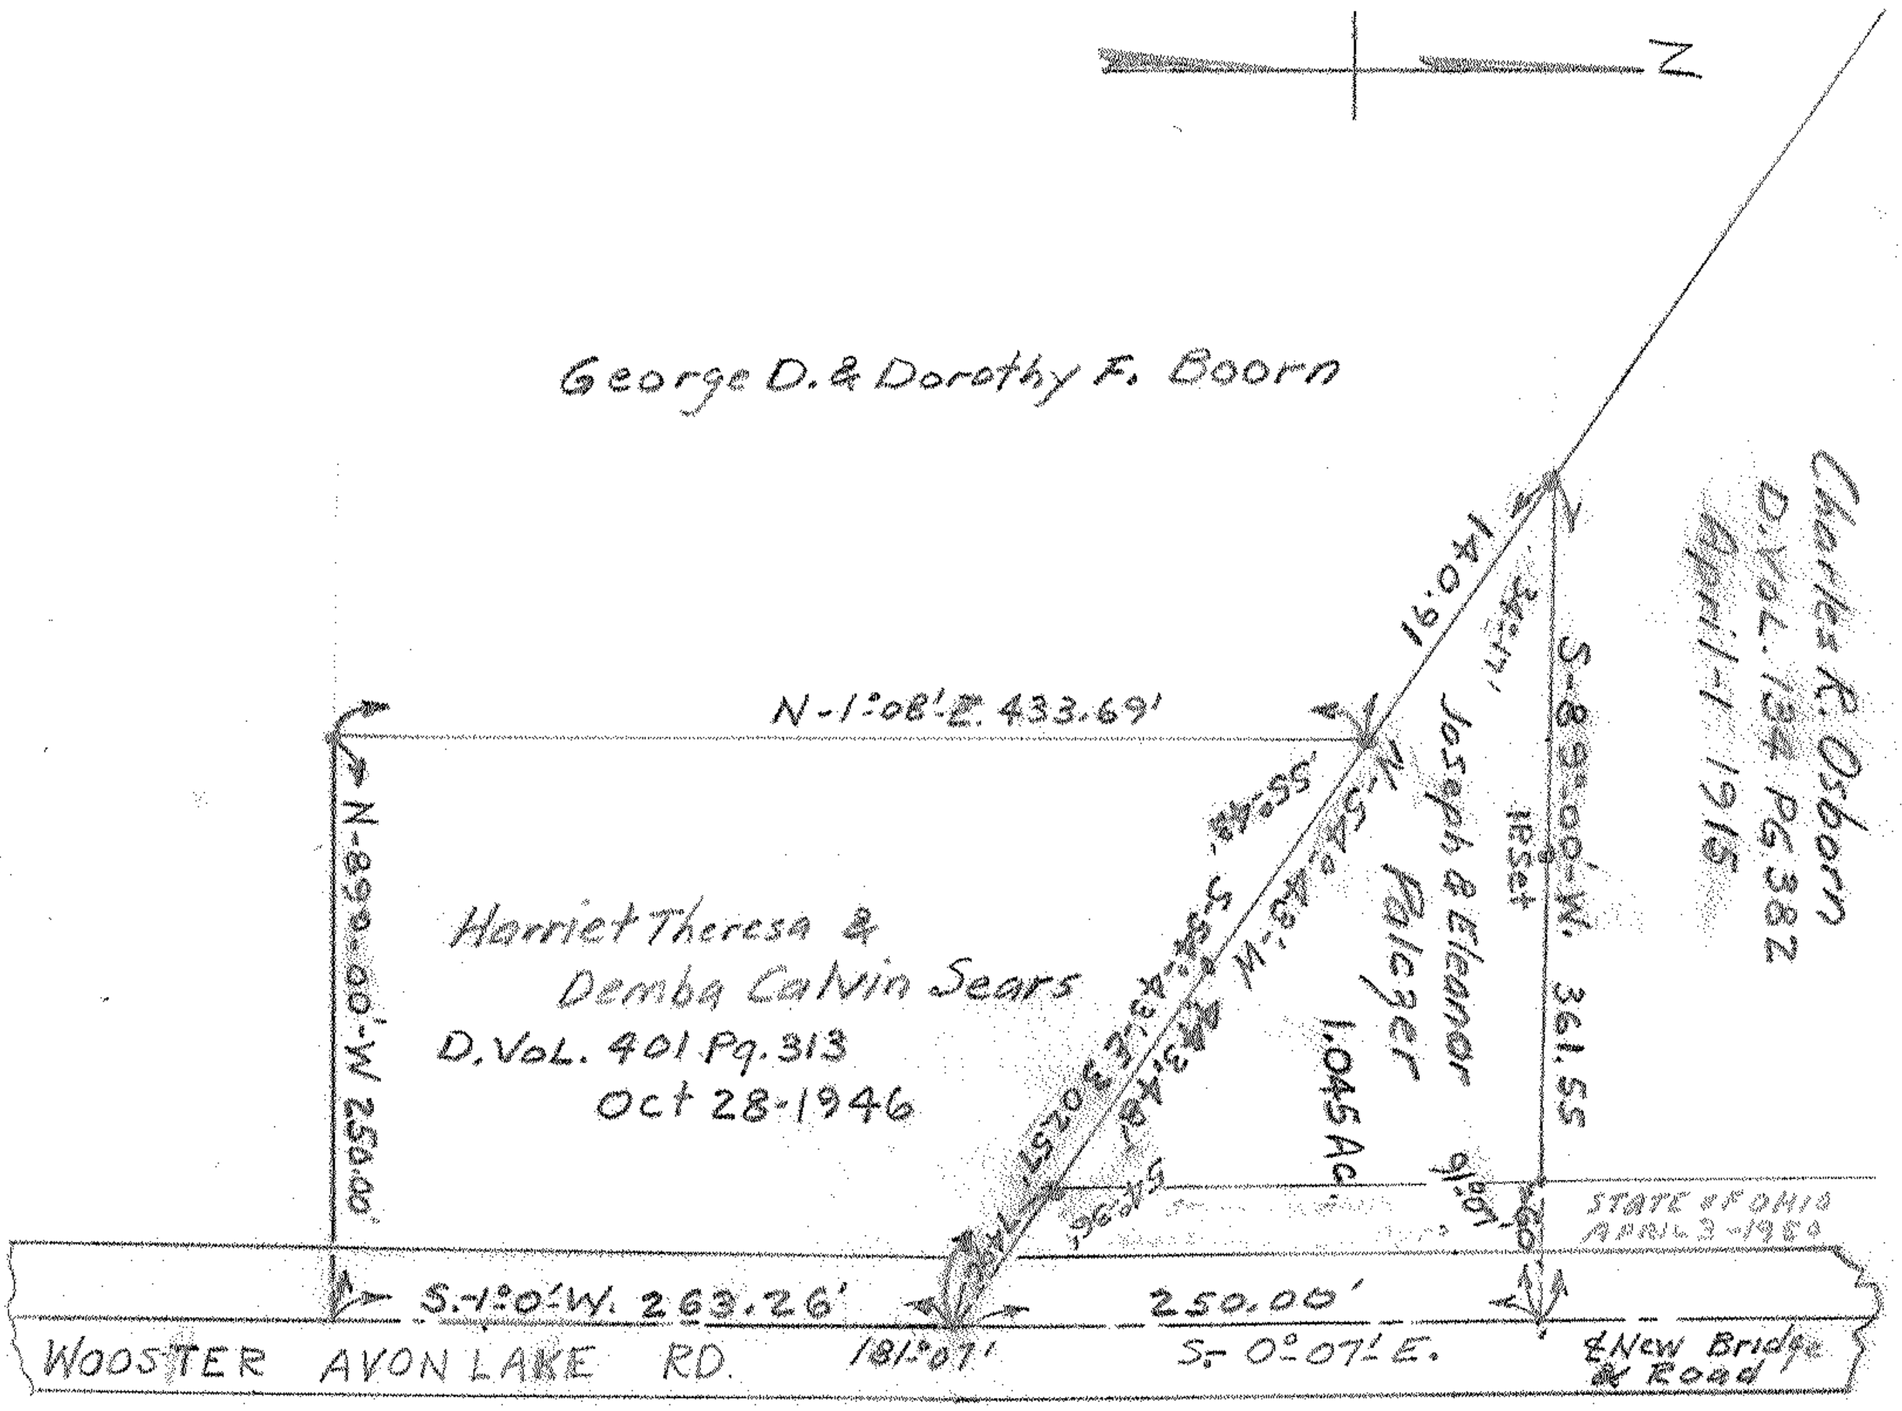

MAP OF SURVEY FOR
Joseph & Eleanor Palczer
O.L. 51 EATON TOWNSHIP
LORAIN COUNTY OHIO
Scale 1" = 100 FT. JULY 28-1951
C. E. Penfound Registered Surveyor.

11-00-051-000-013, 14
Scan # 4703