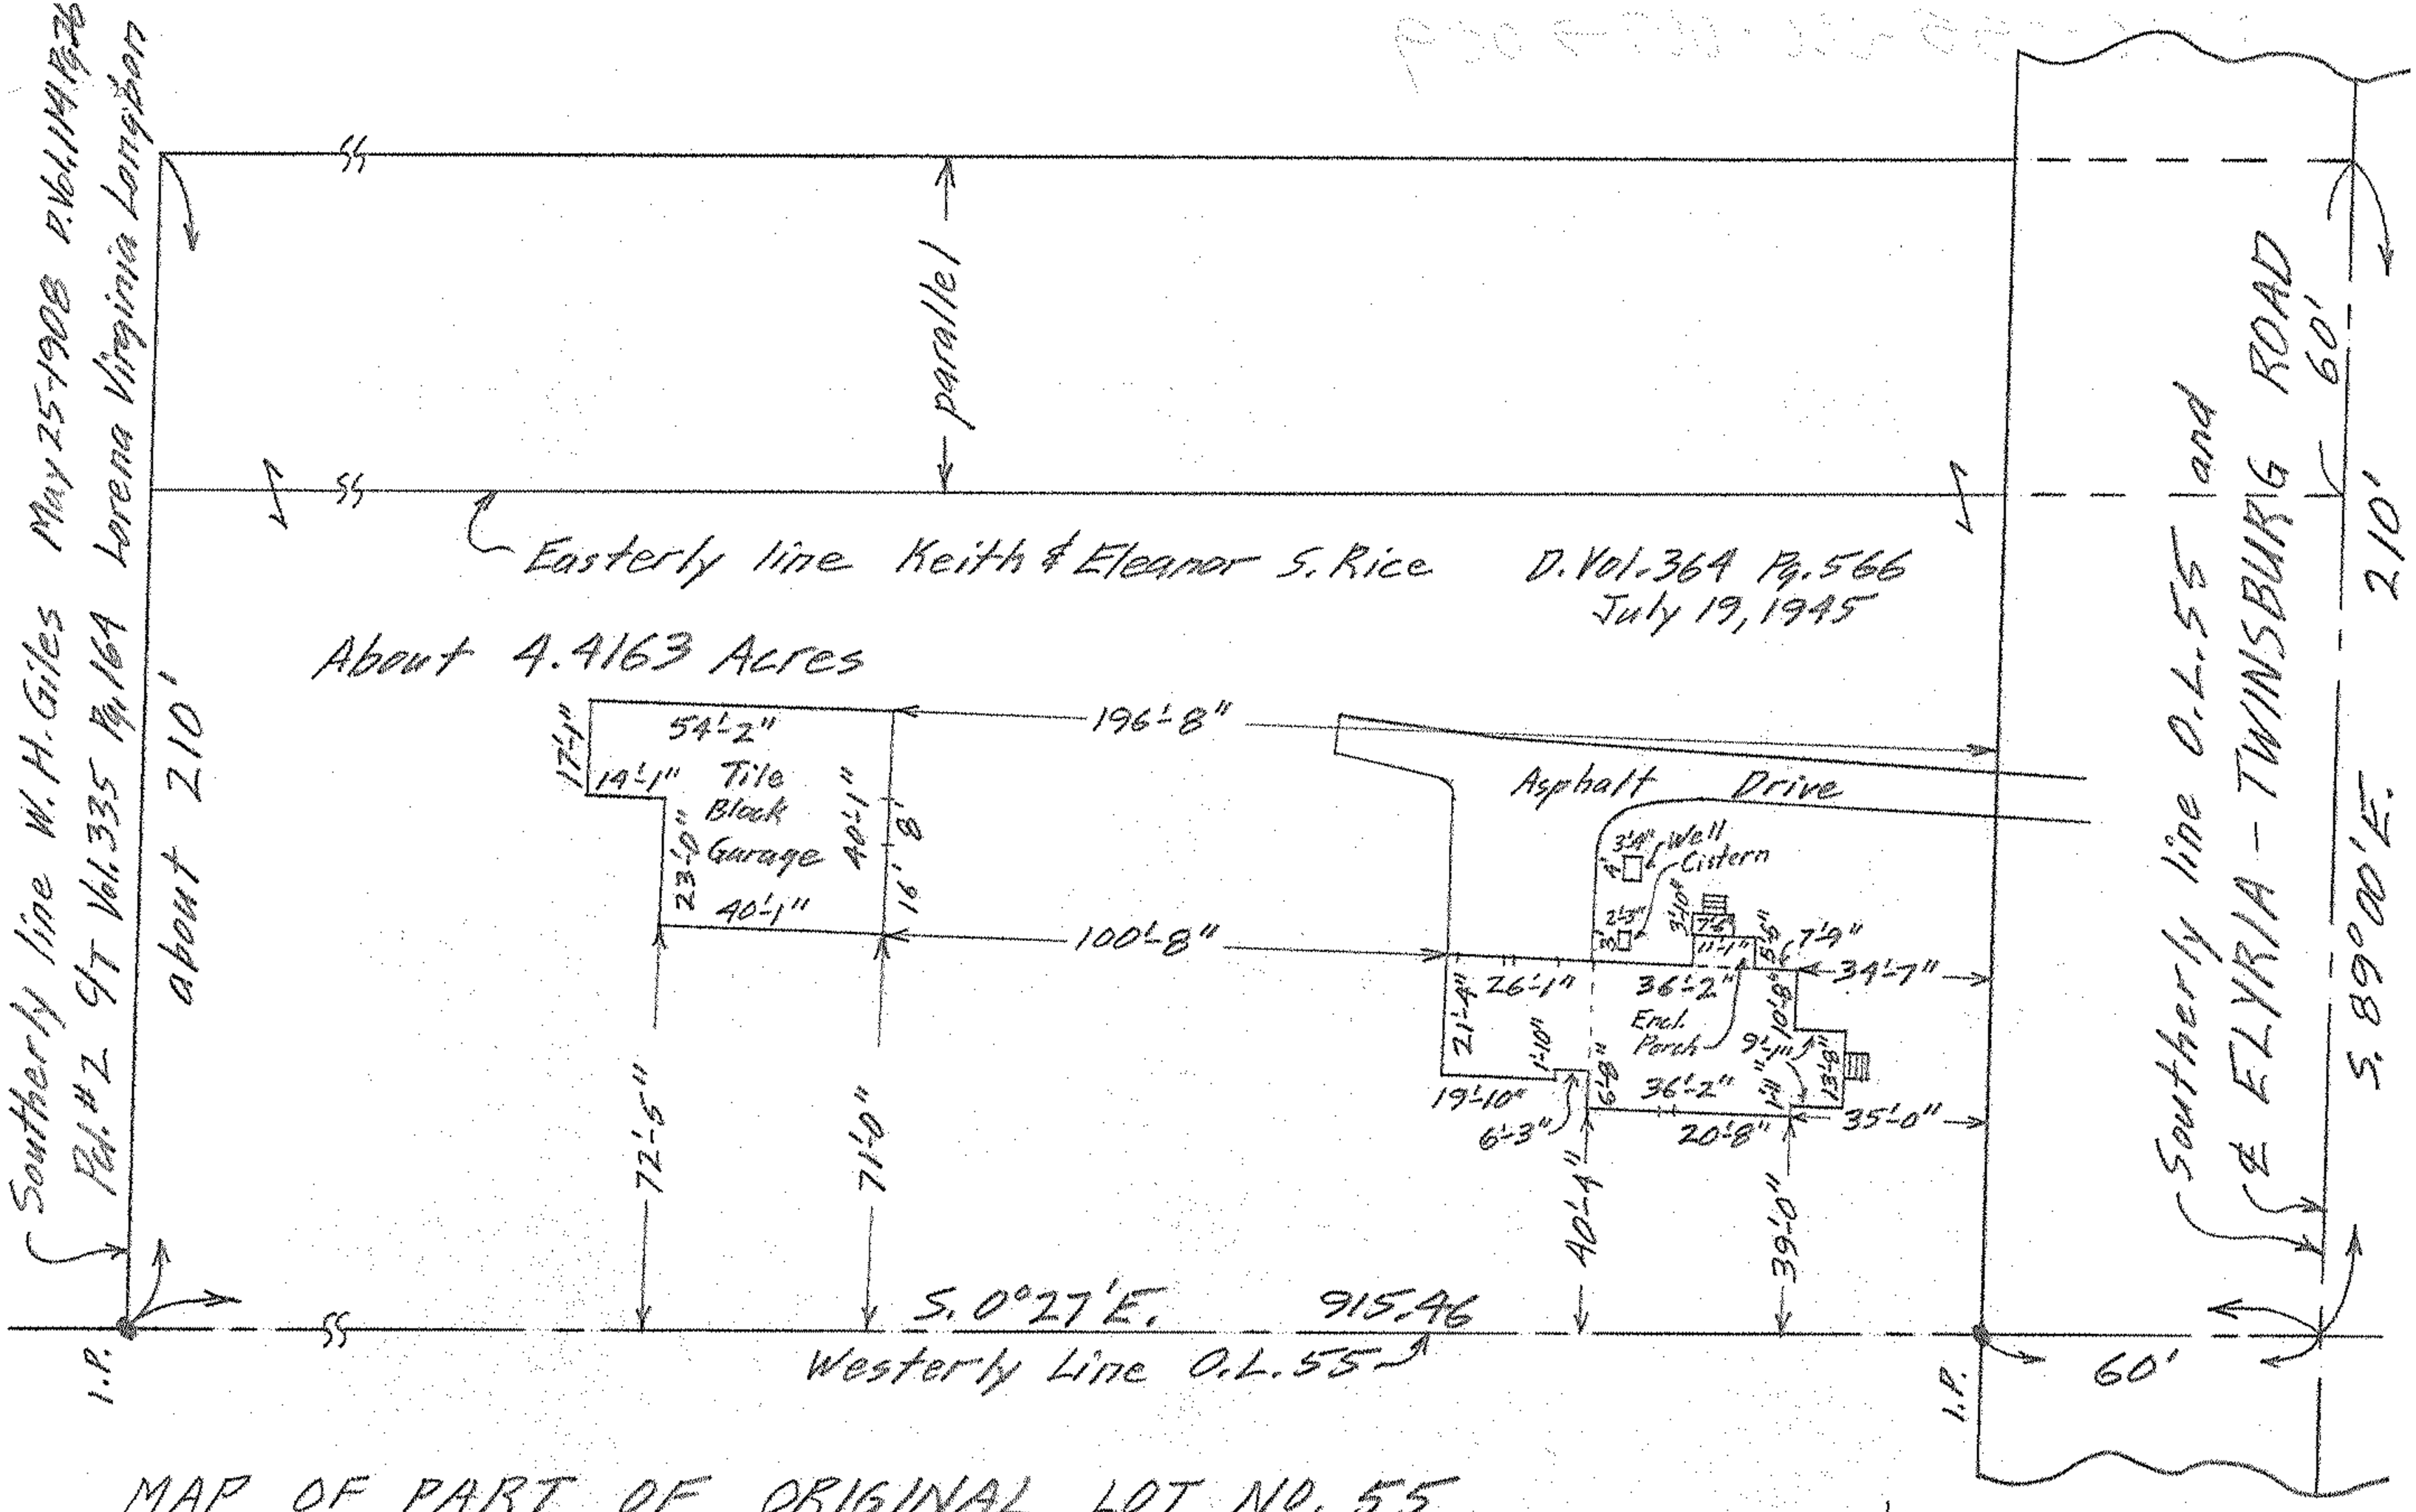


MAP OF PART OF ORIGINAL LOT NO. 55
EATON TWP. — LORAIN COUNTY — OHIO
SCALE: 1"=40' MAR. 28-1964 5:30 P.M.
Gary E. Perfound REG. SURVEYOR

BERKS TITLE INS. CO. Order No. 1324

Scan # 47956